


C:\DRAWING\SHARE\03455\01-LOT51\Endrv.dwg Wed Jun 23 10:23:02 1999 H.Gunn

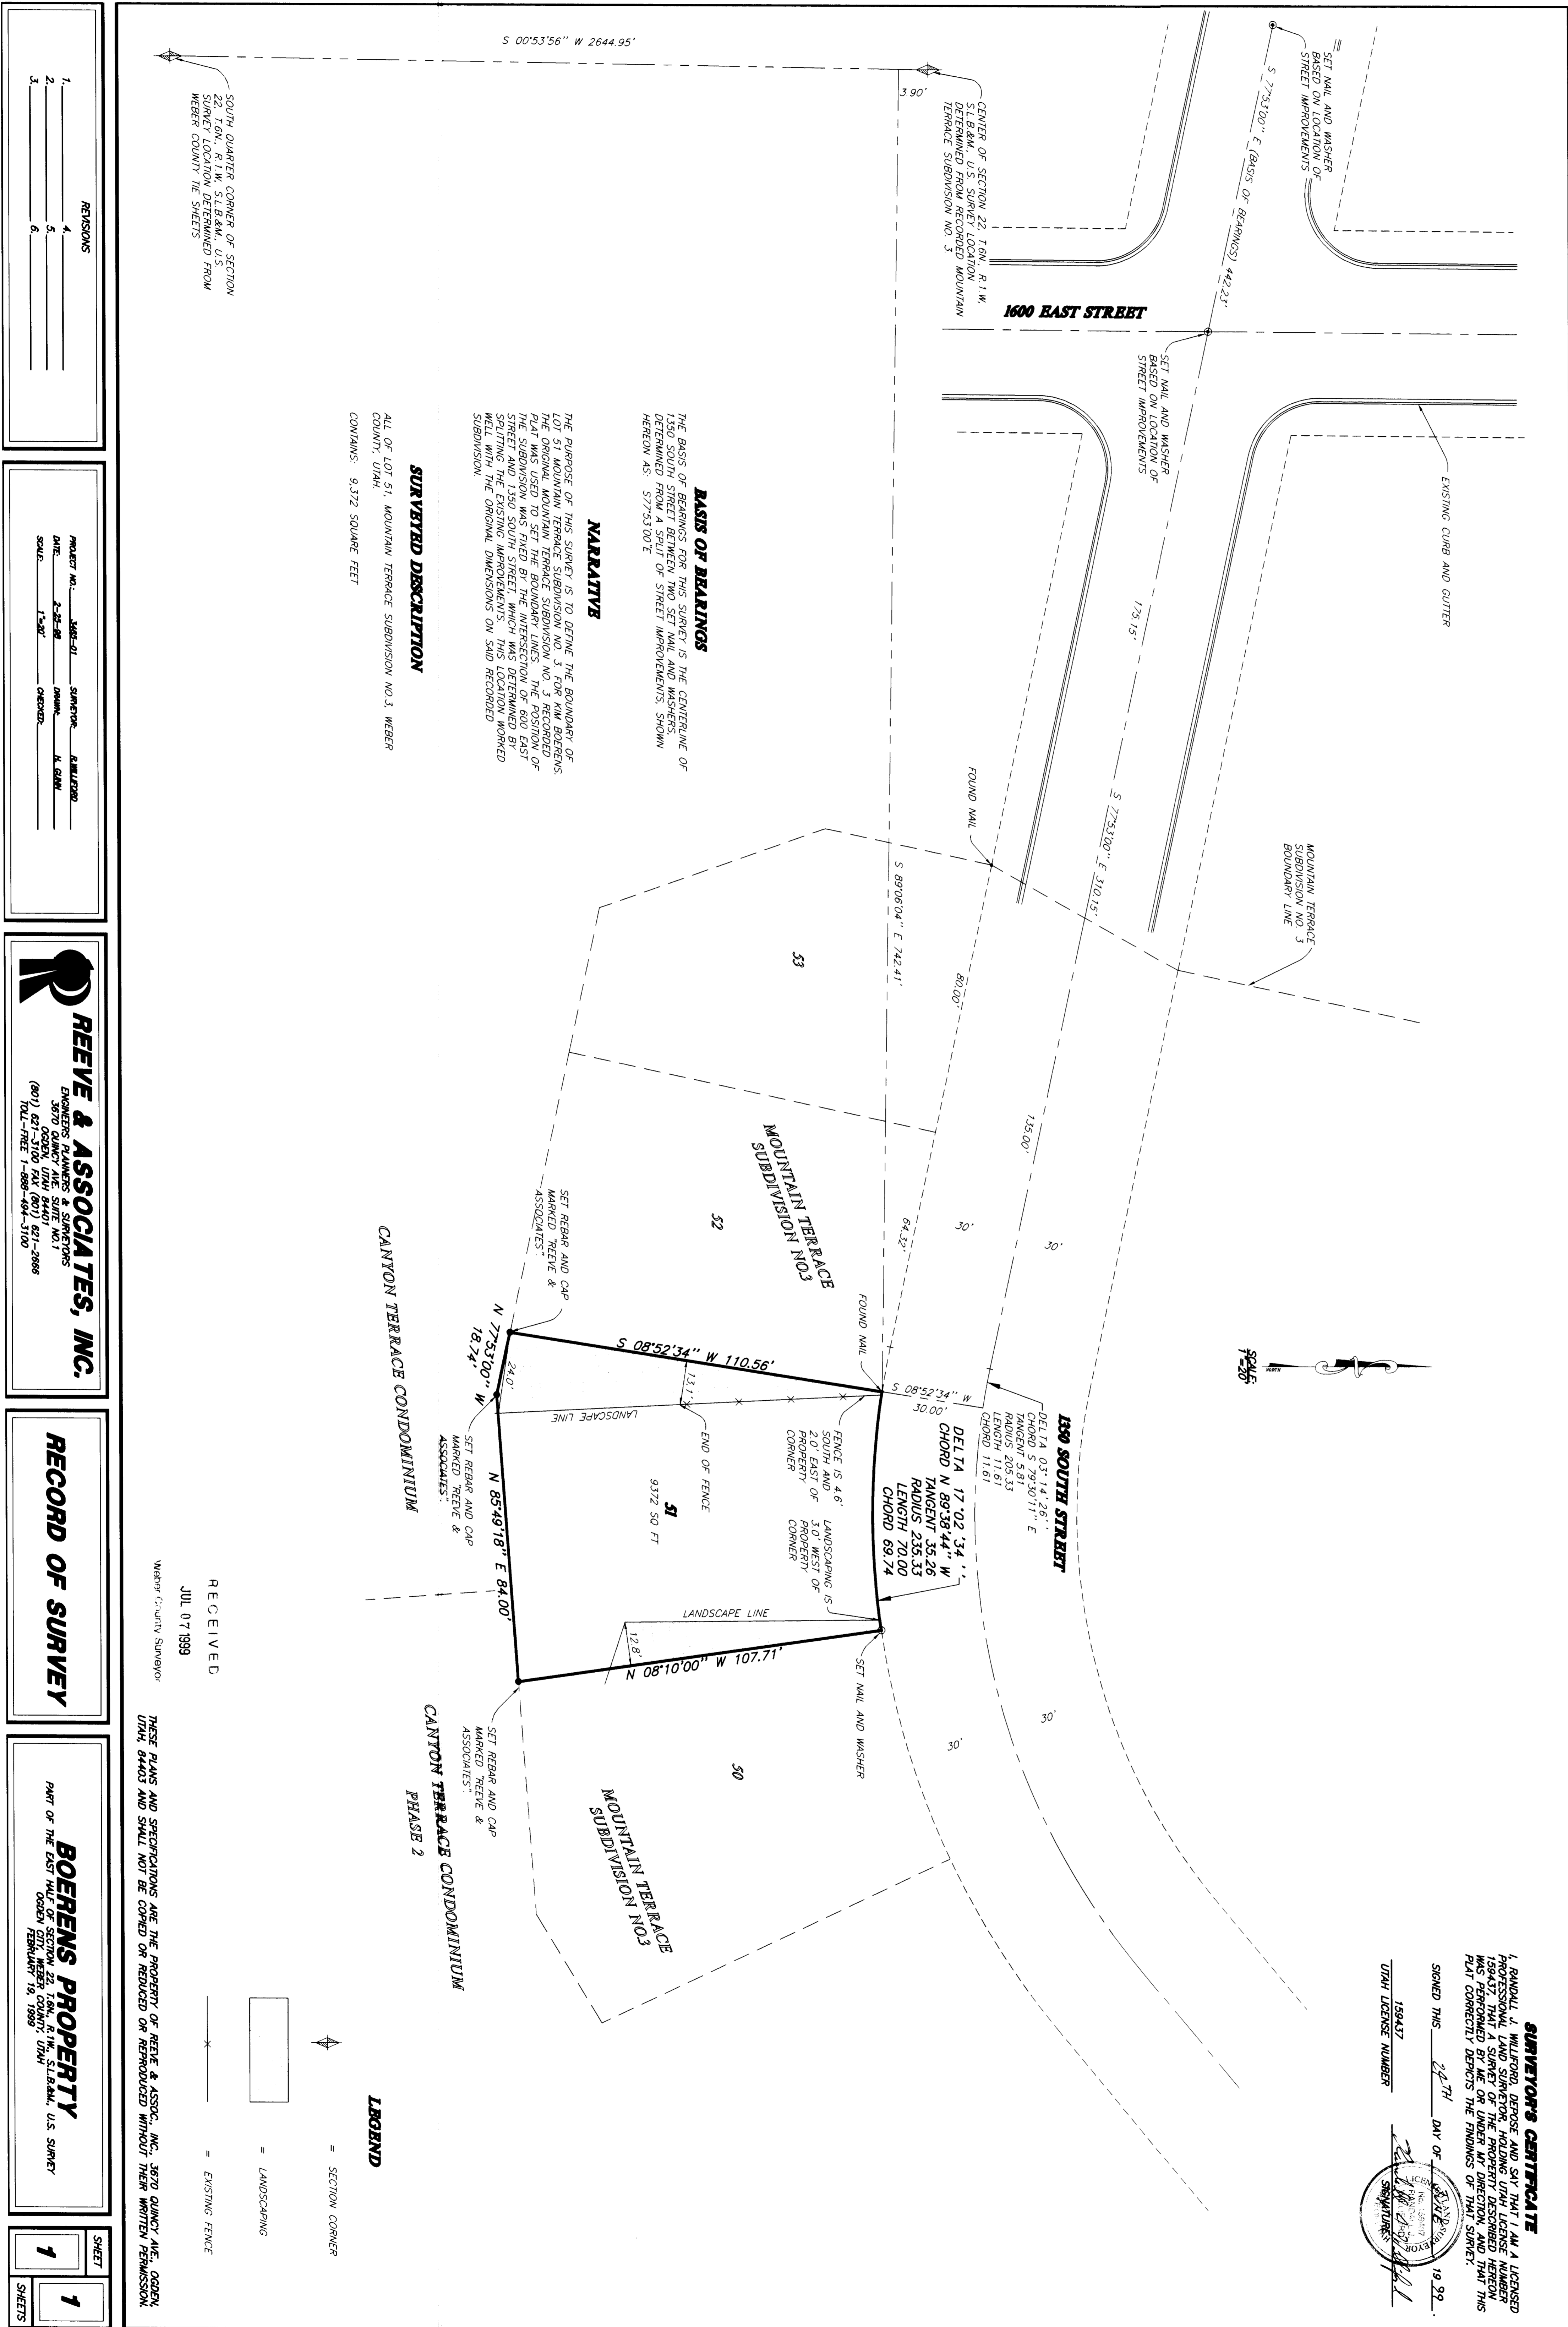

SOUTH QUARTER CORNER OF SECTION 22, T.6N., R.1W., S.L.B.M., U.S. SURVEY LOCATION DETERMINED FROM WEBER COUNTY THE SHEETS

CENTER OF SECTION 22, T.6N., R.1W., S.L.B.M., U.S. SURVEY LOCATION DETERMINED FROM RECORDED MOUNTAIN TERRACE SUBDIVISION NO. 3

SET NAIL AND WASHER BASED ON LOCATION OF STREET IMPROVEMENTS

SET NAIL AND WASHER BASED ON LOCATION OF STREET IMPROVEMENTS

MOUNTAIN TERRACE SUBDIVISION NO. 3 BOUNDARY LINE

EXISTING CURB AND GUTTER

FOUND NAIL

FOUND NAIL

FOUND NAIL


FOUND NAIL

SET NAIL AND WASHER

BASIS OF BEARINGS
THE BASIS OF BEARINGS FOR THIS SURVEY IS THE CENTERLINE OF 1750' SOUTH STREET BETWEEN TWO SET NAIL AND WASHERS DETERMINED FROM A SPALT OF STREET IMPROVEMENTS, SHOWN HEREON AS: S77°53'00"E

NARRATIVE


SURVEYED DESCRIPTION
ALL OF LOT 51, MOUNTAIN TERRACE SUBDIVISION NO. 3, WEBER COUNTY, UTAH.
CONTAINS: 9,372 SQUARE FEET

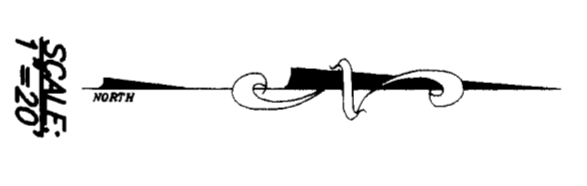

SURVEYOR'S CERTIFICATE
RANDALL J. WILFORD
SURVEYOR

RECEIVED
JUL 07 1999
WEBER COUNTY SURVEY

THESE PLANS AND SPECIFICATIONS ARE THE PROPERTY OF REEVE & ASSOC., INC., 3670 QUINCY AVE., OGDEN, UTAH 84403 AND SHALL NOT BE COPIED OR REPRODUCED OR REPRODUCED WITHOUT THEIR WRITTEN PERMISSION.

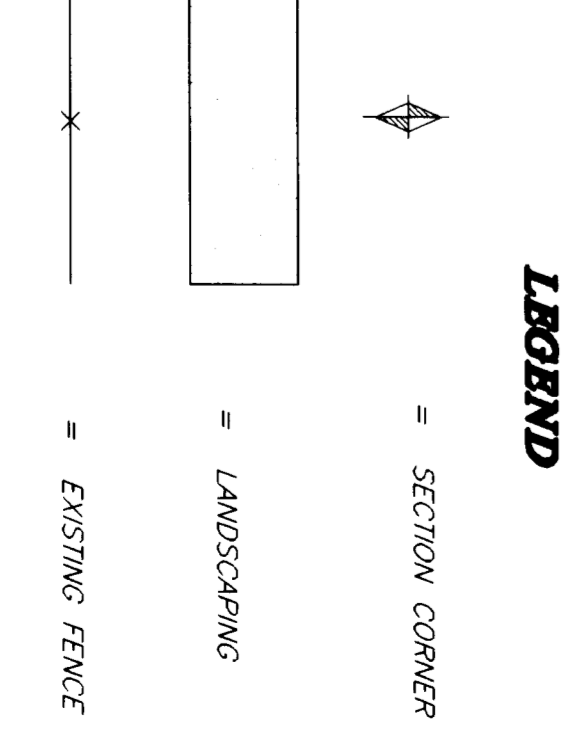

REVISIONS

1.					
2.					
3.					
4.					
5.					
6.					



REEVE & ASSOCIATES, INC.
ENGINEERS PLANNERS & SURVEYORS
3670 QUINCY AVE. SUITE 101
OGDEN, UTAH 84403
(801) 627-3100 FAX (801) 621-2866
TOLL-FREE 1-888-484-3100

RECORD OF SURVEY

BOEHRNS PROPERTY
PART OF THE EAST HALF OF SECTION 22, T.6N., R.1W., S.L.B.M., U.S. SURVEY
OGDEN, UTAH

SHEET 1 OF 1 SHEETS