


C:\DRAWINGS\SHARE\13434\01-LOT31\Endrv.dwg Wed Jun 23 10:24:11 1999 H.Gunn

002271

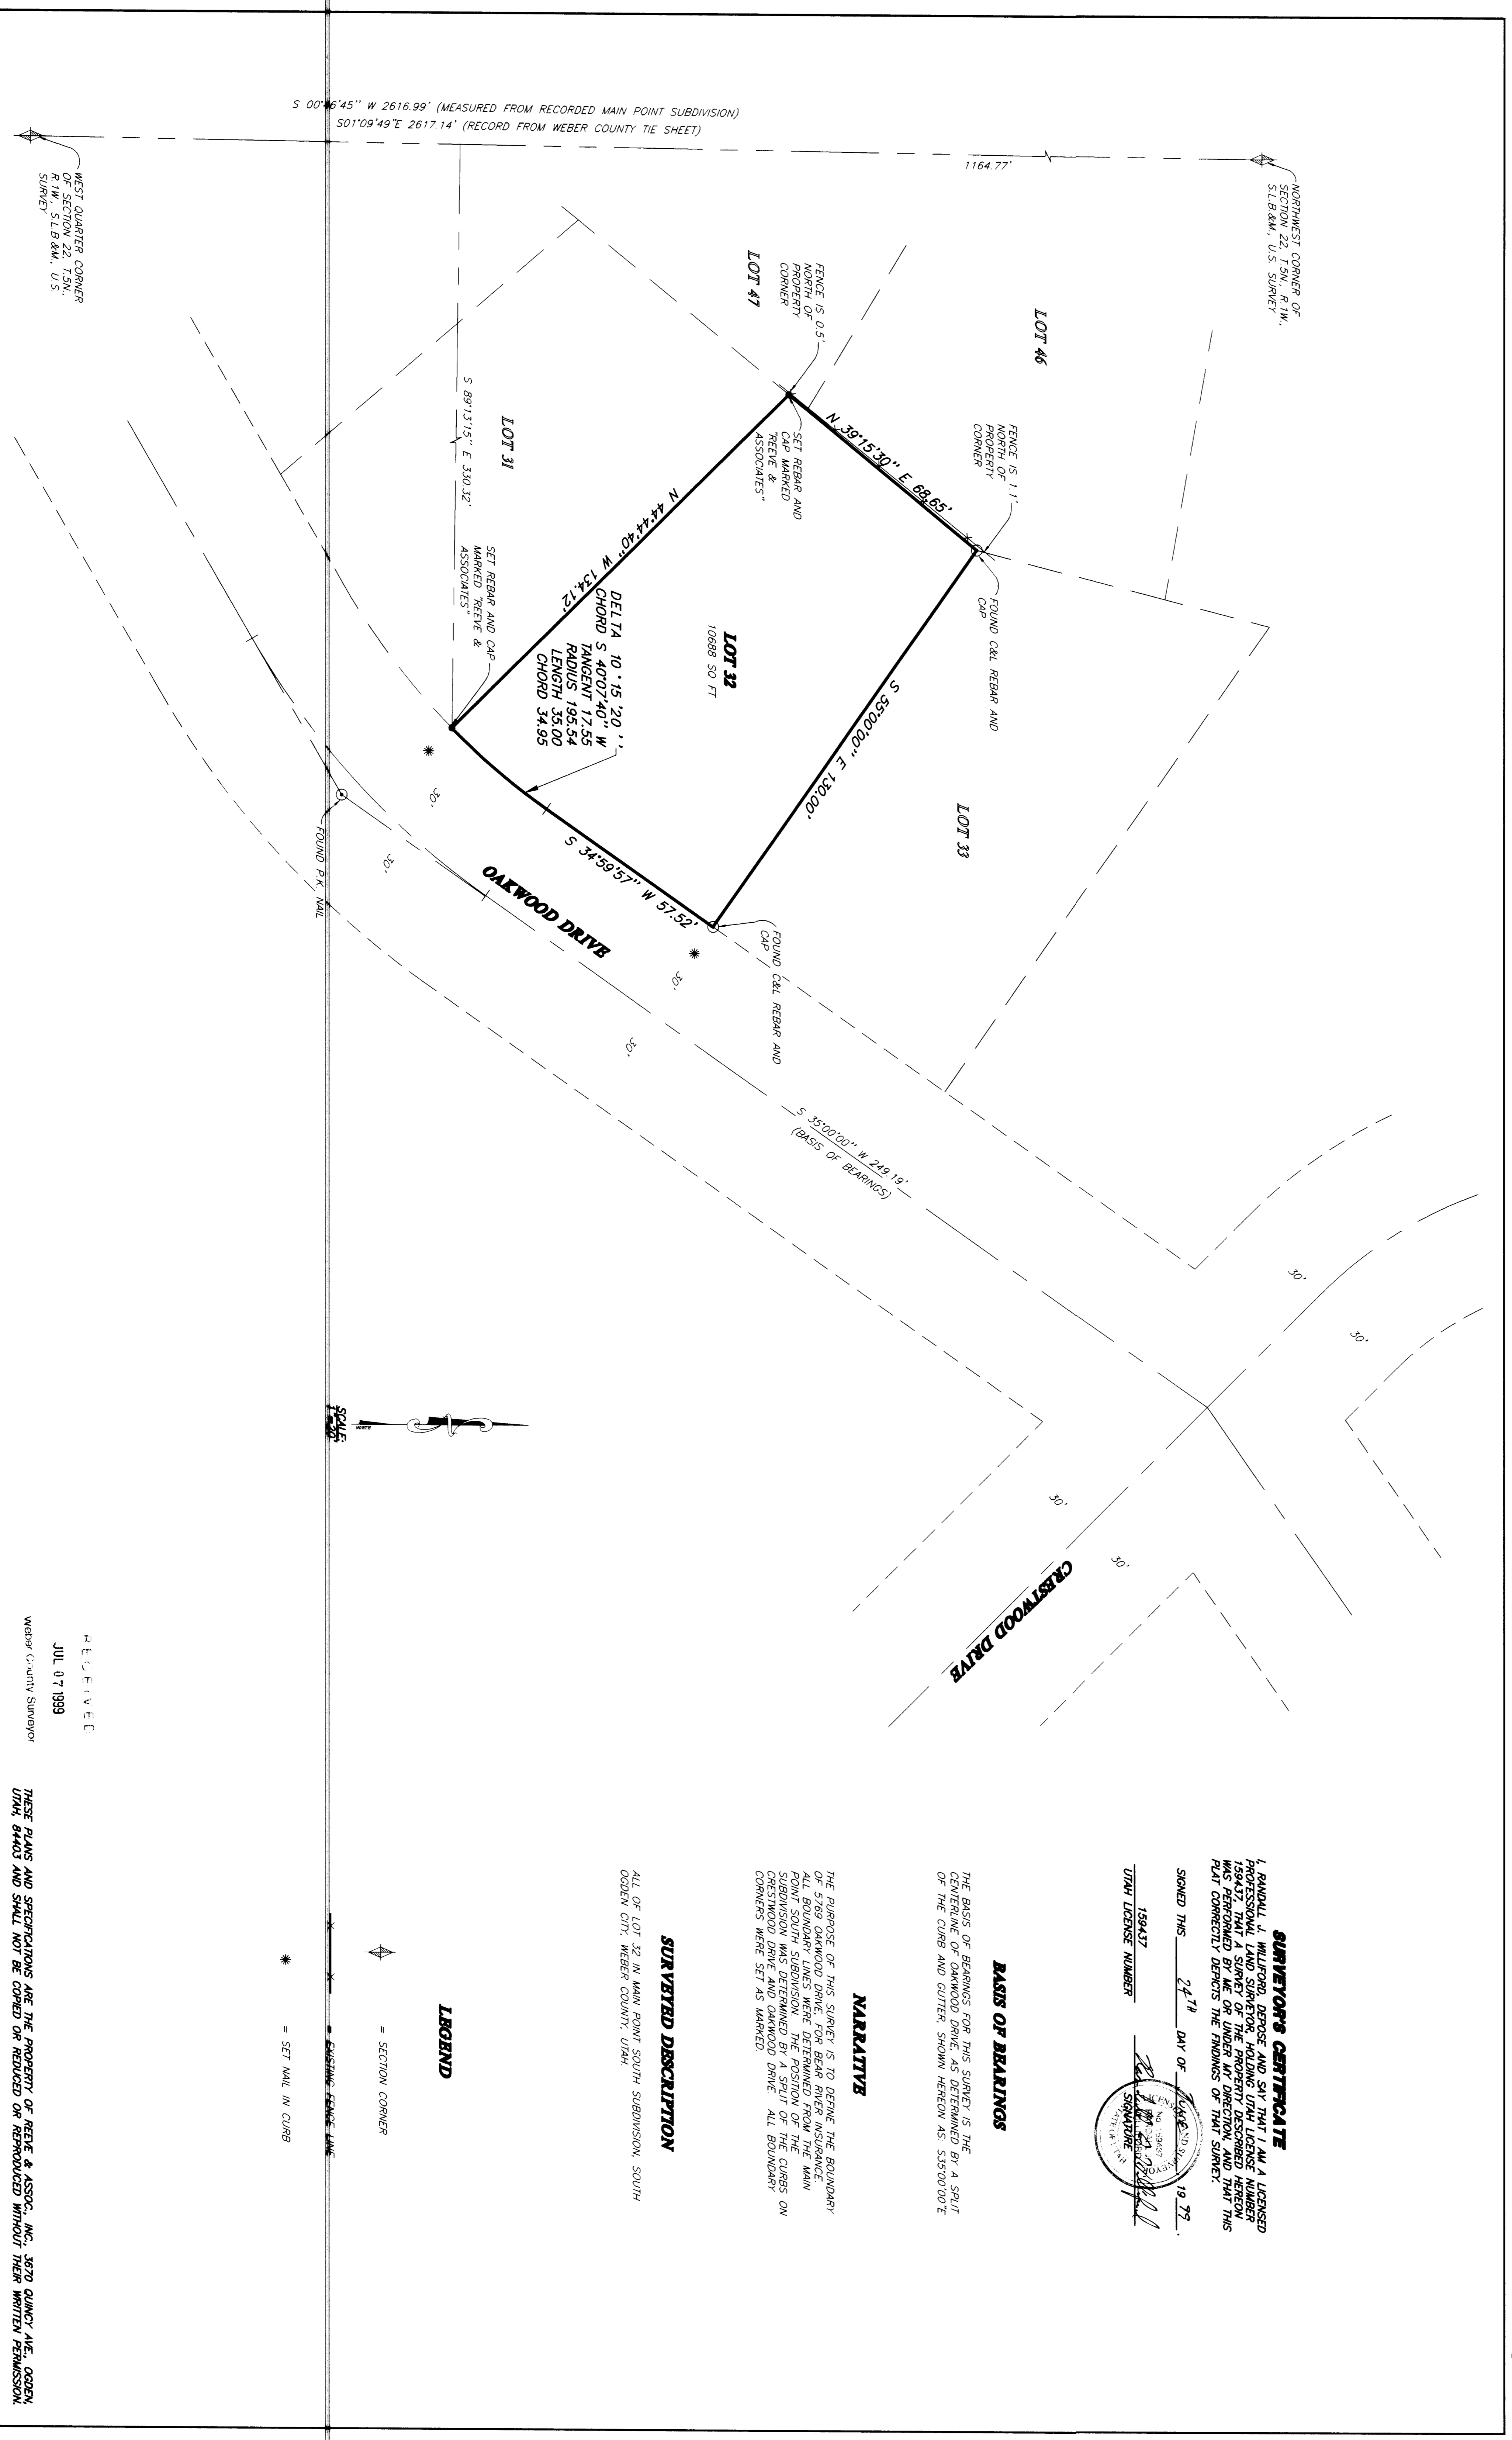

SURVEYOR'S CERTIFICATE
SURVEYOR

BASES OF BEARINGS
THE BASES OF BEARINGS FOR THIS SURVEY IS THE CENTERLINE OF OAKWOOD DRIVE, DETERMINED BY A SPLIT OF THE CURB AND GUTTER, SHOWN HEREON AS S35°00'00"E

NARRATIVE

SURVEYED DESCRIPTION
ALL OF LOT 32 IN MAIN POINT SOUTH SUBDIVISION, SOUTH OGDEN CITY, WEBER COUNTY, UTAH.

LEGEND

- ◆ = SECTION CORNER
- ◆ = SET MAIL IN CURB

RECEIVED
JUL 07 1999
Weber County Surveyor


REEVE & ASSOCIATES, INC.
ENGINEERS PLANNERS & SURVEYORS
3820 QUINCY AVE. SUITE 101
OGDEN, UTAH 84403
(801) 621-3100 FAX (801) 621-5868
702-792-1-800-404-3100

RECORD OF SURVEY

FRED WILLIAMS PROPERTY
PART OF THE NORTHWEST QUARTER OF SECTION 22 T.3N. R.1W. S.L.B.4M. U.S. SURVEY
LOT 32, MAIN POINT SOUTH SUBDIVISION, OGDEN CITY, WEBER COUNTY, UTAH

REGIONS

1	4
2	5
3	6

PROJECT NO. MA-01 SURVEYOR AMALDORO
DATE 3-2-99 DRAWN K. ZAM
SCALE 1" = 30' CHECKED _____

SHEET 1
SHEETS 1

002271 002271