

Ronald J. Hogg & W.L. Mery

Eden D. Hogg & Margaret Fay Hogg

Kath S. Pearson & W.L. Rebecca S.

Don E. Swanson & Lois R. Swanson

Linda S. Frank

Contains 3.081 Acres

The Church of Jesus Christ of Latter-day Saints
The Church of Jesus Christ of Latter-day Saints property survey (July 1991), Found State Right-of-Way Monument, Stamped 1/4/99


The Church of Jesus Christ property survey, Found Great Basin Engineering Reborn, cap and 1991 monument, of July 1991

The Church of Jesus Christ of Latter-day Saints property survey (July 1991), Found State Right-of-Way Monument, Stamped 1/4/99

NOTE:
All rebars are 5/8" and 24" long.

MAPNOTE:
This survey was requested by Mr. Steven Brown in order to establish his property corners. Brass cap monuments were found at the Northwest corner and the North Quarter corner of Section 20. A line bearing North 89°47'30" East (not as shown on drawing) was taken from a previous survey done for the Church of Jesus Christ of Latter-day Saints, date 7/1/91. The alignment along 3300 East Street was also established survey. Property corners were monumented as depicted on this drawing.

CERTIFICATION
I, Mark E. Babbit, do hereby certify that I am a Registered Professional Land Surveyor, and that I hold Certificate No. 168484, as prescribed by the Laws of the State of Utah, and that I have personally examined the plat and certify that the plat correctly shows the true dimensions of the property surveyed.
Date: 7-14-99
Mark E. Babbit

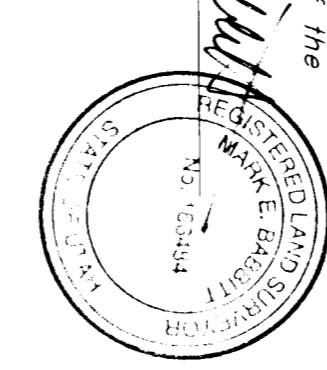

BOUNDARY DESCRIPTION
A part of the Northwest Quarter of Section 20, Township 20N, Range 17W, R1E, S18&M U.S. Survey (July 1991) beginning at a point on the East line of 3300 East Street (State Route #162) of a point 1295.57 feet North 89°47'30" West along the Section line from the Northwest corner of said Quarter Section and running thence South 0°01'45" East 200.00 feet; thence South 89°47'30" East 825.61 feet to monument 001.45 feet along said Section line 594.46 feet to the point of beginning. Contains 3.081 Acres

LEGEND
Section corner monument
Right-of-Way Monument
M.C.S. Marker Chain Survey
--- Ditch

Property Survey

STEVEN BROWN
A part of the Northwest Quarter of Section 20, 17W, R1E, S18&M U.S. Survey

DATE: 15 Jul 1999


SCALE: 1" = 30'

ESL

99N418V

REVISIONS:

RECEIVED
JUL 27 1999
WATER COUNTY SURVEYOR

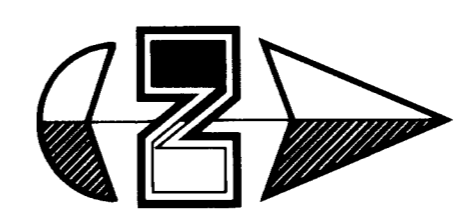

Scale: 1" = 30'