

Scale : 1" = 40'


NOTICE
This survey was requested by Mr. Ralph Williams in order to re establish his lot corners. The corners were found on 2950 East Street, a line bearing South 43°40'06" East between monument was used as the basis of bearings (Eastwood Subdivision No. 10 datum). Lot corners were monumented as depicted on drawing.

DESCRIPTION
All of lot 38, Eastwood Subdivision No. 1, Weber County, Utah containing 16,000 sq. ft. or .367 Acre

CERTIFICATION
I, Mark E. Bobbitt, do hereby certify that I am a Registered Professional Land Surveyor, and that I hold Certificate No. 166484, as prescribed by the Laws of the State of Utah, and I have made a survey of the above described property, I further certify that the dimensions of the property surveyed are as shown on this drawing.

RECEIVED
JUL 9 7 1999
Weber County Surveyor

Date: 16 July 1999
Mark E. Bobbitt

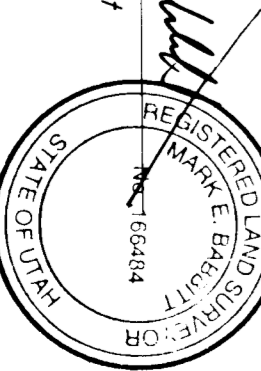

Property Survey

GREAT BASIN ENGINEERING NORTH
CONSULTING ENGINEERS AND SURVEYORS
3544 Lincoln Avenue, Ogden, Utah, 84401
P.O. Box 5207, Ogden, Utah, 84409
Phone: (435) 744-4551 Fax: (435) 744-4552

SCALE: 1" = 40'
DATE: 9 Jul 1999
DRAWN: MM
REVISIONS: ESTW0D3

A part of the Northwest 1/4 of Section 24, 7N, 10W, S12 & 13, Weber County, Utah

Ralph Williams
SPR: NW