


NARRATIVE
 This property survey was requested by Jacque Andrew of Prudential 1st Choice Real Estate in order to establish the property corners. The bearings and distances were measured on the ground between Ogden City Monuments found at the intersections of Quincy Avenue with Twentieth and Twenty-second Street, and between Quincy and Gramercy to be 134.42 feet deep instead of 132.00 feet. The East-West property lines have been prorated to match Ogden City Plots on this drawing.

NOTE:
 All rebars are 5/8" and 24" long.

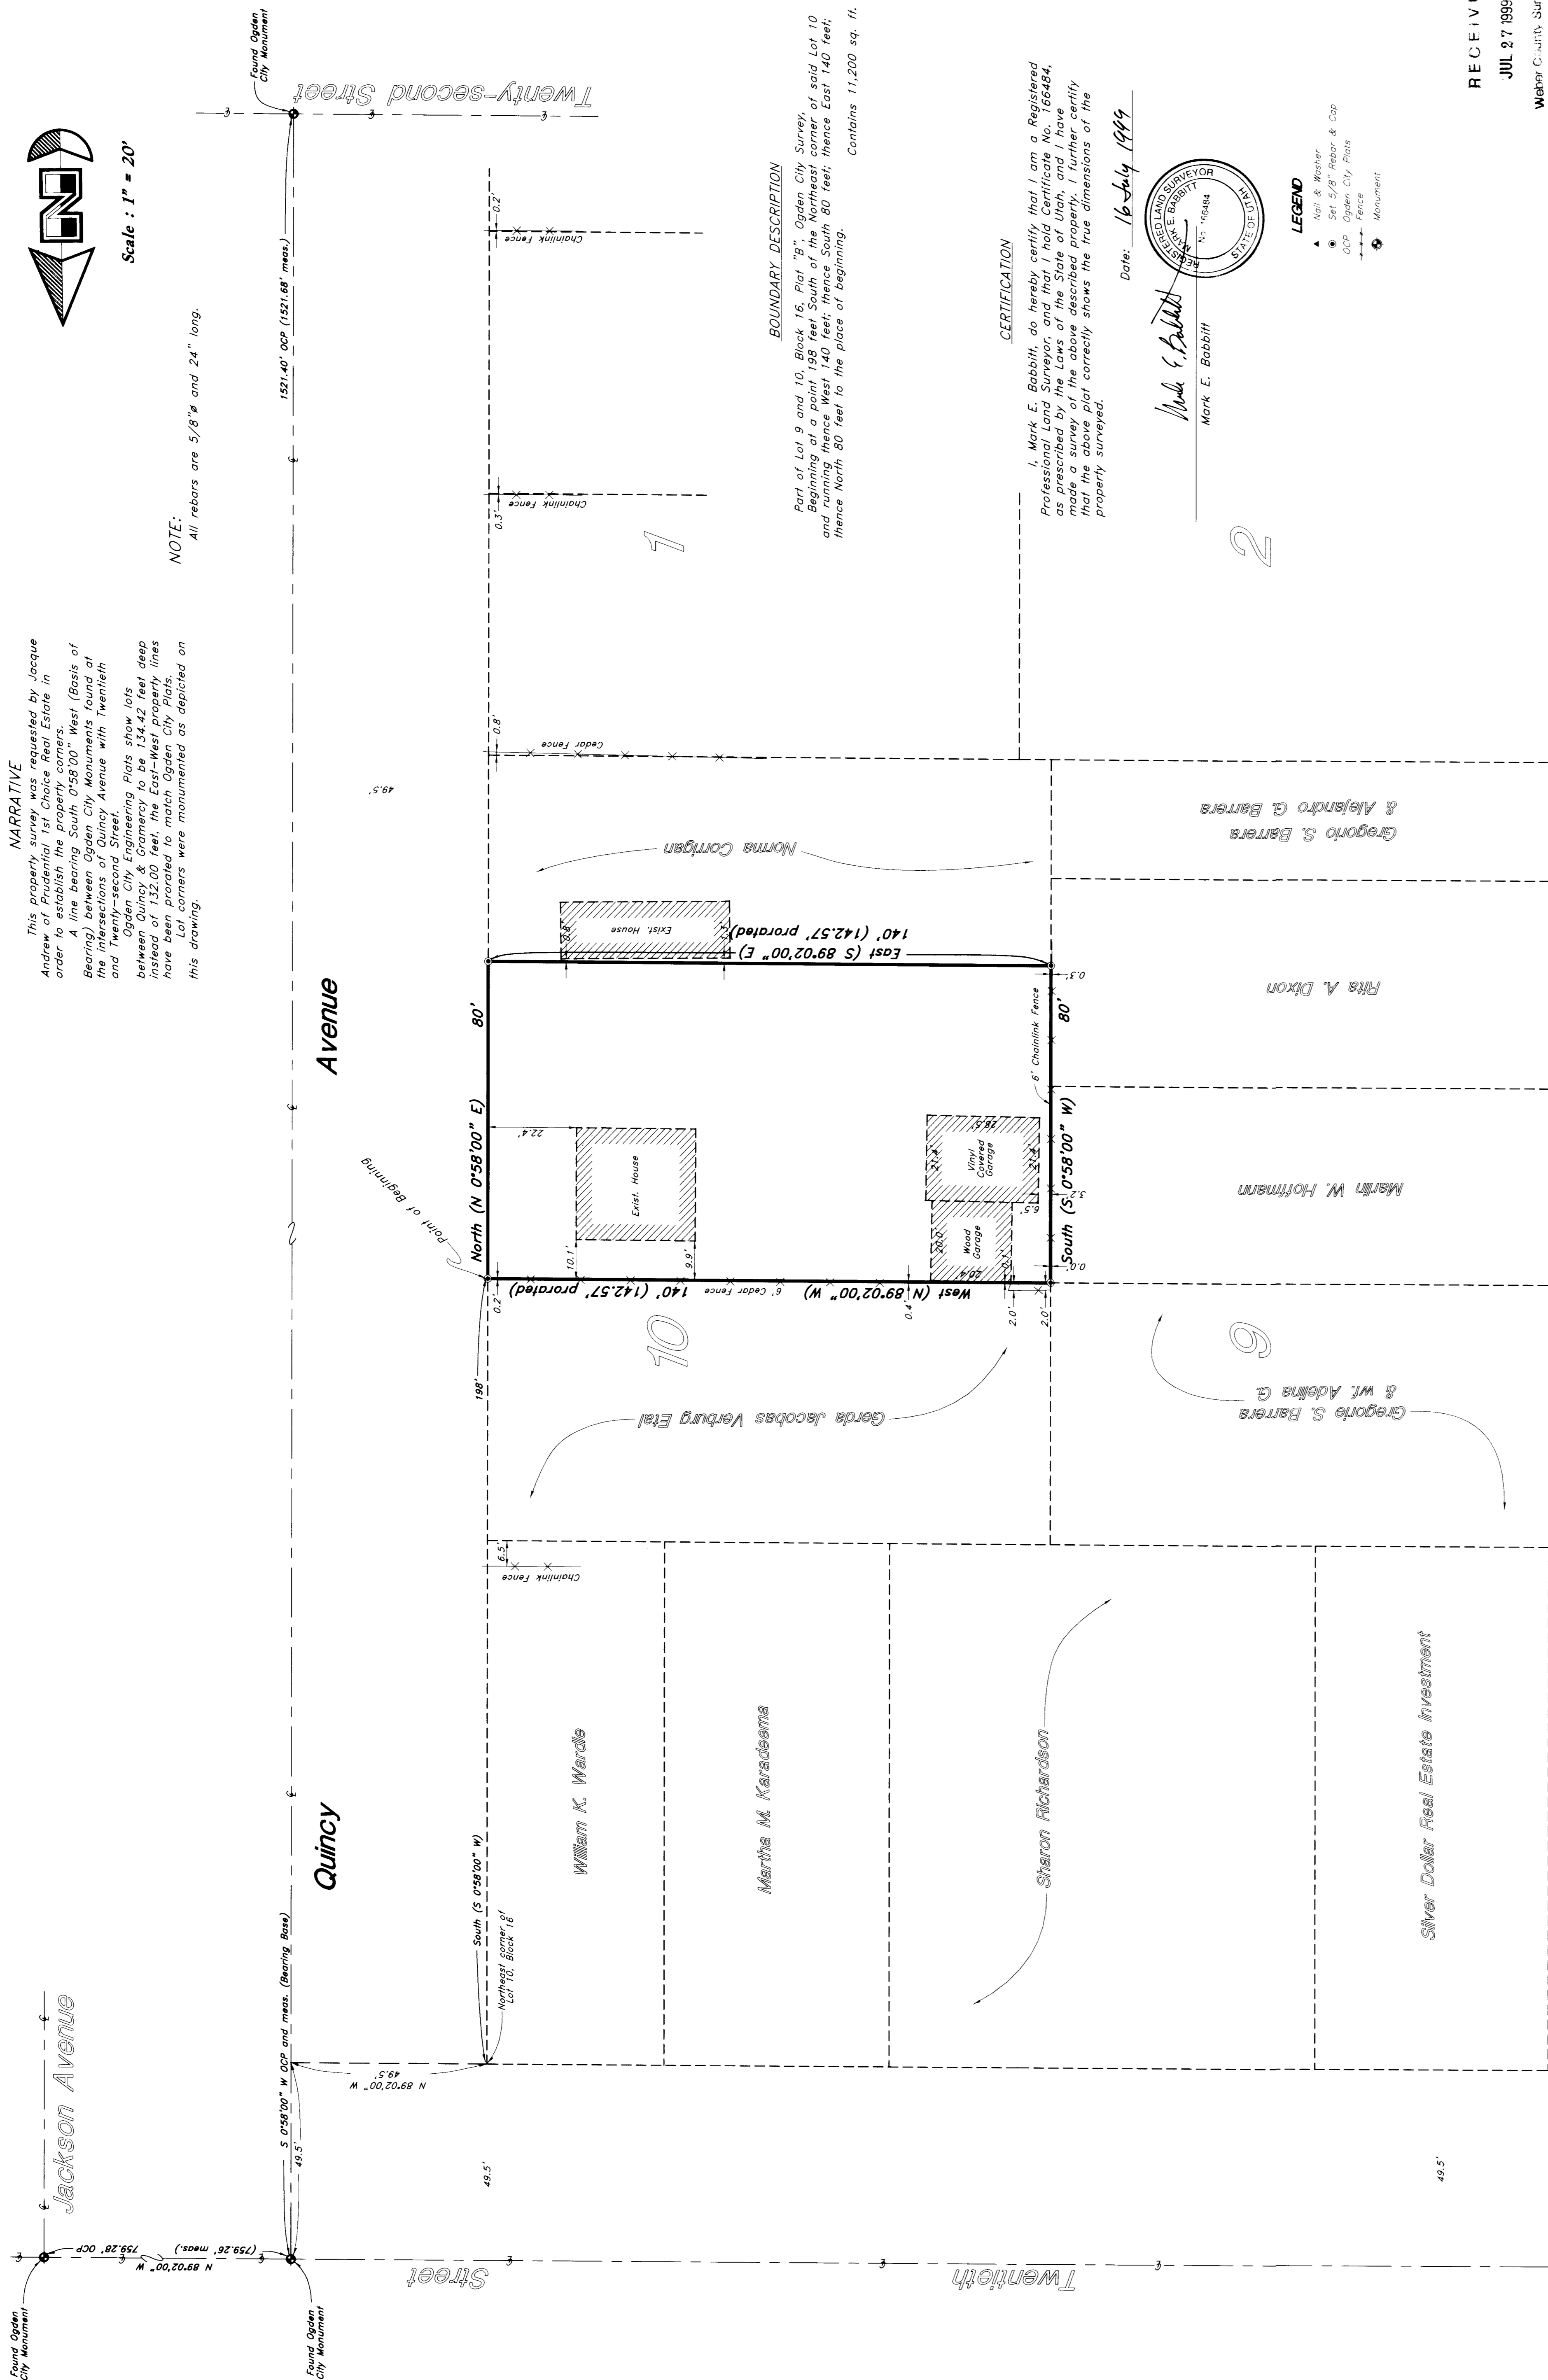

BOUNDARY DESCRIPTION

CERTIFICATION

Date: 16 July 1999
 Mark E. Babbitt
 REGISTERED SURVEYOR

LEGEND
 * Nail & Washer
 * Set 5/8" Rebar & Cap
 * OCP, Ogden City Plot
 --- Fence
 ◊ Monument

RECEIVED
 JUL 27 1999
 Weber County Survey

Property Survey
 Prudential 1st Choice Real Estate
 2031 Quincy Avenue
 Ogden, Utah 84401
 A part of Lot 9 and 10, Block 16, Plat "B", Ogden City Survey
 SCALE: 1" = 20'
 DATE: 18 Mar, 1999
 DRAWING NO. 99N413V
 REVISIONS:
 ESK
 15 Jul, 1999

