



E:\s14\dwg\98n152a.dwg Tue Jul 27 13:01:47 1999 bjb

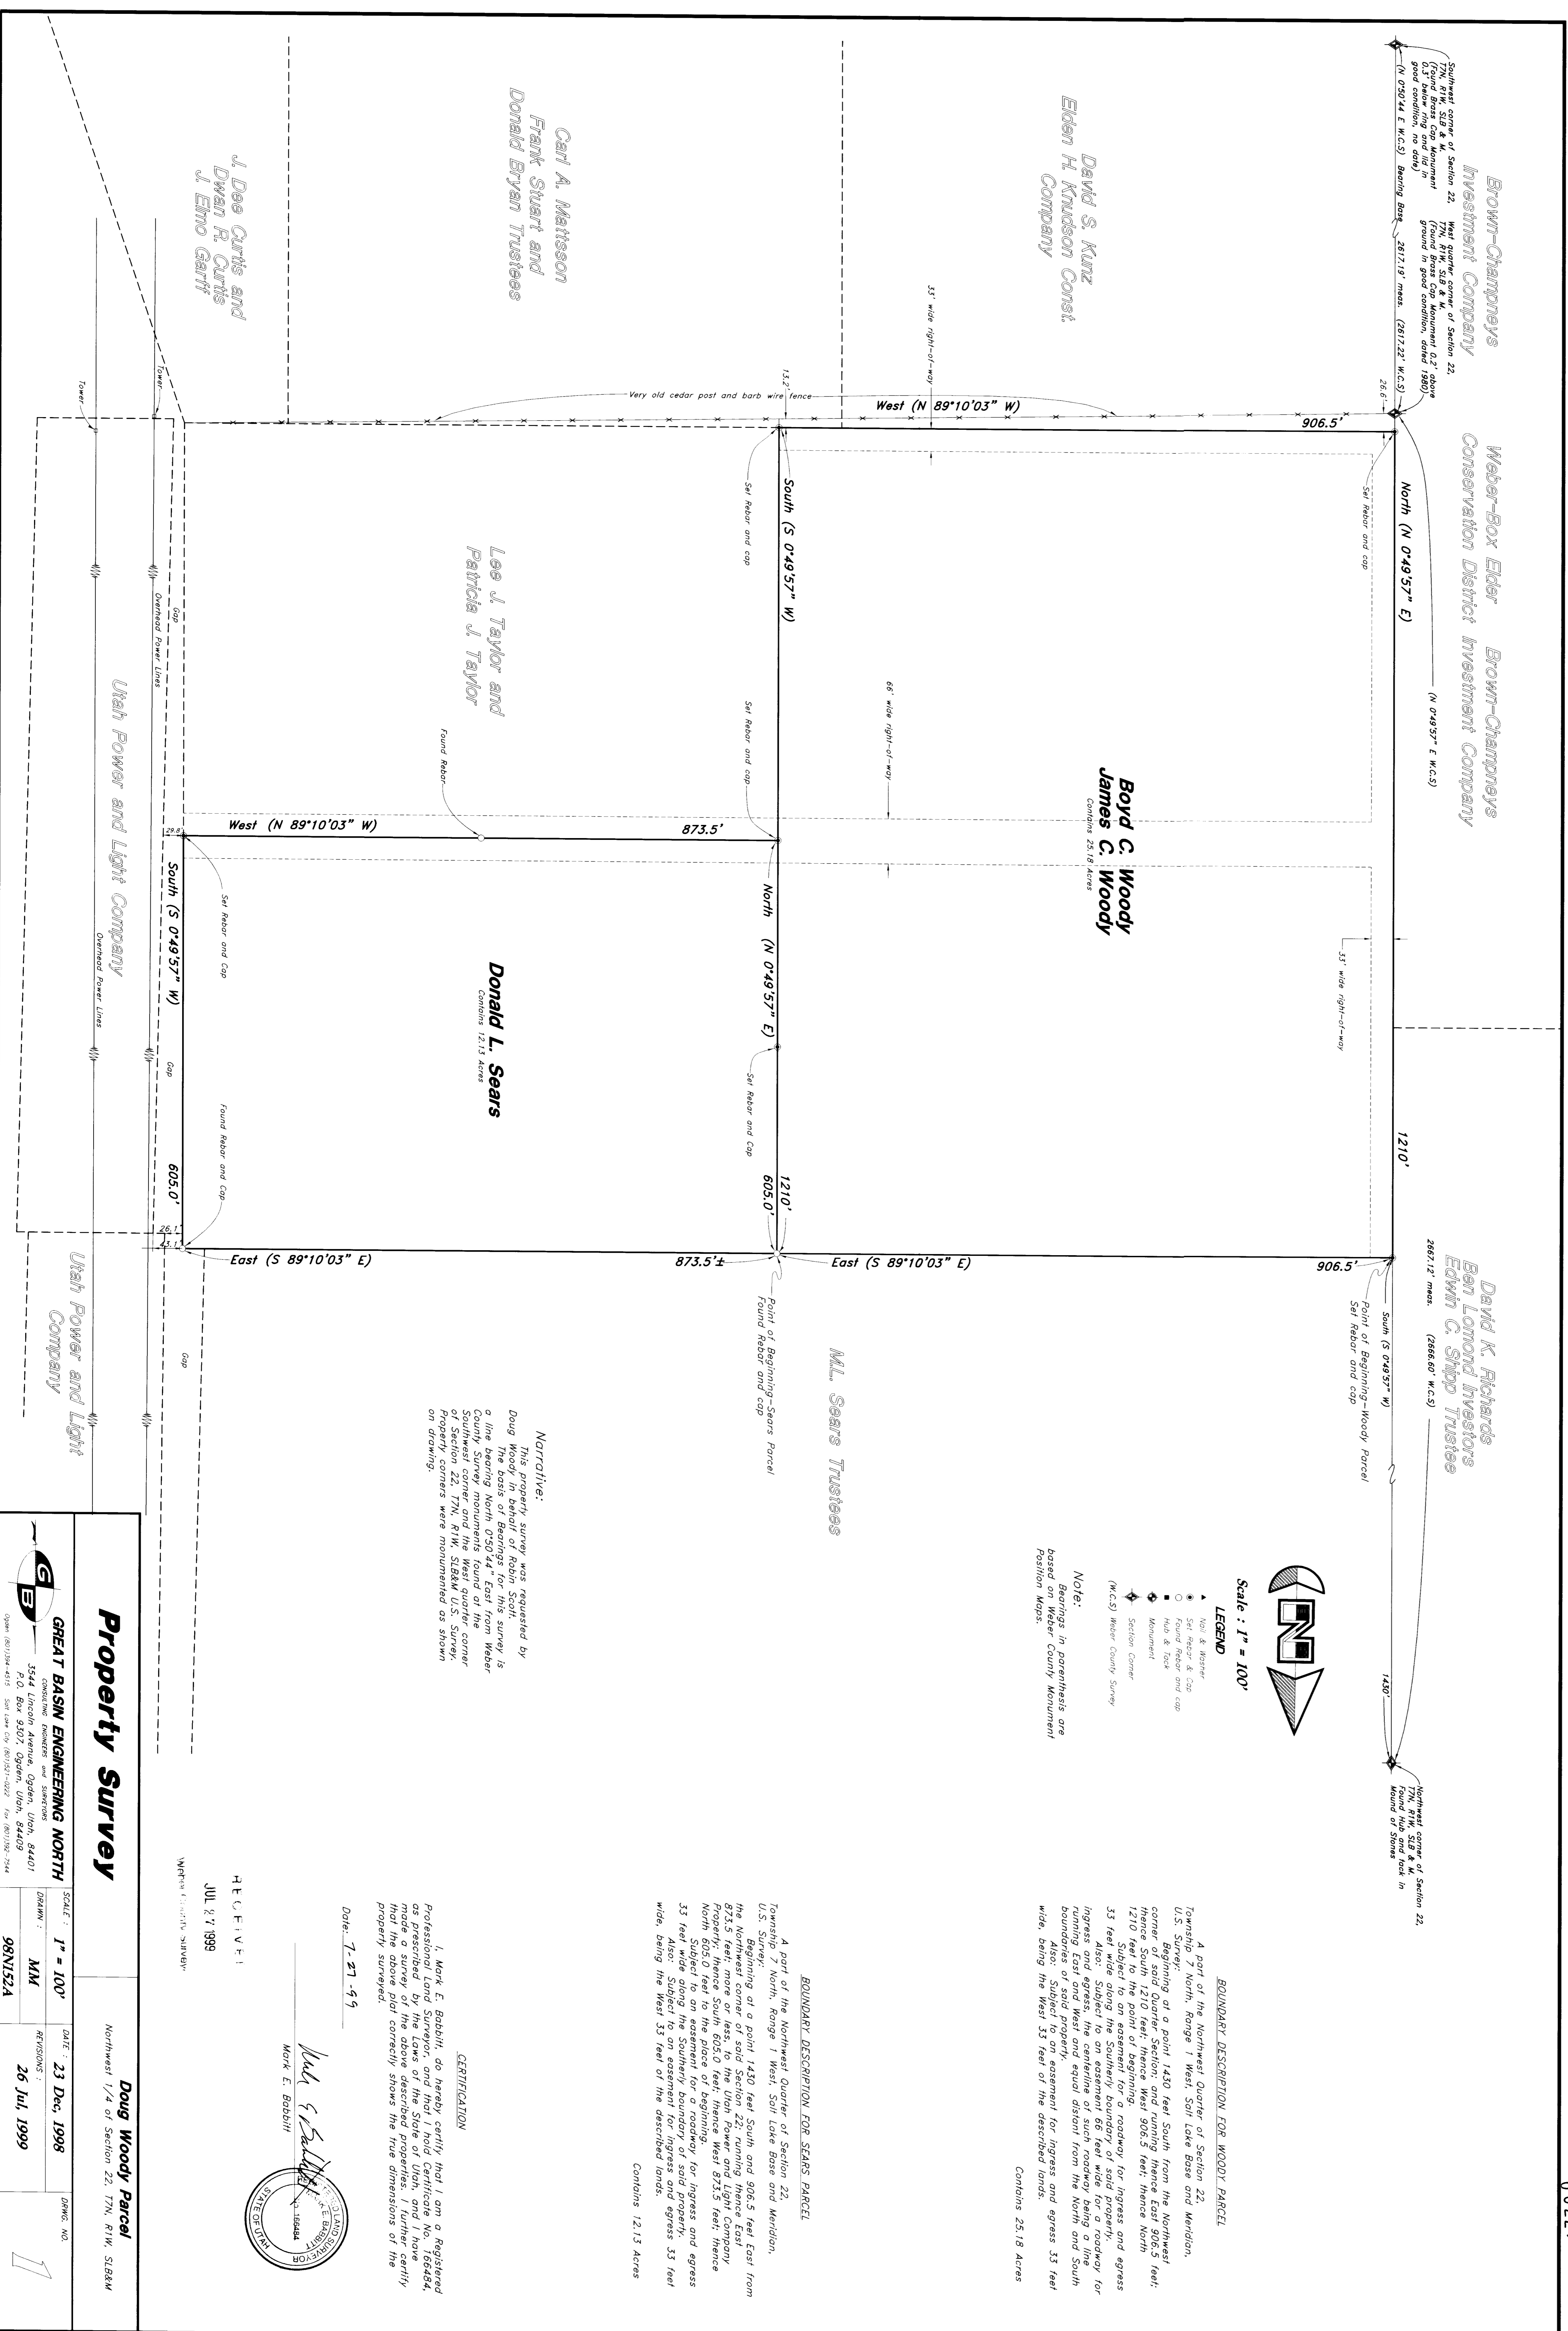


BOUNDARY DESCRIPTION FOR SEARS PARCEL
A part of the Northwest Quarter of Section 22, Township 7 North, Range 1 West, Soil Lake Bass and Meridian, U.S. Survey.

Contains 12.13 Acres

Note:
Bearings in parentheses are based on County Position Maps.

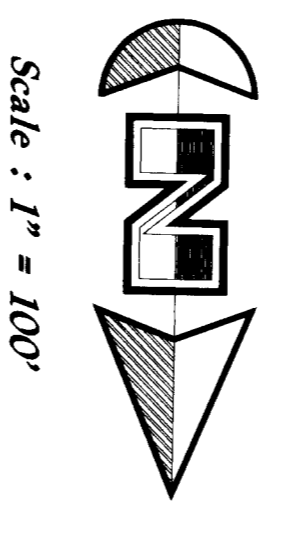

Scale : 1" = 100'

BOUNDARY DESCRIPTION FOR WOODY PARCEL
A part of the Northwest Quarter of Section 22, Township 7 North, Range 1 West, Soil Lake Bass and Meridian, U.S. Survey.

Contains 25.18 Acres

CERTIFICATION
Date: 7-27-99
Mark E. Bobbitt

Property Survey

<p>DATE: 23 Dec, 1998</p>		<p>PROJECT: Northwest 1/4 of Section 22, T7N, R1W, S28&M</p>	