

G:\DRAWINGS\SHARED\2869\13-L01F\Survey.dwg Thu Aug 05 11:14:47 1999 H.GUNN

002315

**BASIS OF BEARINGS**


**NARRATIVE**

THE PURPOSE OF THIS PLAT IS TO DEFINE THE FIRST NATIONAL INVESTMENTS COMPANY PROPERTY FOR LMC CONSTRUCTION. ALL LINES WERE SET BY THE FOUND OGDEN CITY MONUMENTS.

**SURVEYED DESCRIPTION**

PART OF LOTS 29 THROUGH 32, BLOCK 15, BROOKLYN ADDITION AND PART OF THE SOUTH HALF OF SECTION 30, T16N, R1W, S18.84M, U.S. SURVEY, DESCRIBED AS FOLLOWS:


**DEED DESCRIPTION**

THE NORTH 50 FEET OF LOTS 29 TO 32 INCLUSIVE, BLOCK 15, BROOKLYN ADDITION, OGDEN CITY, WEBER COUNTY, UTAH.


**SURVEYORS CERTIFICATE**

I, RANDALL J. MILLER, DEPOSE AND SAY THAT I AM A LICENSED SURVEYOR AND THAT THE SURVEY AND PLAT HEREON WERE MADE AND THE PLAT WAS PERFORMED BY ME OR UNDER MY DIRECTION, AND THAT THIS PLAN CORRECTLY REFLECTS THE FINDINGS OF THAT SURVEY.

SIGNED THIS 5TH DAY OF August, 1999.

159447  
UTAH LICENSE NUMBER

*Randall J. Miller*  
SURVEYOR

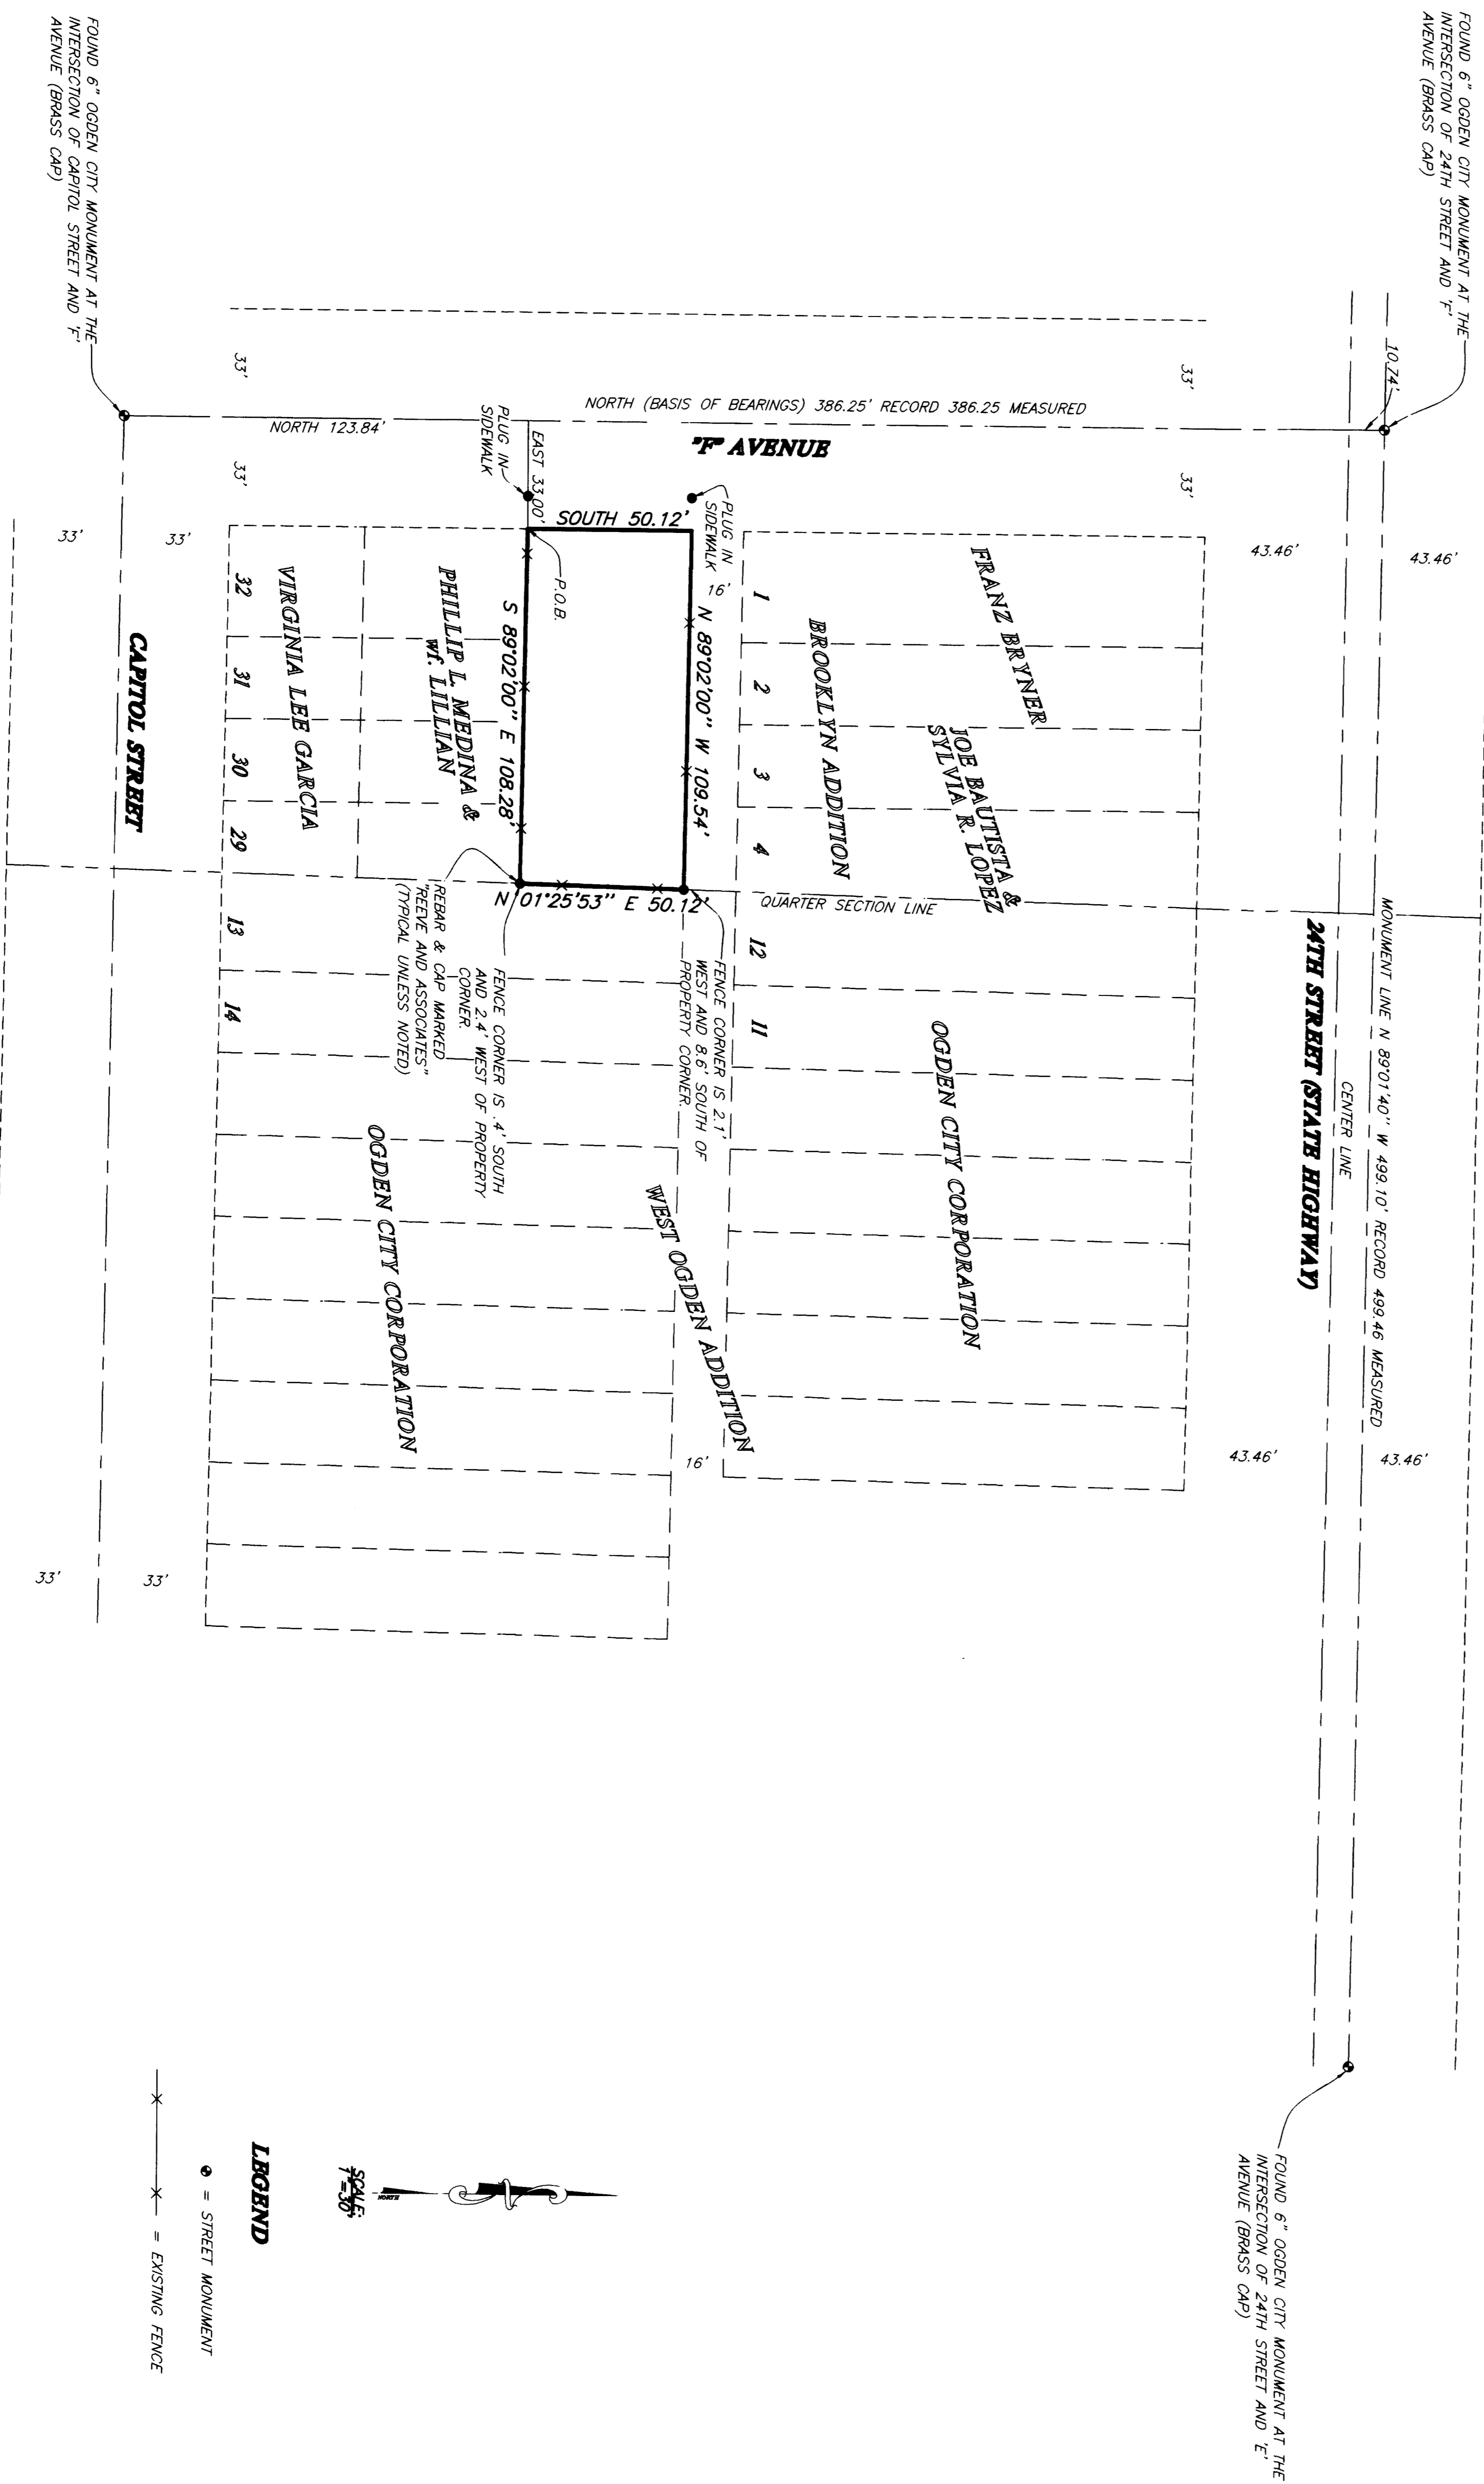

**LEGEND**  
● = STREET MONUMENT  
x = EXISTING FENCE

DATE: 8/1/99  
AUG 1 1999

THESE PLANS AND SPECIFICATIONS ARE THE PROPERTY OF REEVE & ASSOC., INC. 3230 QUINCY AVE. OGDEN, UTAH 84403 AND SHALL NOT BE COPIED OR REDUCED OR REPRODUCED WITHOUT THEIR WRITTEN PERMISSION.

REVISIONS  
1. \_\_\_\_\_  
2. \_\_\_\_\_  
3. \_\_\_\_\_  
4. \_\_\_\_\_  
5. \_\_\_\_\_  
6. \_\_\_\_\_

PROJECT NO.: 2869-13  
DATE: JUNE 14, 1999  
SCALE: 1"=30'

**REEVE & ASSOCIATES, INC.**  
ENGINEERING ARCHITECTURE SURVEYING  
1000 WEST OGDEN, UTAH 84403  
(801) 467-1520 FAX (801) 467-1511  
UTAH LICENSE NO. 159447

RECORD OF SURVEY

FIRST NATIONAL INVESTMENTS COMPANY  
PART OF BLOCK 15, BROOKLYN ADDITION  
PART OF SECTION 30, T16N, R1W, S18.84M, U.S. SURVEY  
MAY 26, 1989

SHEET 1 OF 1 SHEETS

002315