



SURVEYORS CERTIFICATE
SIGNED THIS 28TH DAY OF MAY, 1999.
129427 DAY LICENSE NUMBER
SIGNATURE

BASIS OF BEARINGS

NARRATIVE
THE PURPOSE OF THIS SURVEY IS TO DEFINE THE BOUNDARY OF THE BUCK PROPERTY FOR CAFE CONSTRUCTION. THE EAST LINE WAS FIXED BY THE WEST RIGHT-OF-WAY LINE OF 1900 WEST STREET (STATE HIGHWAY U-84). THE SOUTH LINE WAS SET BY REMAINS OF AN OLD BOUNDARY LINE. THE SOUTHWEST CORNER OF SAID BOUNDARY LINE AGREEMENT RECORDED IN BOOK 1712, PAGE 1311, THE WEST LINE WAS SET BY DEED.

SURVEYED DESCRIPTION
PART OF THE SOUTHEAST QUARTER OF SECTION 26, T6N, R2W, S18.84M, U.S. SURVEY, DESCRIBED AS FOLLOWS:
CONTAINS: 2.23 ACRES

DEED DESCRIPTION
BEGINNING AT A POINT ON THE WEST LINE OF THE STATE HIGHWAY NO. 84, SAID POINT BEING SOUTH 874.5 FEET AND WEST 60 FEET FROM THE EAST QUARTER CORNER OF SECTION 26, T6N, R2W, S18.84M, U.S. SURVEY, RUNNING THENCE WEST 600 FEET; THENCE SOUTH 148.5 FEET; OR LESS, EAST ALONG A LINE ADJACENT TO THE WEST LINE OF THE STATE HIGHWAY, THENCE NORTH ALONG SAID WEST LINE 148.5 FEET, MORE OR LESS, TO THE POINT OF BEGINNING.
TOGETHER WITH AND SUBJECT TO A RIGHT OF WAY 16 FEET WIDE, 8 FEET NORTH AND 8 FEET SOUTH OF THE NORTH LINE OF THE ABOVE DESCRIBED PROPERTY.

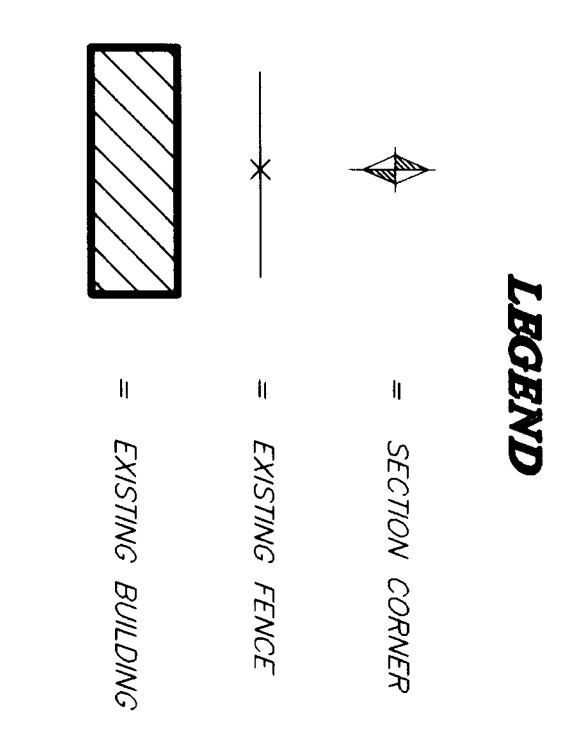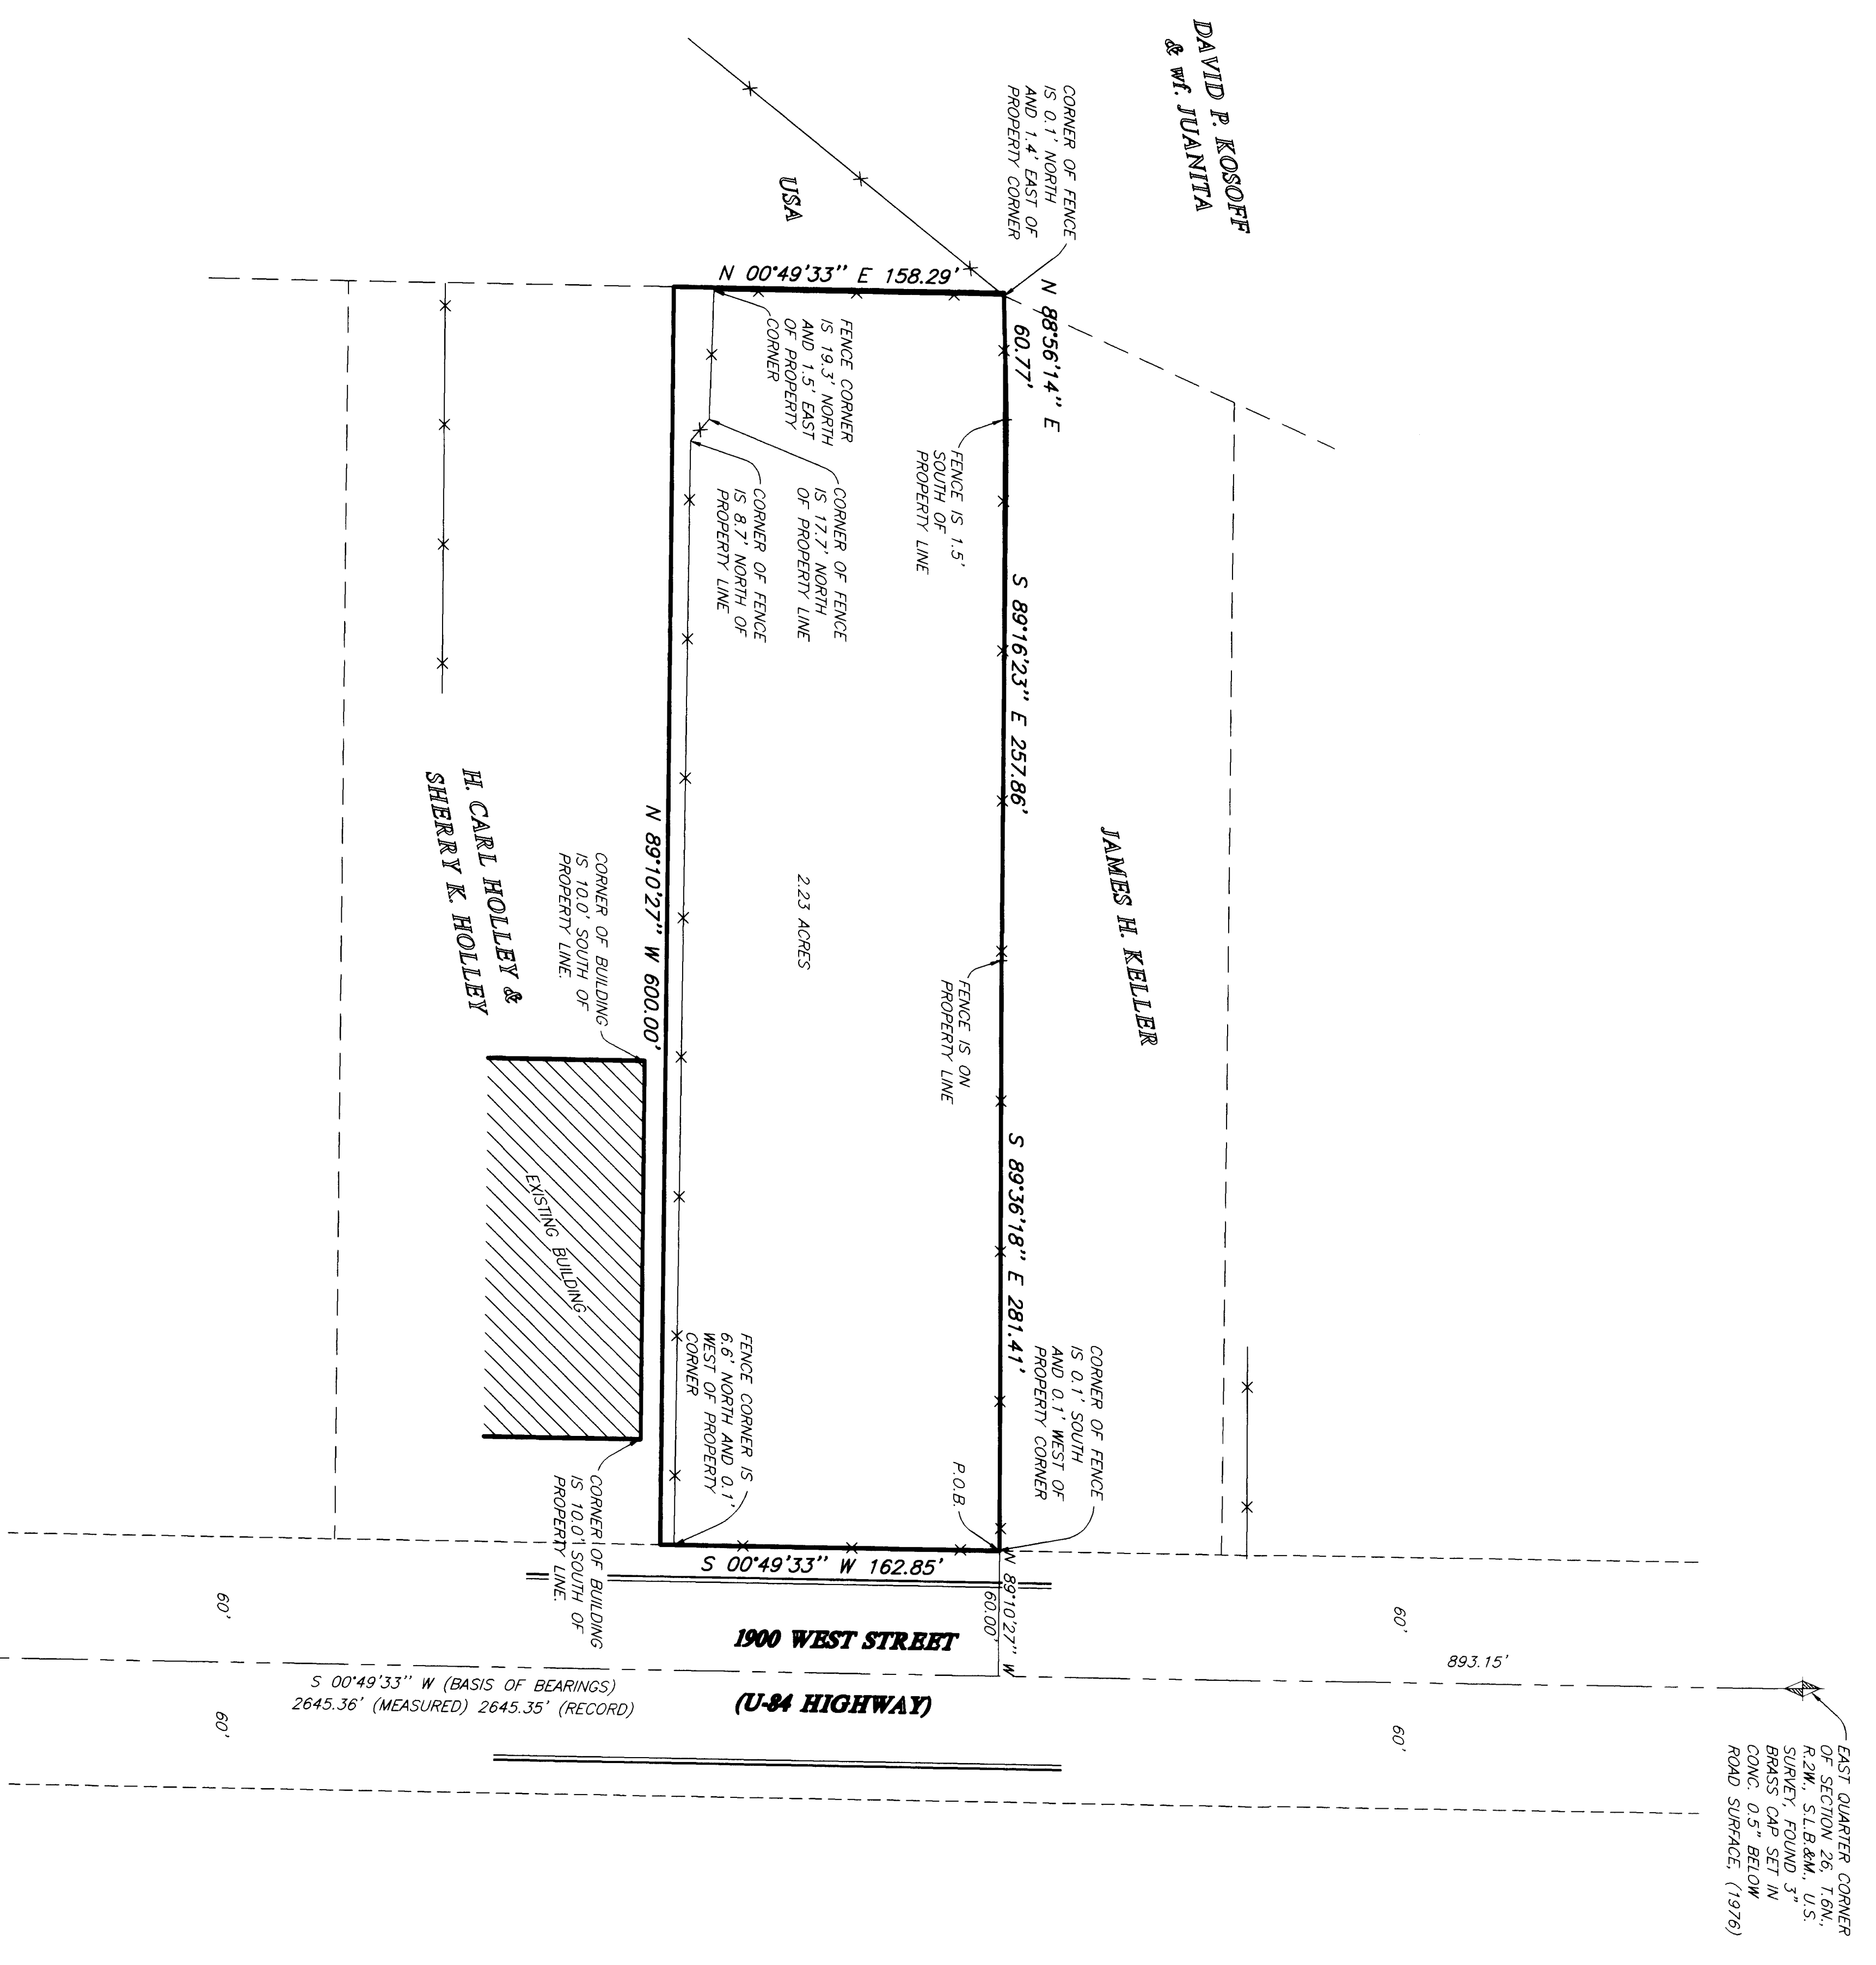

REVISIONS

1.		4.
2.		5.
3.		6.

PROJECT NO. 302-25 SURVEYOR: R. MITCHELL
DATE: 5-28-99 OWNER: H. HOLLEY
SCALE: 1"=50' CHECKED: _____

REEVE & ASSOCIATES, INC.
ENGINEERING AND SURVEYING

RECORD OF SURVEY

BUCK PROPERTY S18.84M, U.S. SURVEY
SECTION 26, T6N, R2W, S18.84M, U.S. SURVEY, FOUND 3rd
SOUTHEAST CORNER OF SECTION 26, T6N, R2W, S18.84M, U.S. SURVEY, FOUND 3rd CORNERS FOUND BELOW ROAD SURFACE (1973)

SHEET 1 OF 1 SHEETS