



# MIDLAND SQUARE SUBDIVISION

PART OF THE SW 1/4 OF SECTION 2, T5N, R2W  
SALT LAKE BASIN AND MERIDIAN, U.S. SURVEY  
ROY CITY, WEBER COUNTY, UTAH


## MIDLAND SQUARE SUBDIVISION RECORD BOUNDARY

BEGINNING AT A POINT ON THE WEST LINE OF SECTION 2 T5N R2W SLB&M,  
SAID POINT ALSO BEING A POINT ON THE CENTRALLINE OF 2700 WEST STREET  
BEING S 00°13'00" W 962.22 FEET FROM THE WEST QUARTER CORNER OF SAID  
SECTION 2;

THENCE S 89°50'00" E 383.00 FEET;  
THENCE S 00°13'00" W 113.70 FEET;  
THENCE S 43°54'00" W 191.70 FEET;  
THENCE N 89°50'00" W 250.60 FEET;  
THENCE N 00°13'00" E 252.22 FEET TO THE POINT OF BEGINNING.  
CONTAINS: 87,429 SQ. FT. / 2.007 ACRES

**LEGEND:**

- FOUND MARK AS INDICATED
- ⊙ SET 5/8 REBAR W/CAP OR AS INDICATED
- ⊙ SET NAIL AND WASHER AS INDICATED
- ⊙ SECTION CONTROL AS INDICATED
- ( ) RECORD DATA

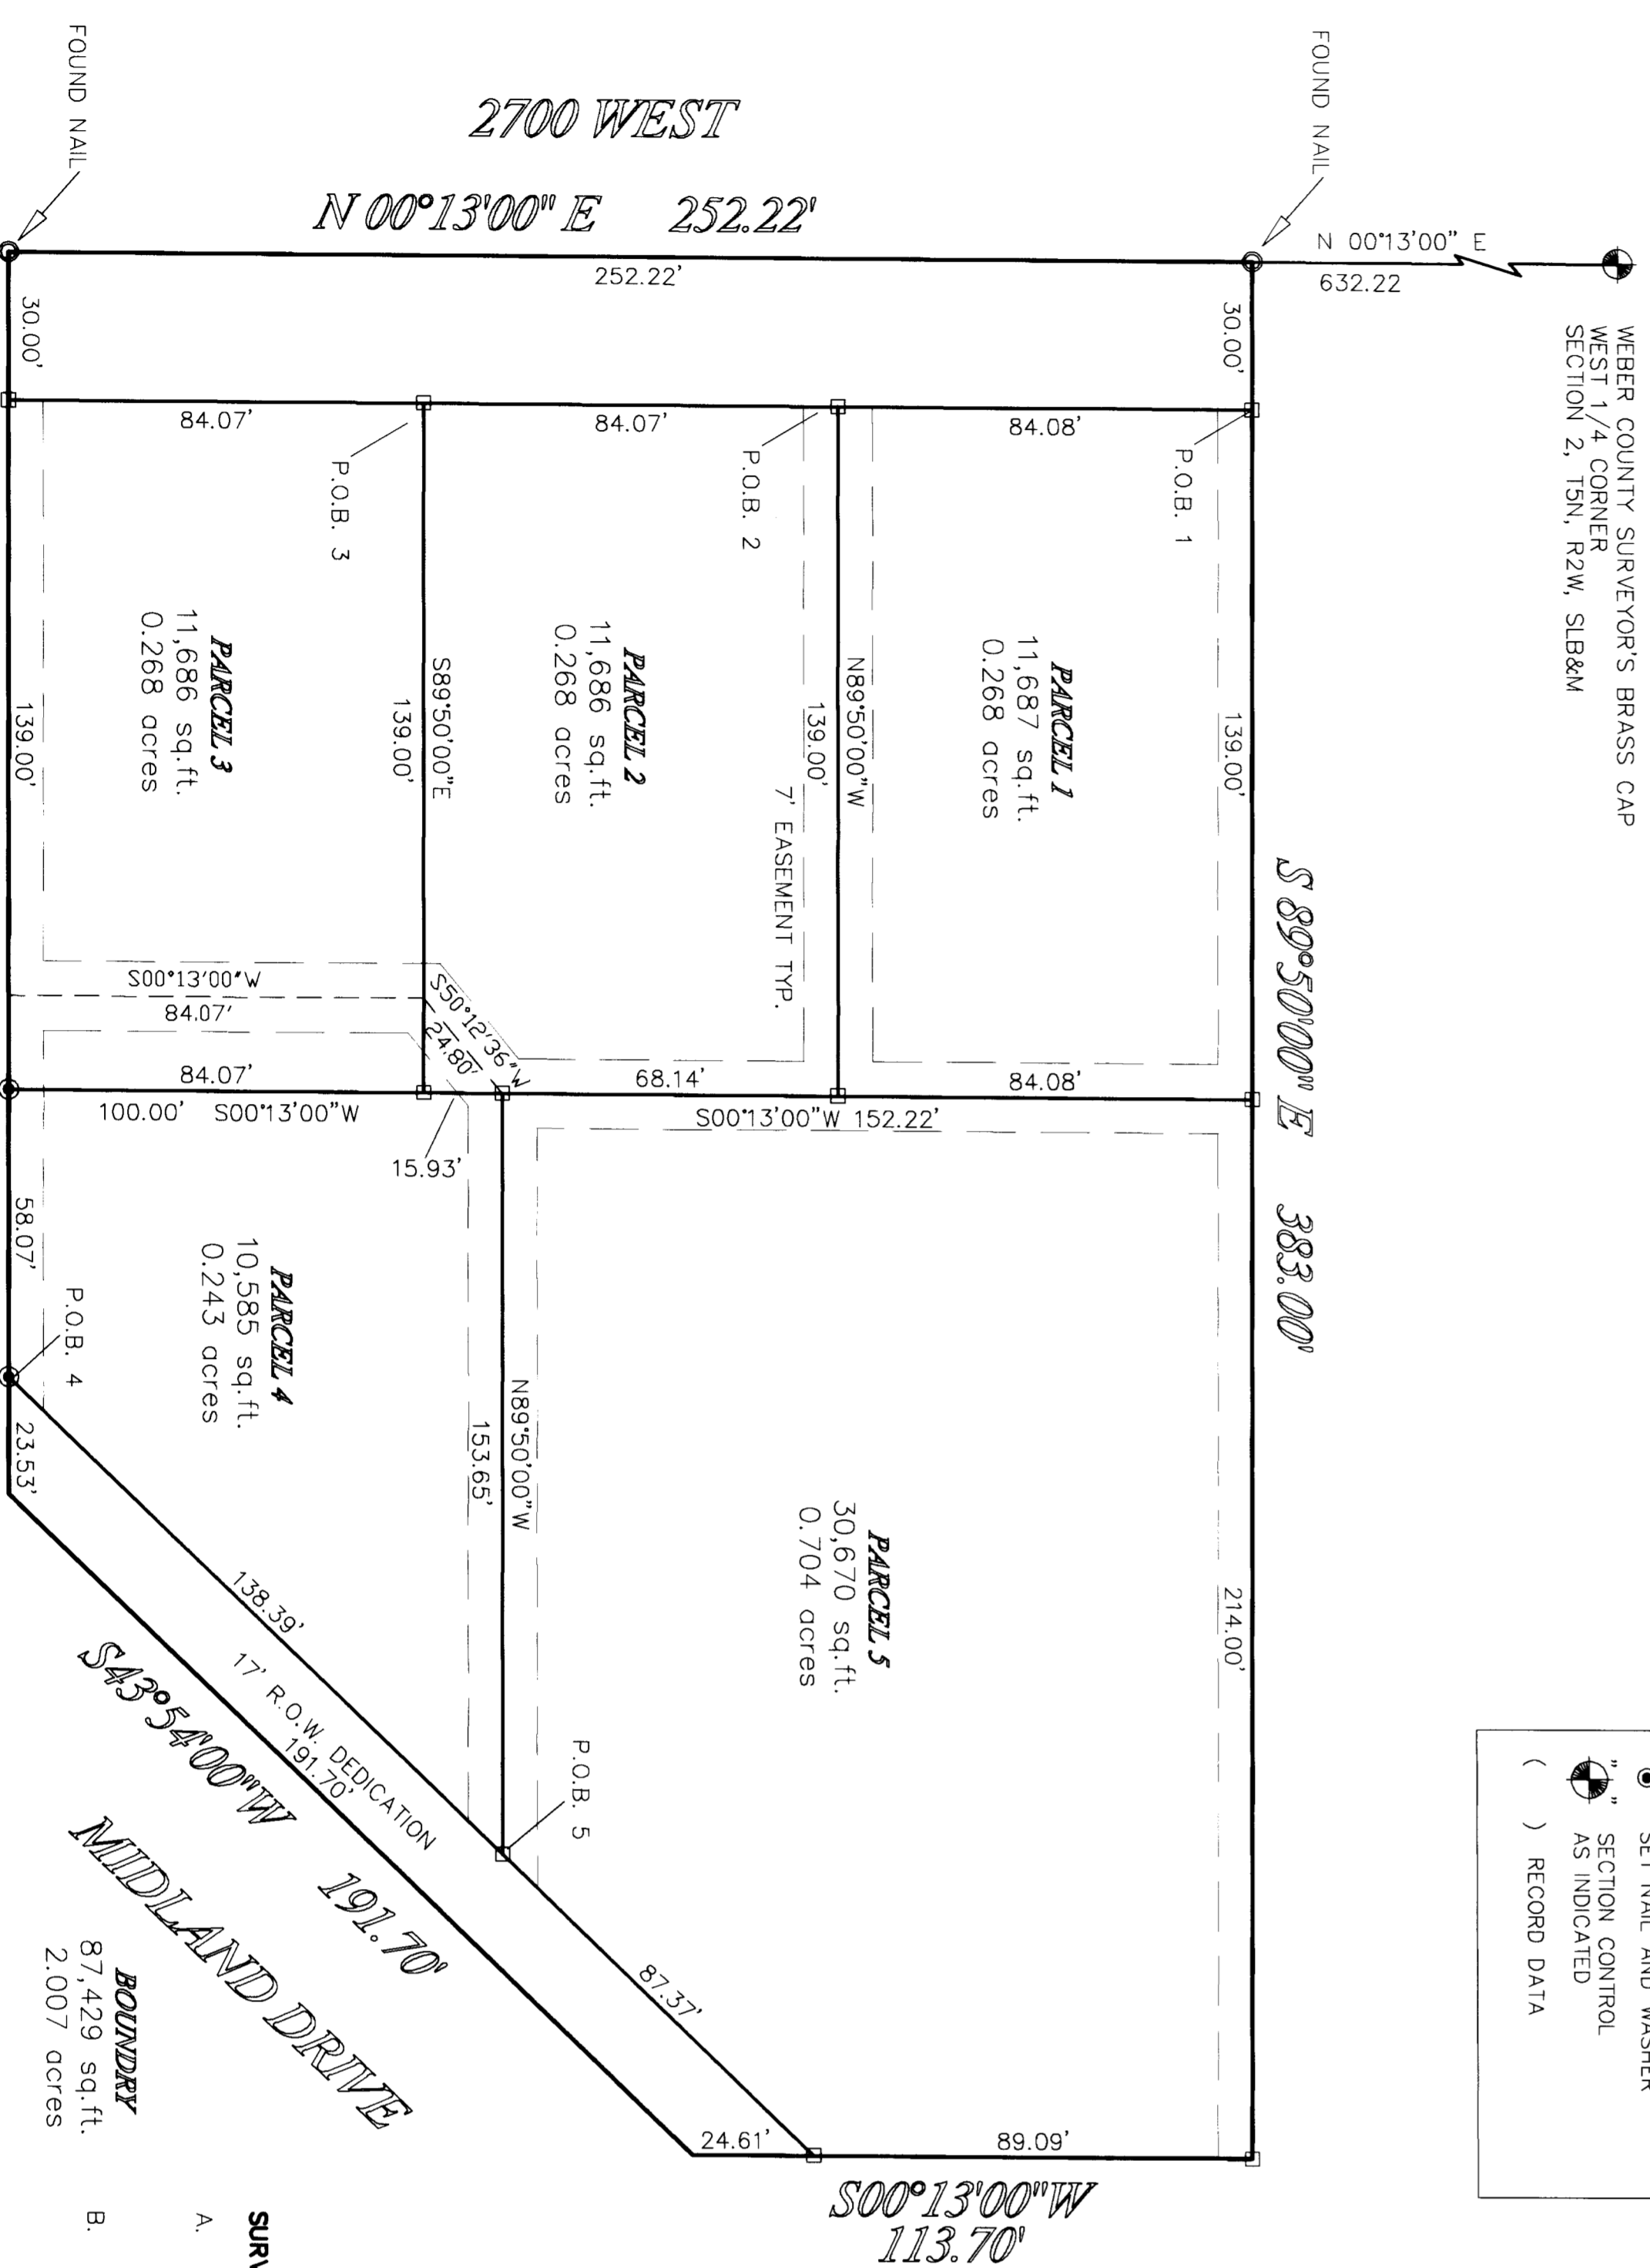

### PARCEL 1

BEGINNING AT A POINT ON THE EAST LINE OF 2700 WEST STREET SAID POINT BEING SOUTH 962.30 FEET AND EAST 26.36 FEET FROM THE WEST QUARTER CORNER OF SECTION 2 T5N, R2W, SLB&M;

THENCE S 89°50'00" E 139.00 FEET TO A REBAR W/CAP;  
THENCE S 89°50'00" W 139.00 FEET TO THE EAST LINE OF 2700 WEST;  
THENCE N 00°13'00" E 84.07 FEET ALONG SAID EAST LINE OF 2700 WEST TO A REBAR W/CAP AND THE POINT OF BEGINNING.  
CONTAINS: 11,687 SQ. FT. / 0.268 ACRES

### PARCEL 2

BEGINNING AT A POINT ON THE EAST LINE OF 2700 WEST STREET, SAID POINT BEING SOUTH 1,046.38 FEET AND EAST 26.04 FEET FROM THE WEST QUARTER CORNER OF SECTION 2 T5N, R2W, SLB&M;

THENCE S 89°50'00" E 139.00 FEET TO A REBAR W/CAP;  
THENCE S 00°13'00" W 84.07 FEET TO THE EAST LINE OF 2700 WEST;  
THENCE N 89°50'00" W 139.00 FEET TO THE EAST LINE OF 2700 WEST;  
THENCE N 00°13'00" E 84.07 FEET ALONG 2700 WEST TO A REBAR W/CAP AND THE POINT OF BEGINNING.

### PARCEL 3

BEGINNING AT A POINT ON THE EAST LINE OF 2700 WEST STREET SAID POINT BEING SOUTH 1,115.37 FEET AND EAST 318.44 FEET FROM THE WEST QUARTER CORNER OF SECTION 2 T5N, R2W, SLB&M;

THENCE S 89°50'00" E 139.00 FEET TO A REBAR W/CAP;  
THENCE S 00°13'00" W 84.07 FEET TO A REBAR W/CAP;  
THENCE N 89°50'00" W 139.00 FEET TO THE EAST LINE OF 2700 WEST AND A REBAR W/CAP; 84.07 FEET ALONG SAID EAST LINE OF 2700 WEST TO A REBAR W/CAP AND THE POINT OF BEGINNING.  
CONTAINS: 11,686 SQ. FT. / 0.268 ACRES

### PARCEL 4

BEGINNING AT A POINT ON THE WEST LINE OF MIDLAND DRIVE SAID POINT BEING SOUTH 1,215.09 FEET AND EAST 222.48 FEET FROM THE WEST QUARTER CORNER OF SECTION 2 T5N, R2W, SLB&M;

THENCE N 89°50'00" W 58.07 FEET TO A REBAR W/CAP;  
THENCE N 00°13'00" E 100.00 FEET TO A REBAR W/CAP;  
THENCE S 89°50'00" E 139.65 FEET TO THE WEST LINE OF MIDLAND DR. AND A REBAR W/CAP; 89.39 FEET ALONG SAID WEST LINE OF MIDLAND DRIVE TO A REBAR W/CAP AND THE POINT OF BEGINNING.  
CONTAINS: 10,585 SQ. FT. / 0.243 ACRES

### PARCEL 5

BEGINNING AT A POINT ON THE WEST LINE OF MIDLAND DRIVE SAID POINT BEING SOUTH 1,115.37 FEET AND EAST 318.44 FEET FROM THE WEST QUARTER CORNER OF SECTION 2 T5N, R2W, SLB&M;

THENCE N 89°50'00" W 153.65 FEET TO A REBAR W/CAP;  
THENCE N 00°13'00" E 153.65 FEET TO A REBAR W/CAP;  
THENCE S 00°13'00" W 89.09 FEET TO THE WEST LINE OF MIDLAND DR. AND A REBAR W/CAP;  
THENCE S 43°54'00" W 87.37 FEET ALONG SAID WEST LINE OF MIDLAND DRIVE TO A REBAR W/CAP AND THE POINT OF BEGINNING.  
CONTAINS: 30,670 SQ. FT. / 0.704 ACRES

### SURVEY NARRATIVE:

- A. THIS SURVEY WAS MADE AT THE REQUEST OF PAT DEAN, BRIDGEWAY, CODEN, UTAH, 84404, TEL. 933-8004
- B. THE PURPOSE OF THE SURVEY IS TO AMEND AN EXISTING SUBDIVISION AND TO PROPERTY MONUMENT ALL PROPERTY CORNERS.
- C. CORNERS MARKED AS "a" ARE 5/8" X 24" REBARS, WITH CAPS STAMPED "MOUNTAIN ENGINEERING". OTHER MARKS FOUND OR SET ARE AS INDICATED.
- D. THE BASIS OF BEARING IS THE WEST LINE OF SECTION 2, CALLED NORTH 01°13'00" EAST, AS MONUMENTED.

### SURVEYOR'S CERTIFICATE

UNDER MY DIRECTION.

SIGNED THIS 7 DAY OF Sept, 1999.

WILLIAM L. HOYOK, P.E. & R.L.S.  
UTAH LAND SURVEYOR REGISTRATION NO. 86-167461-2201



RECEIVED  
\$22 97 9999  
Water County Surveyor

### REVISIONS

DATE	BY	COMMENTS



DESIGNED BY:  
DRAWN BY:  
K.S.M.  
DATE:  
FEBRUARY 1999

### MIDLAND SQUARE SUBDIVISION

INTERIOR LOT LINE ADJUSTMENTS  
A PART OF THE SW 1/4 OF SECTION 2  
TOWNSHIP 5 NORTH, RANGE 2 WEST  
SALT LAKE BASIN AND MERIDIAN, U.S. SURVEY  
ROY CITY, WEBER COUNTY, UTAH

JOB NO.  
1999

**MOUNTAIN ENGINEERING**  
P. O. BOX 309  
MORGAN, UTAH 84050  
TEL (801) 829-3747 829-3620