

DRAWING NUMBER

002330

DRAWING NUMBER

002330

DRAWING NUMBER

002330

DRAWING NUMBER

002330

002330

RECORD OF SURVEY

SURVEYOR'S CERTIFICATE
I, PAUL J. ROSS, AM A REGISTERED LAND SURVEYOR AND PLAT I HOLD LICENSE NUMBER 189389 AS PRESCRIBED UNDER THE LAWS THAT BY THE AUTHORITY OF THE OWNERS) THAT WE, OF SUNRISE ENGINEERING, INC. MADE DURING A SURVEY OF THE TRACT THAT THIS PLAT IS A TRUE AND ACCURATE MAP OF THE LAND SURVEYED



Handwritten signatures and dates: 1st of 1999, 3/1/99, 99002

SURVEYED DESCRIPTION

Commencing at the monument located on the monument line of 12th Street of bearing N 88°41'21" W 3665.01' along the monument line to monument located at the intersection of 12th Street and 1200 West Street) thence N 19°46'21" E 4139.513' to a point and the true (Point 

NOTES

1- BASIS OF BEARING: S 88°41'21" E 3665.01' ON CENTERLINE OF 12TH STREET AS MONUMENTED
1- THE PURPOSE OF THIS SURVEY IS ESTABLISH A BOUNDARY AND LEGAL DESCRIPTION FOR THE SUBJECT PARCEL
REVISION #1 - CORRECTED BEARING AND DISTANCE CALLS AS SHOWN ON THE PLAT AND IN THE SURVEYED DESCRIPTION ABOVE

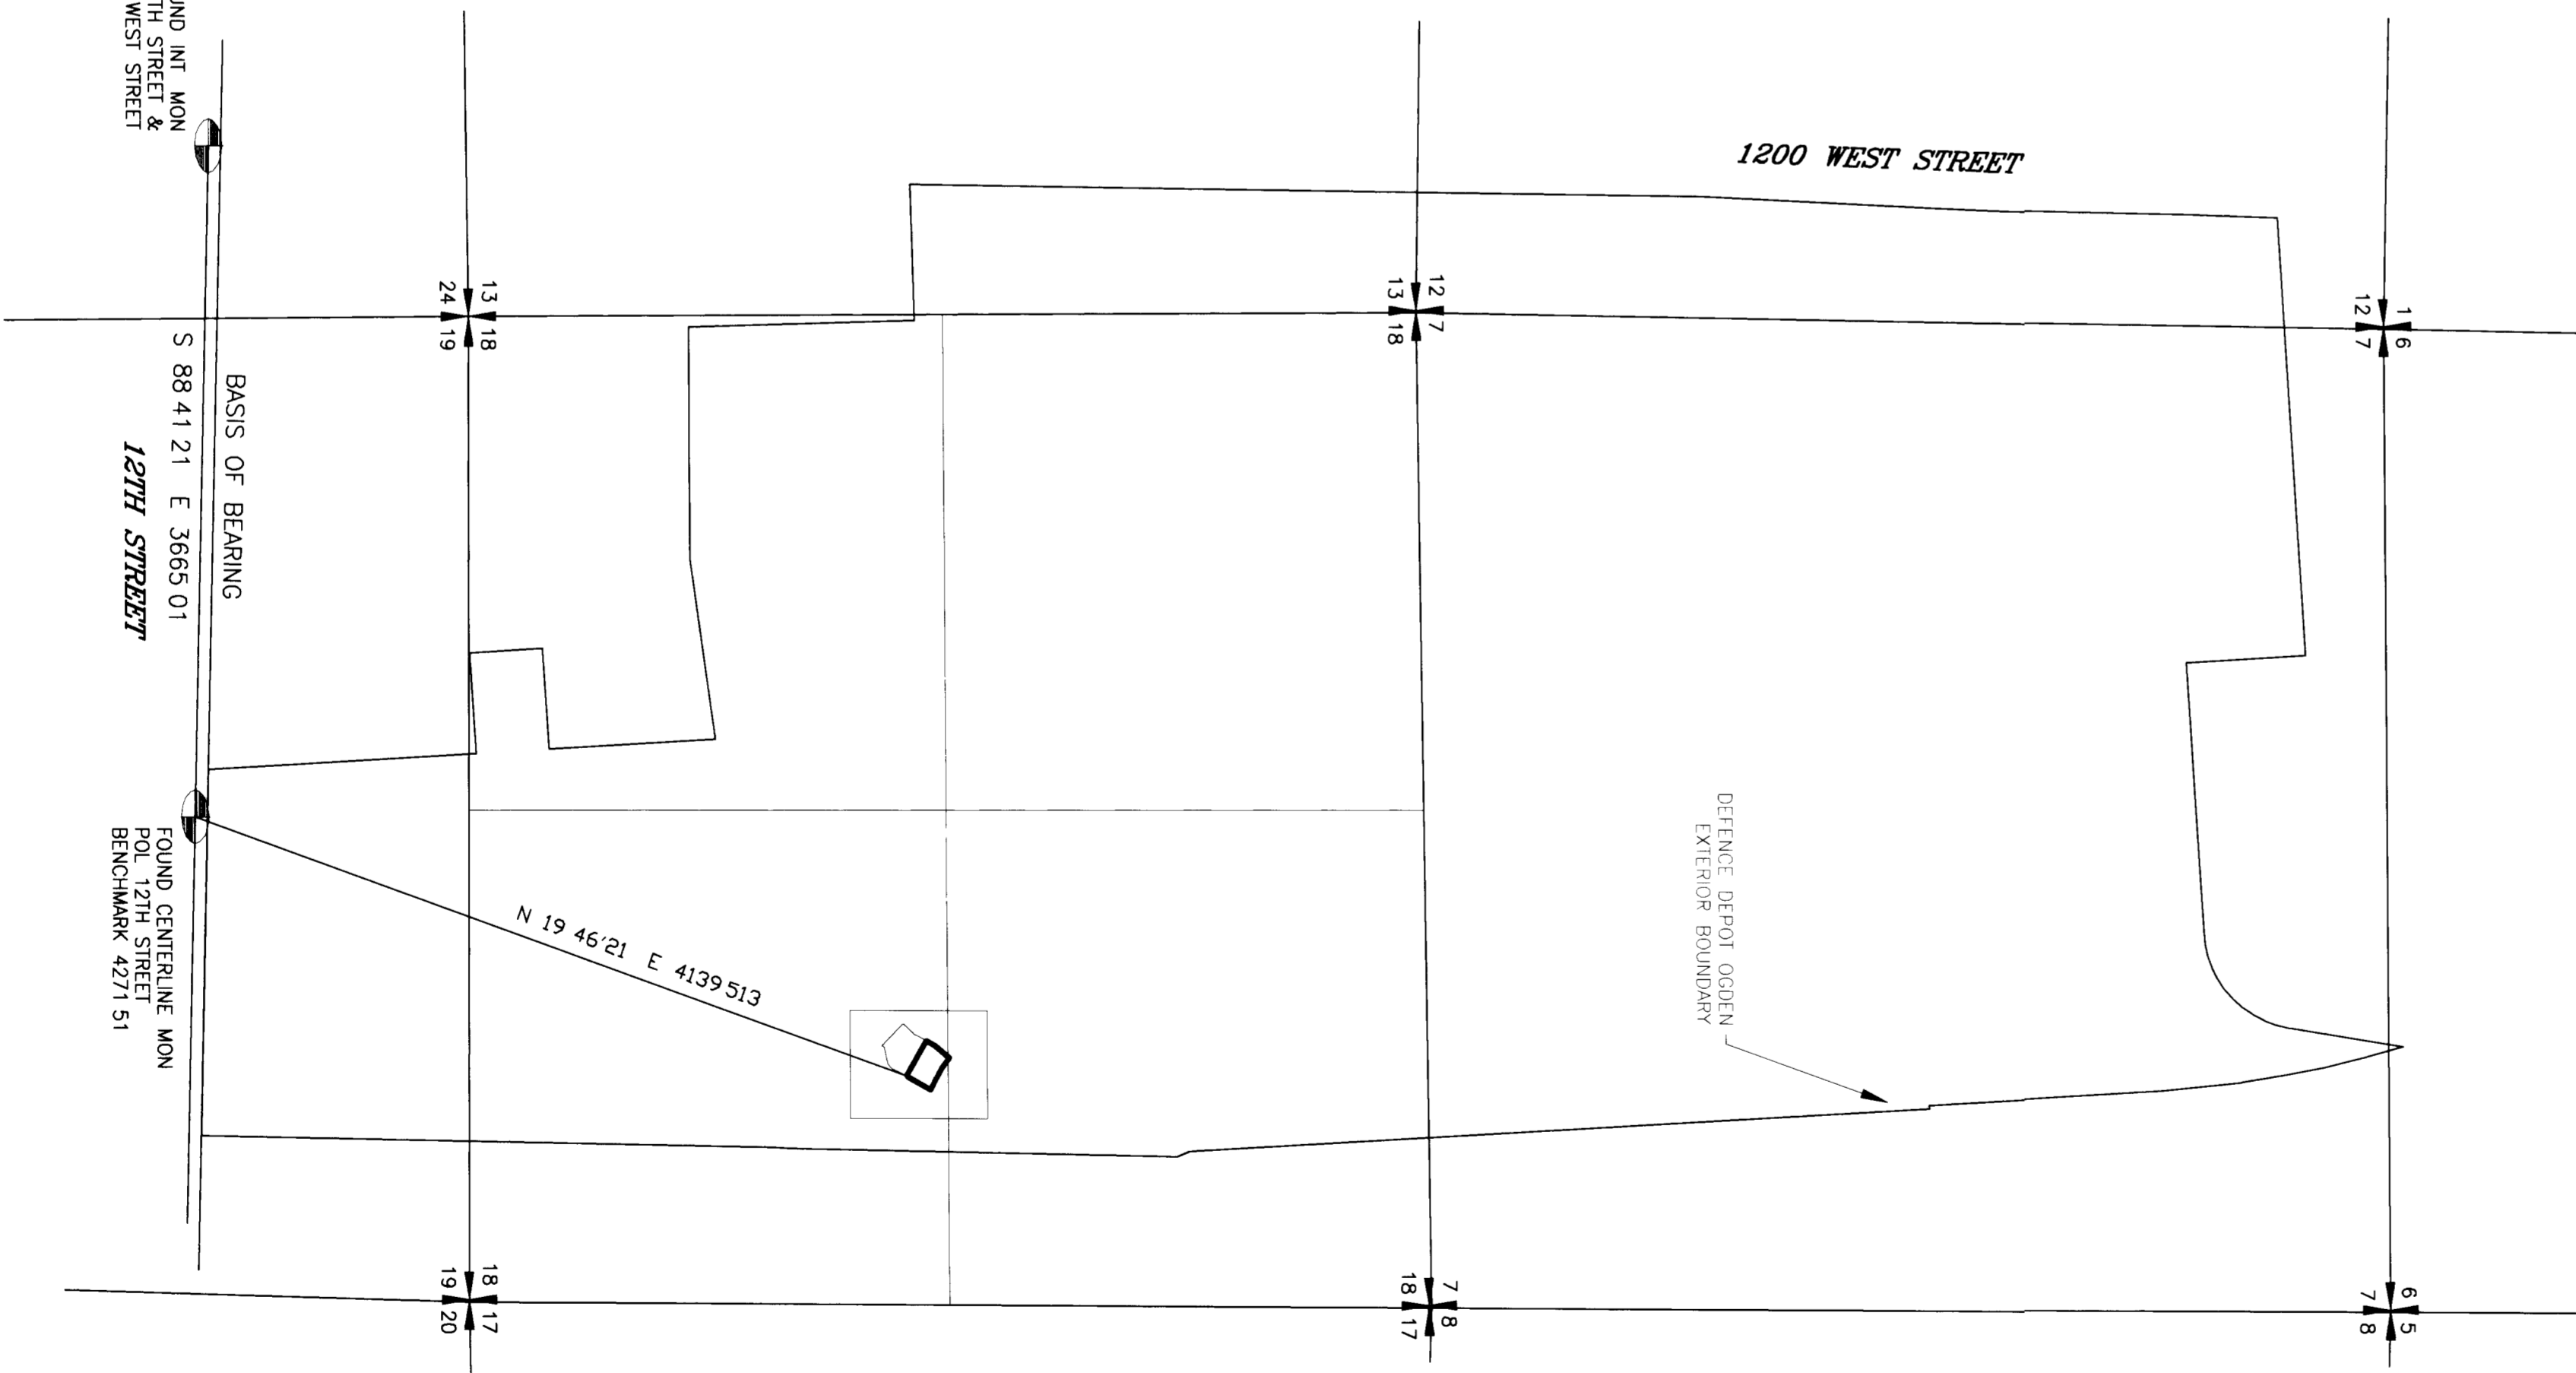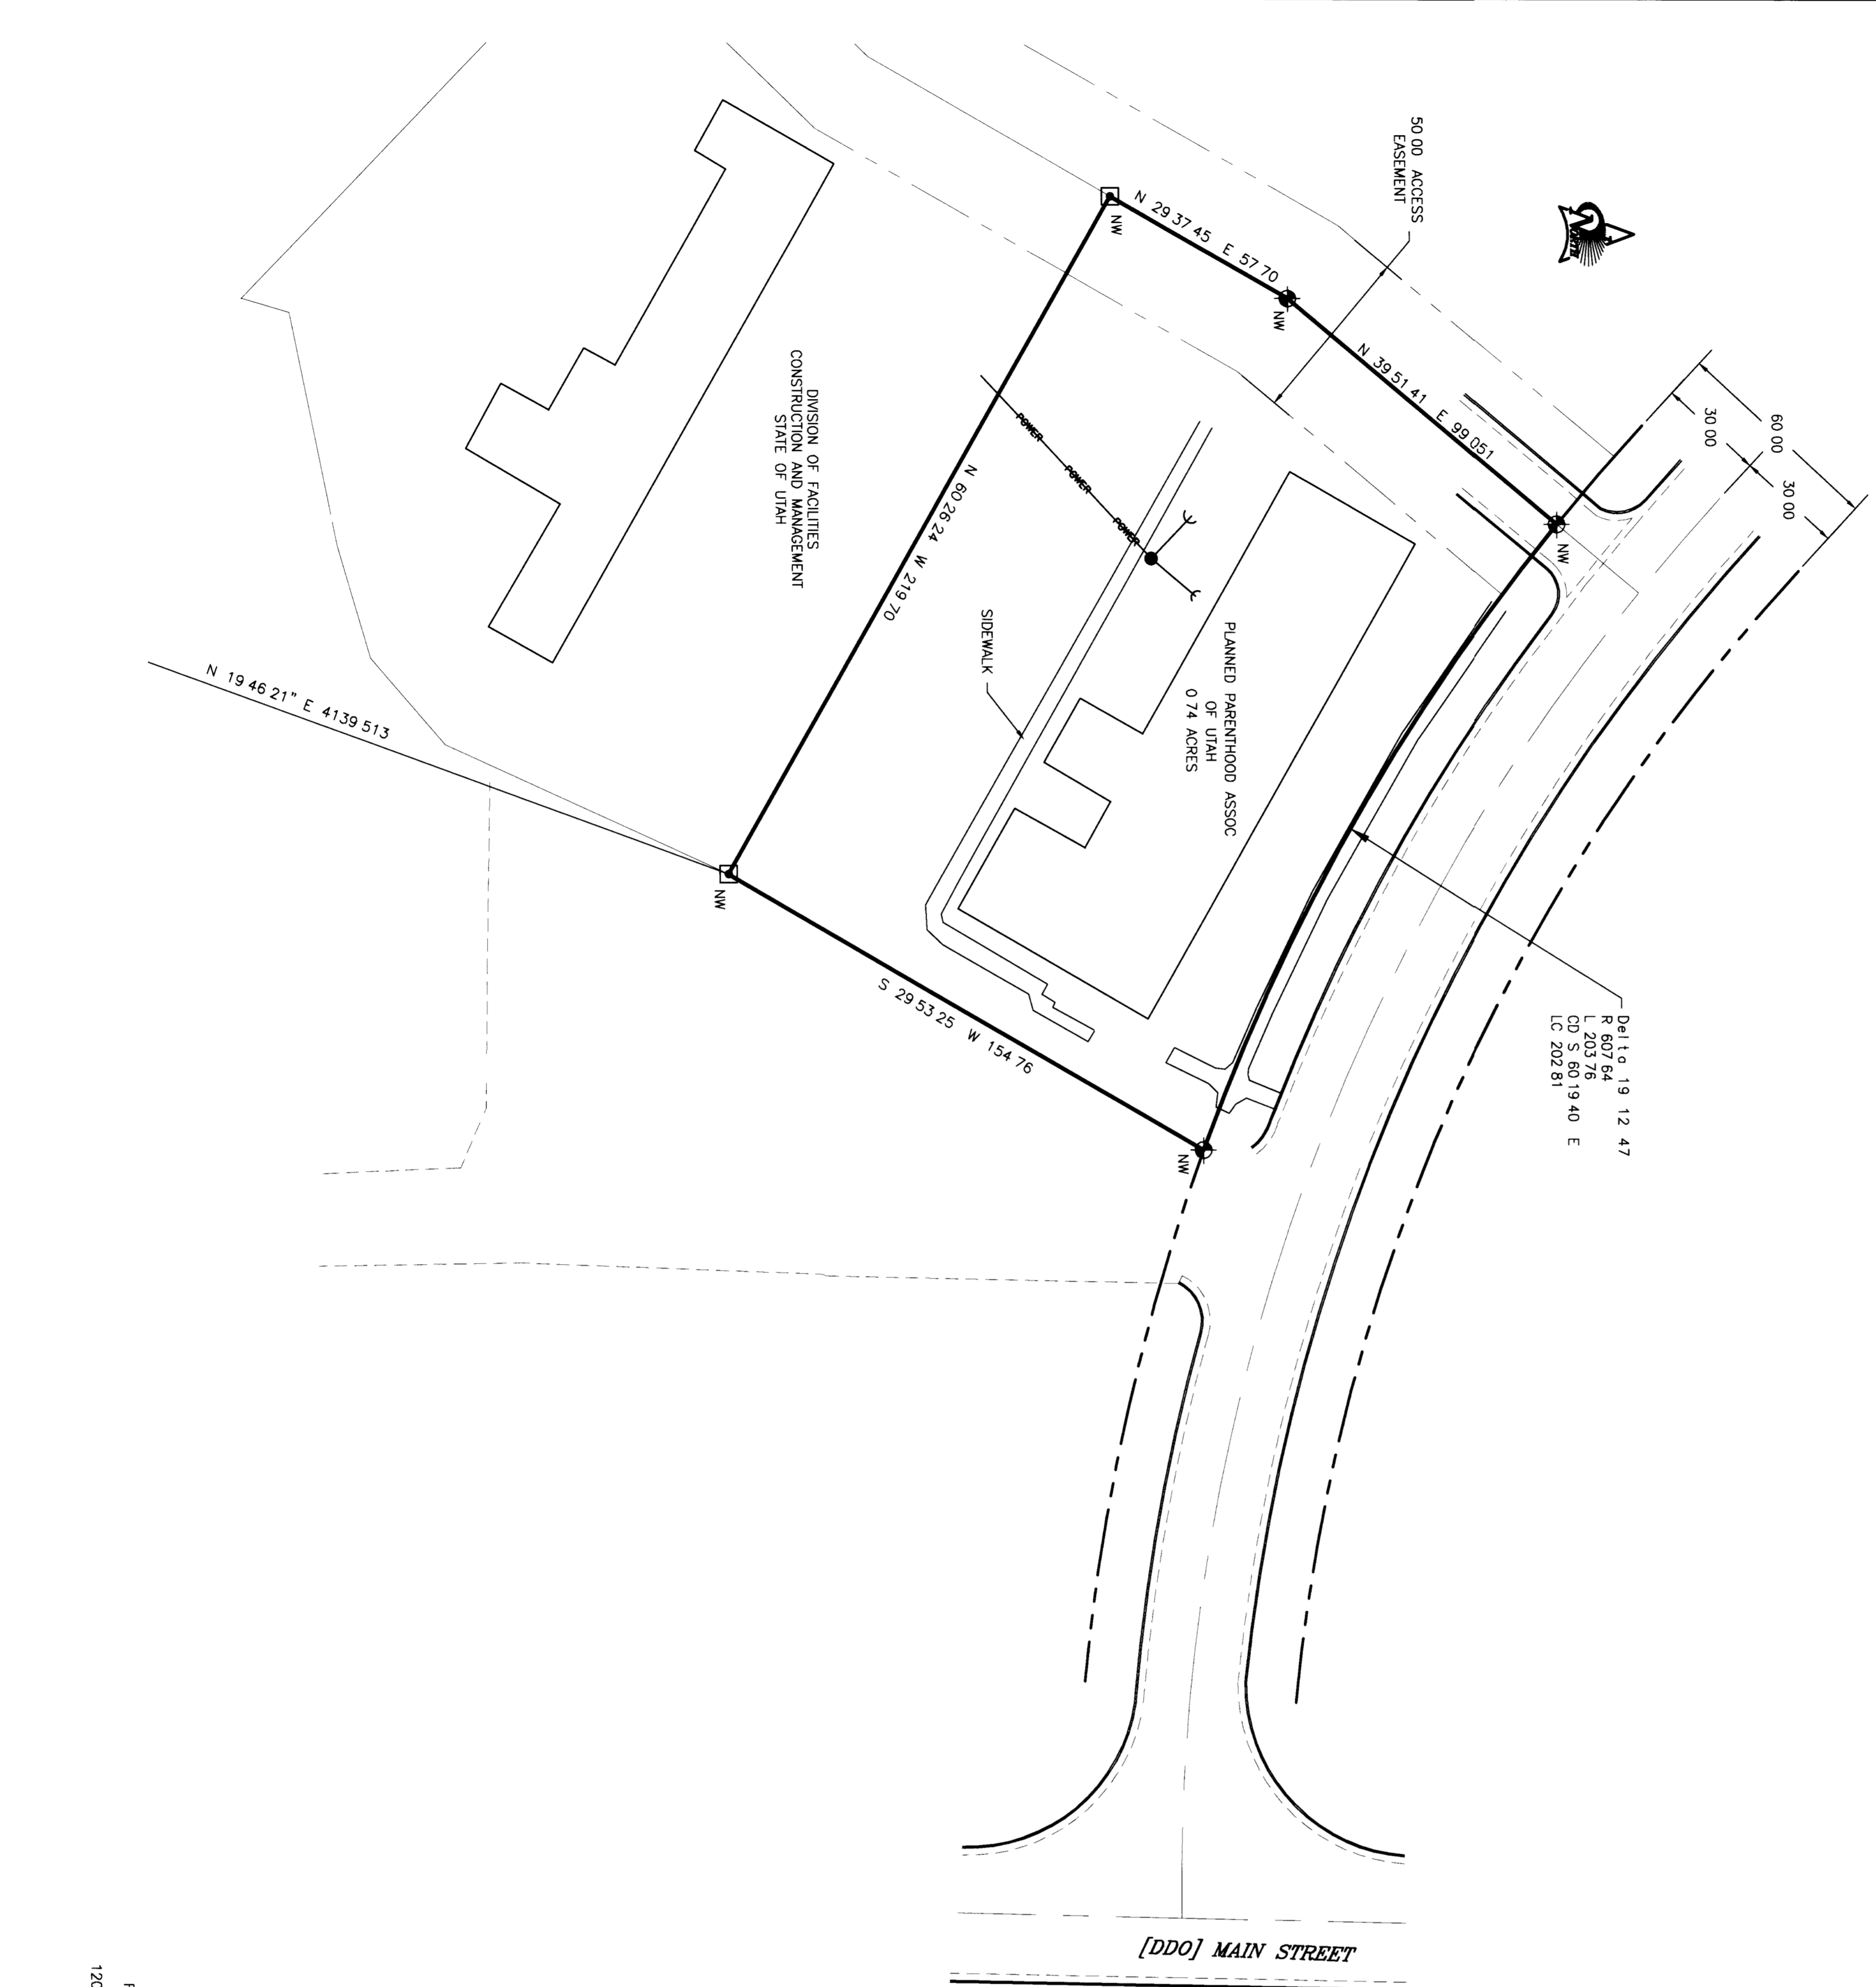

R.F.U.E.V.E.T.
SEP 4 1999

1-12

REVISIONS

Table with 3 columns: NO., DATE, DESCRIPTION. Contains 3 rows of revision information.

SUNRISE ENGINEERING, INC.

CONSULTING ENGINEERS & LAND SURVEYORS
12227 SOUTH BUSINESS PARK DRIVE, SUITE 220
DRAWER, UTAH 84020



PLANNED PARENTHOOD ASSOC. OF UTAH

PROPERTY SURVEY AT DEFENCE DEPOT OGDEN, UTAH
SE QUARTER OF SECTION 18, TOWNSHIP 6 NORTH, RANGE 1 WEST, SALT LAKE MERIDIAN

Table with 4 columns: DATE, DRAWN BY, CHECK BY, SCALE. Contains 3 rows of drawing metadata.

002330