



WEBER COUNTY SURVEY OFFICE AUTOCAD DRAFTING SYSTEM - FILE-VECTOR

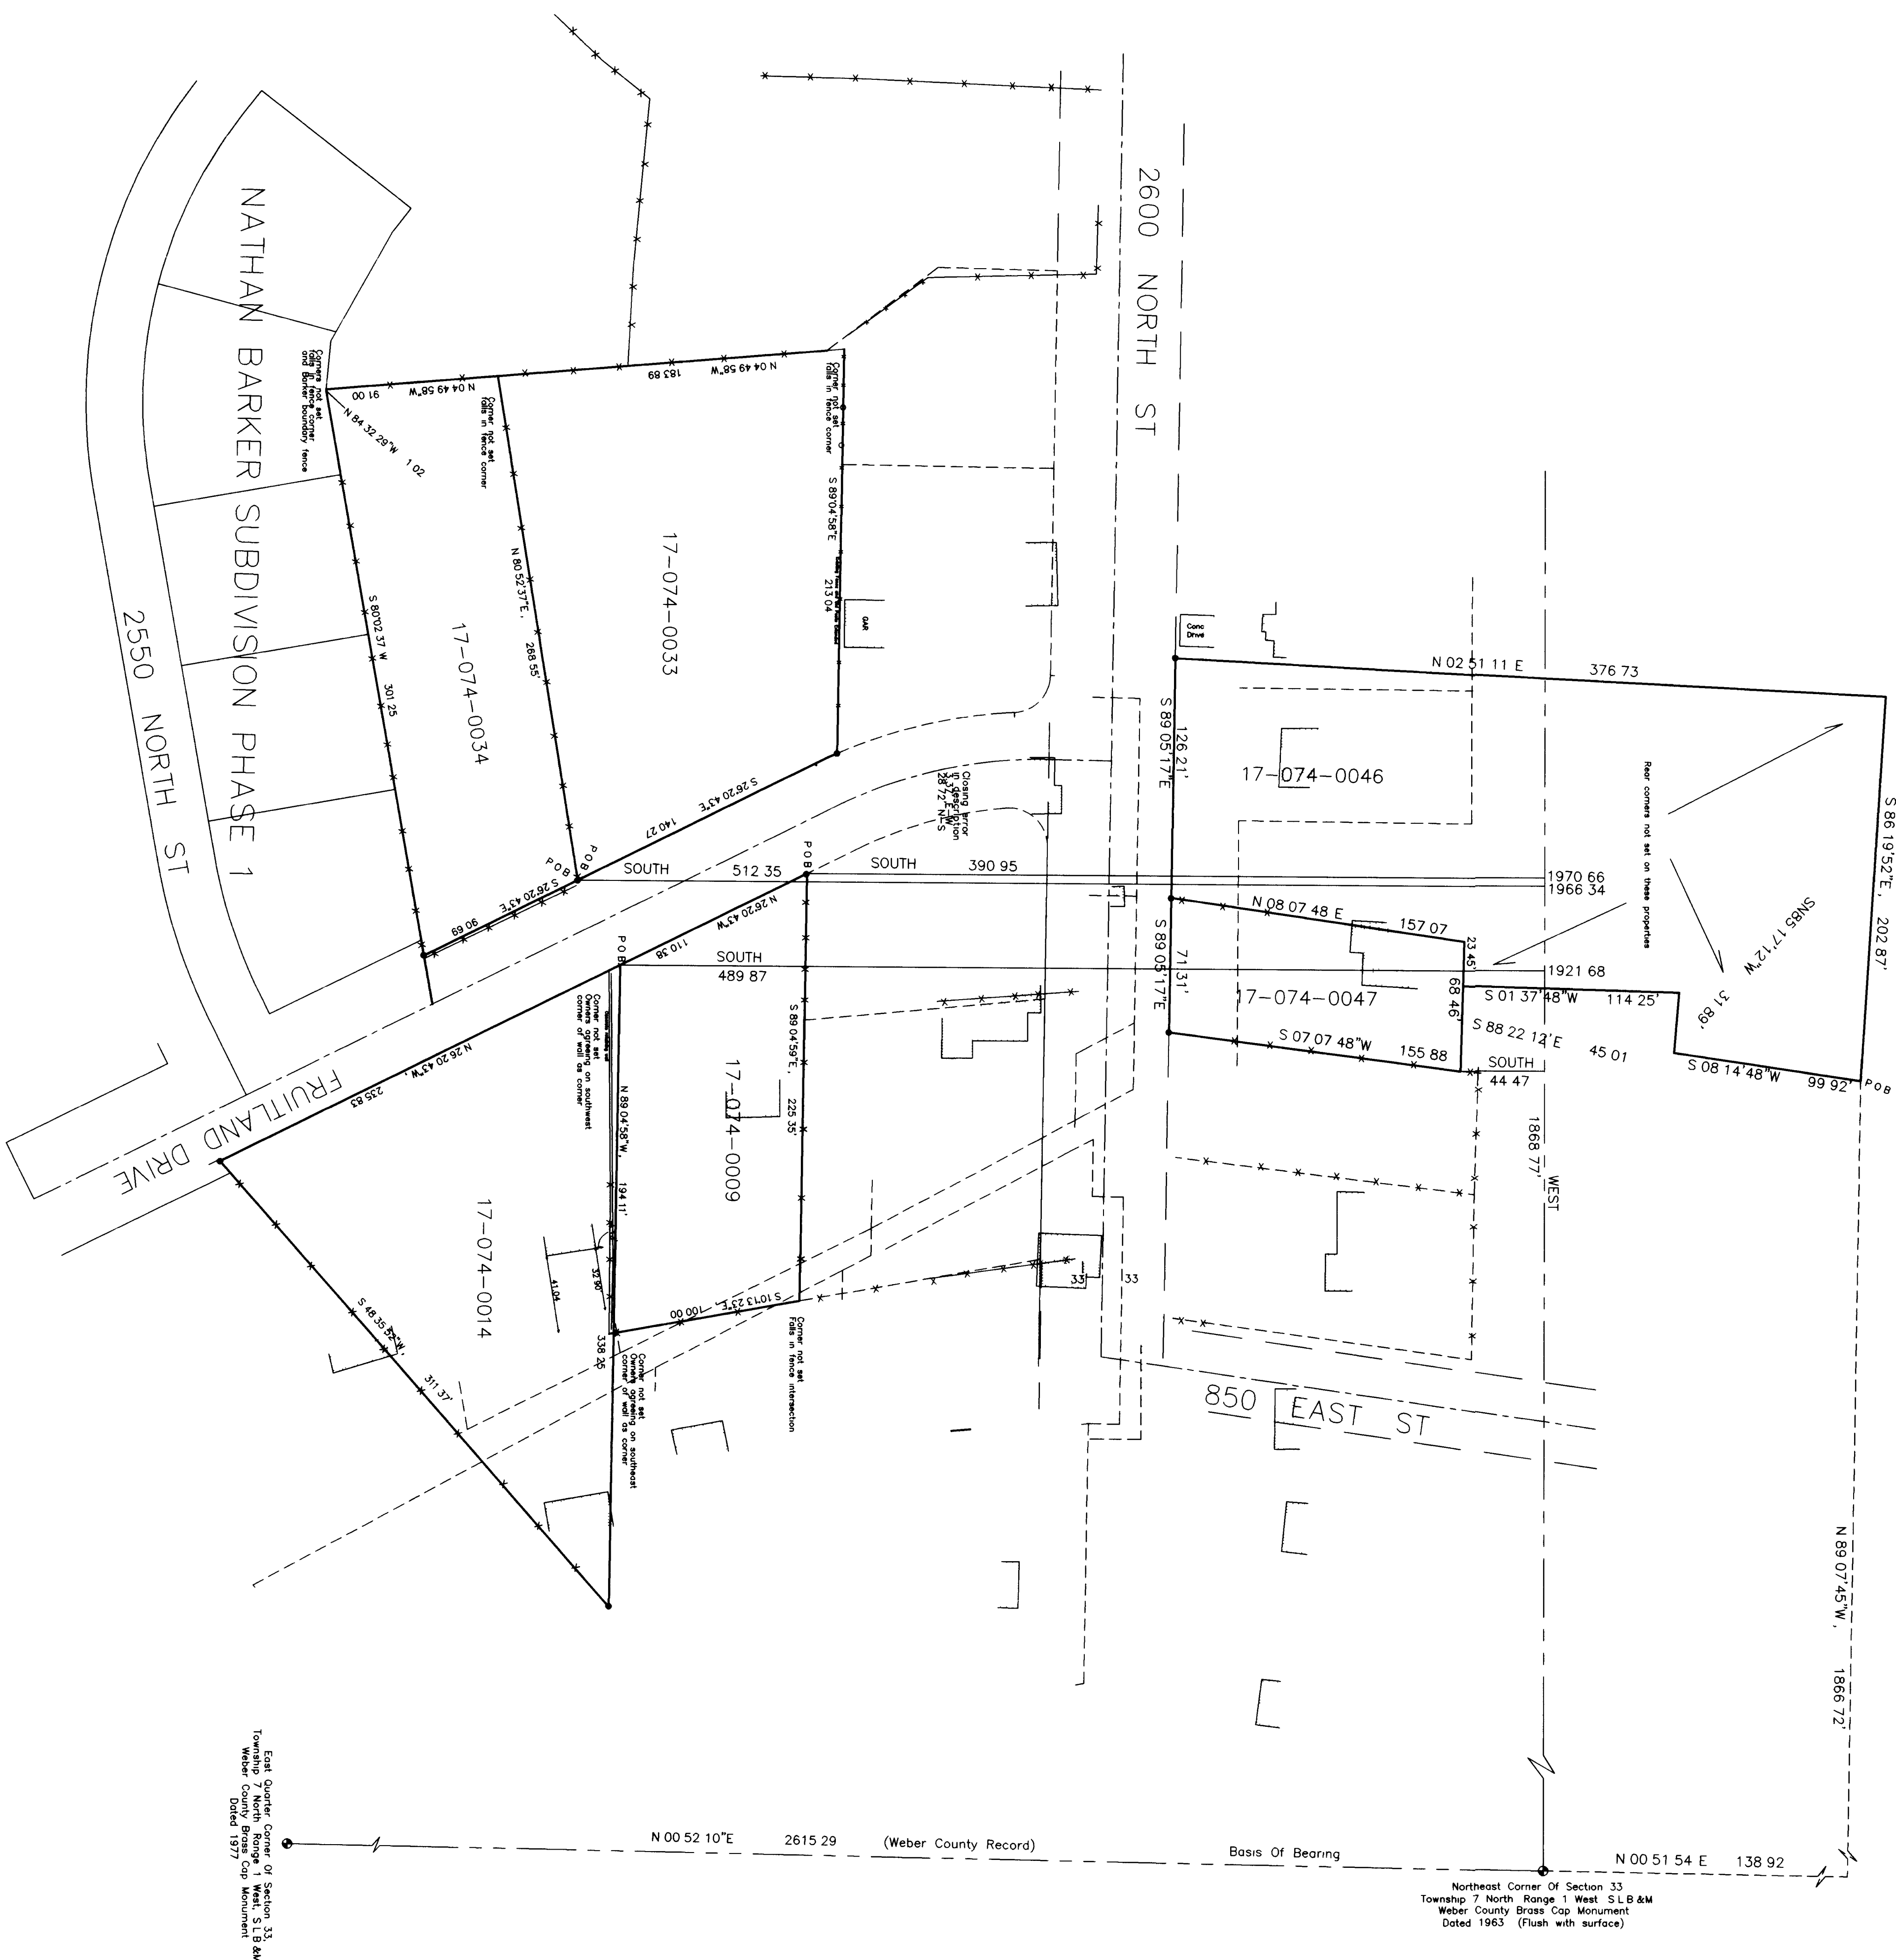



LEGEND
● SET #3 CORNER MARK, 24" LONG
○ CORNER MARK
--- EXISTING FENCE

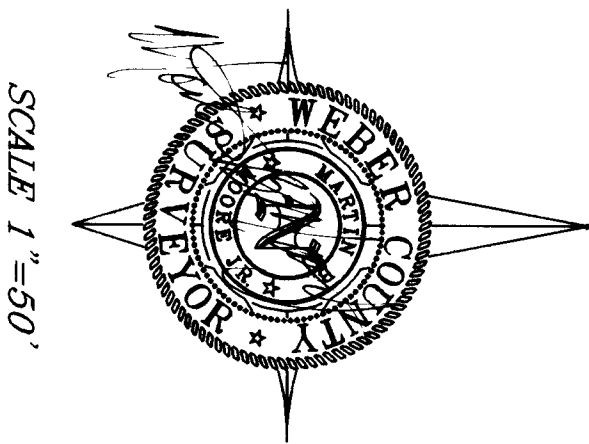

NARRATIVE



WEBER COUNTY SURVEYORS' CERTIFICATE
I, MARTIN B. MOORE, JR., HAVING BEEN DULY ELECTED AS THE SURVEYOR OF THE COUNTY OF WEBER, STATE OF UTAH, HAVE MADE A SURVEY OF THE PARCELS OF LAND SHOWN HEREON, THAT WERE CLAIMED BY THE PARTIES TO THIS SURVEY, AND THAT THIS PLAT IS AN ACCURATE RECORD OF THE SURVEY.
Witness my hand and the seal of my office at Ogden, Utah, this 1st day of October, 1997.


RECORD OF SURVEY
for
NORTH OGDEN CITY CORP.
PART OF THE NE 1/4 OF SECTION 33,
TOWNSHIP 7 NORTH, RANGE 1 WEST,
SALT LAKE BASE AND MERIDIAN

WEBER COUNTY SURVEYING
Surveyors: Ernest D. Rowley, Chief Deputy; Steven L. Johnson, Deputy; Ogden, Utah 84401
Survey Filing Number: 112535