


WEBER COUNTY SURVEY OFFICE - AUTOCAD® DRAWING SYSTEM - FILE# 2800WPROP

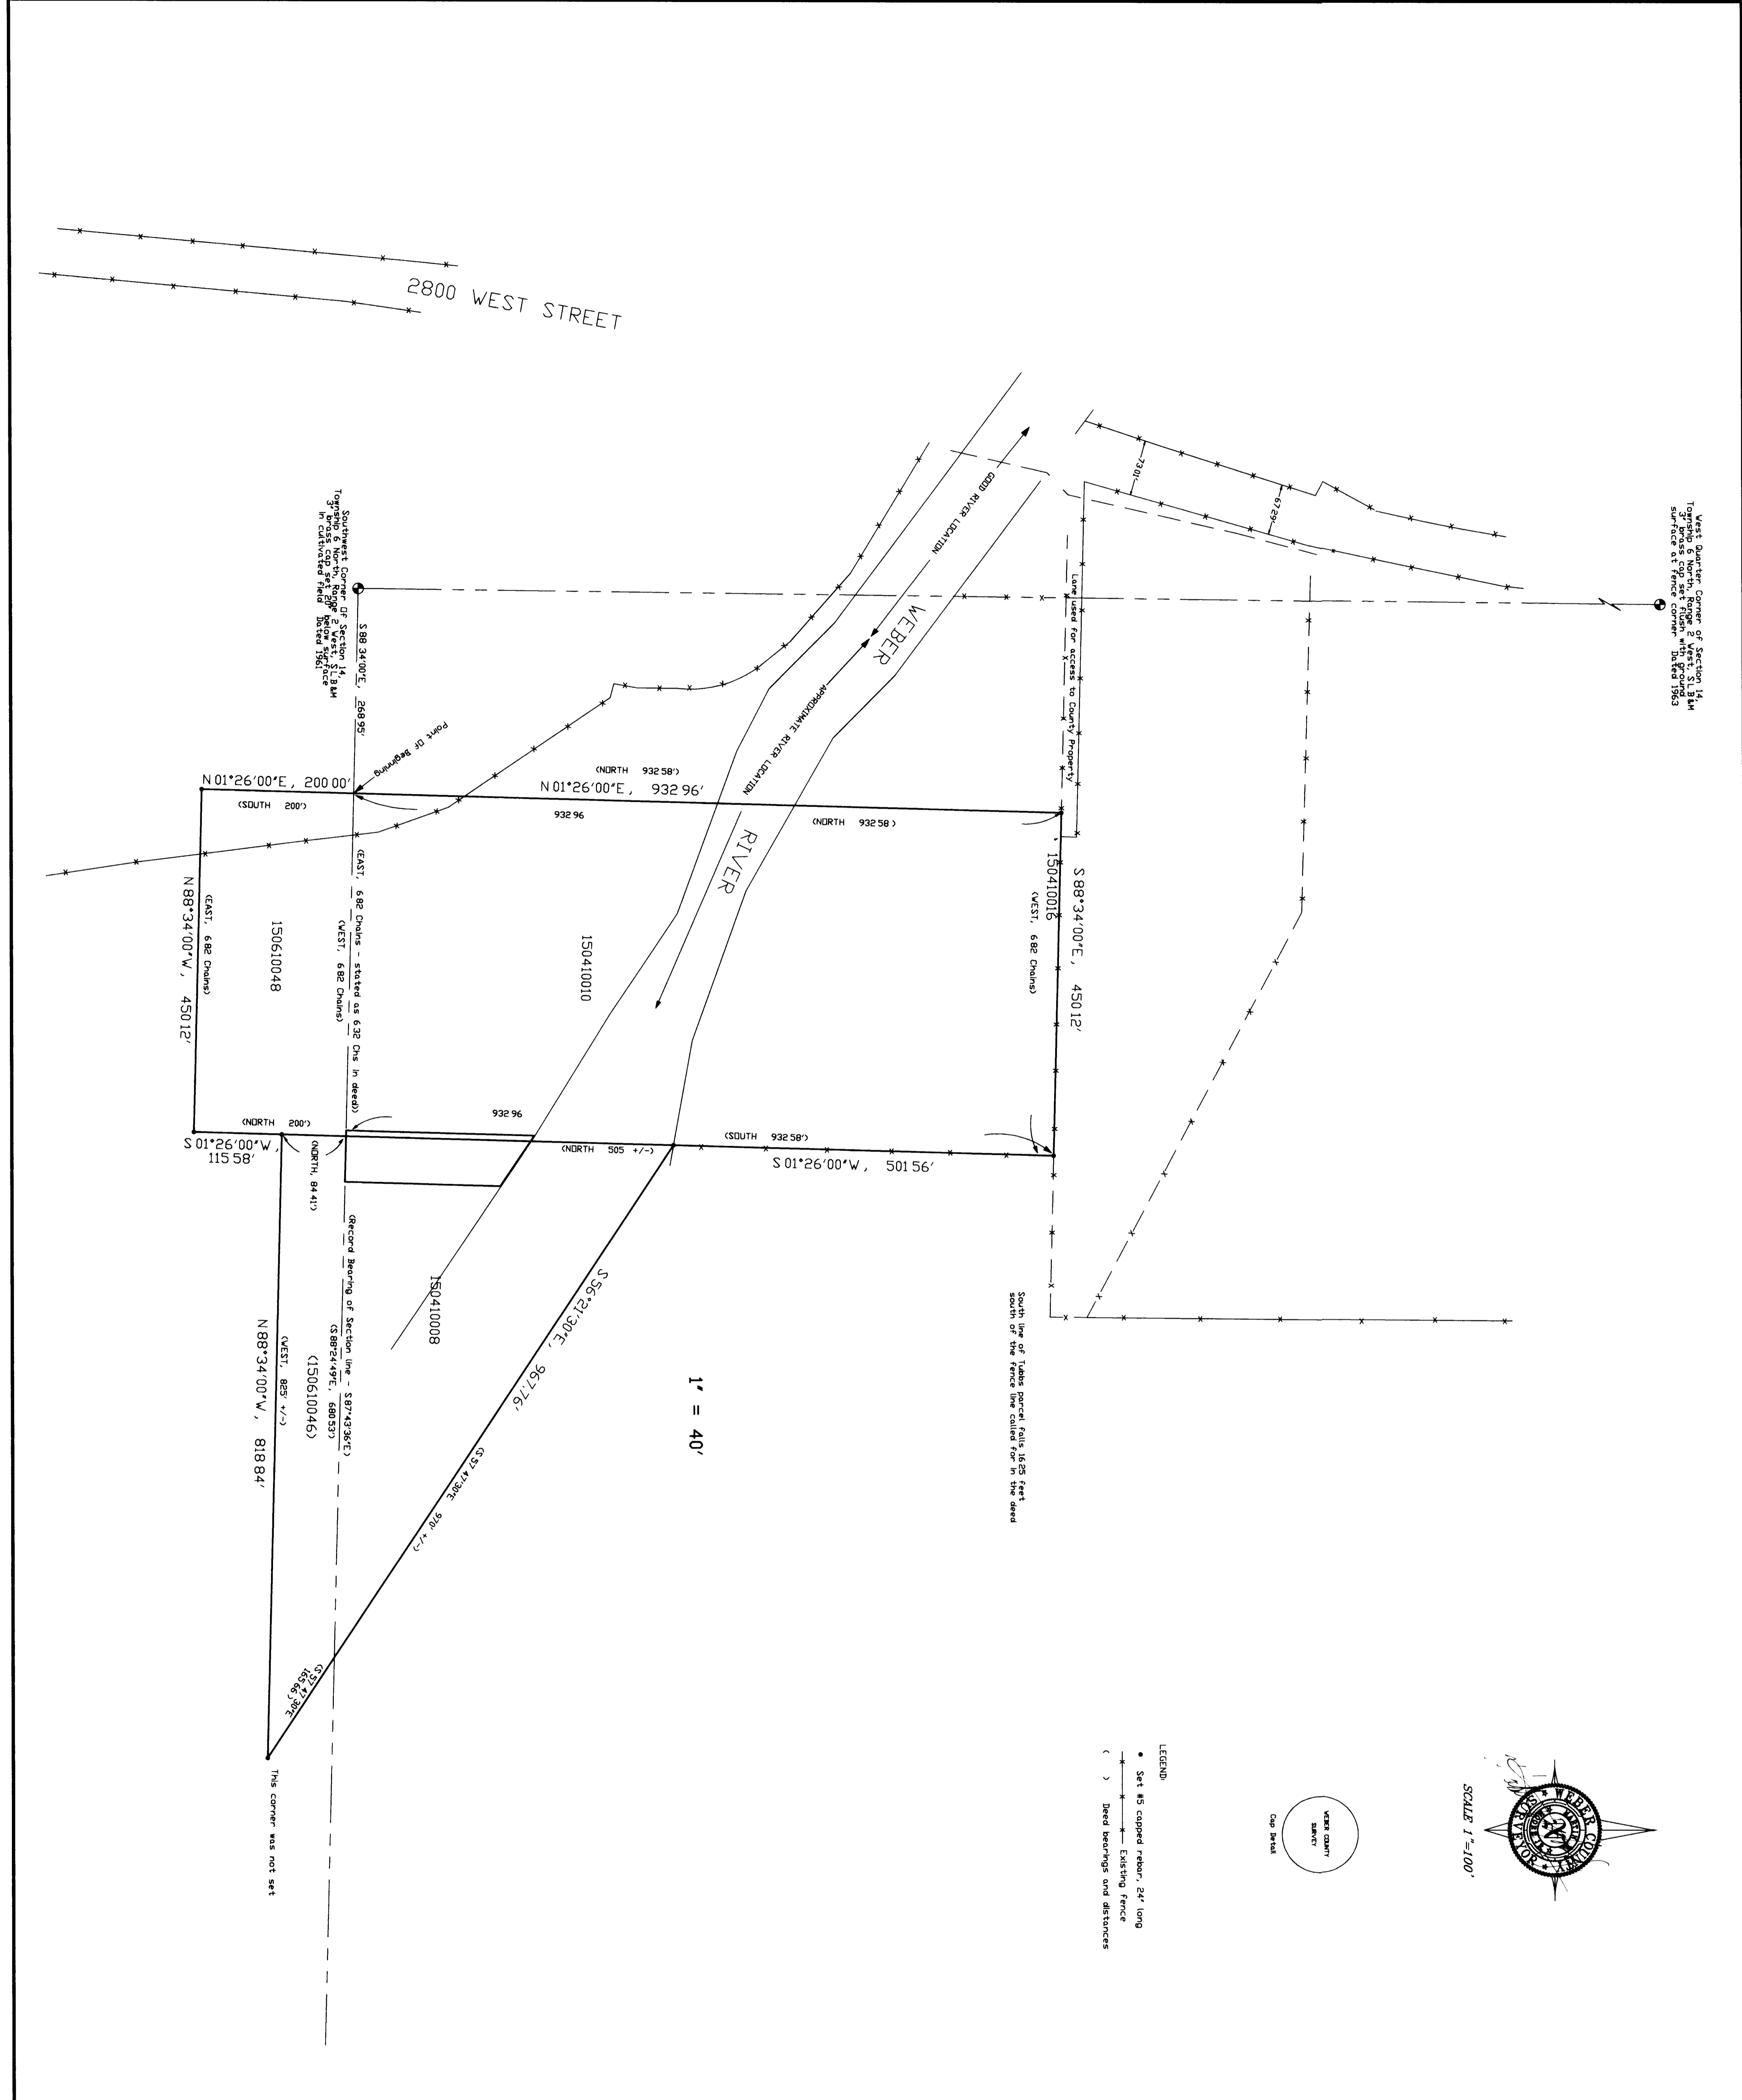

WEBER COUNTY SURVEYOR'S CERTIFICATE










RECEIVED

OCT 12 1999

Webber County Surveyor

2800 WEST - COUNTY PROPERTY

PART OF THE SW 1/4 OF SECTION 14 AND PART OF THE NW 1/4 OF SECTION 23 TOWNSHIP 6 NORTH, RANGE 2 WEST, SALT LAKE BASE AND MERIDIAN

Surveyed By: MW - BK
Survey Date: 5/20/287
Preliminary By: MW
Drawing Date: 6/12/97
Approved for Filing By: Ernest G. Roemer, Chief Deputy
Ernest G. Roemer, Chief Deputy
2280 Washington Blvd Room 211
Ogden, Utah 84401
(801) 389-6377

APPROVAL DATE: 6/13/97

002337

SURVEY FILING NUMBER