
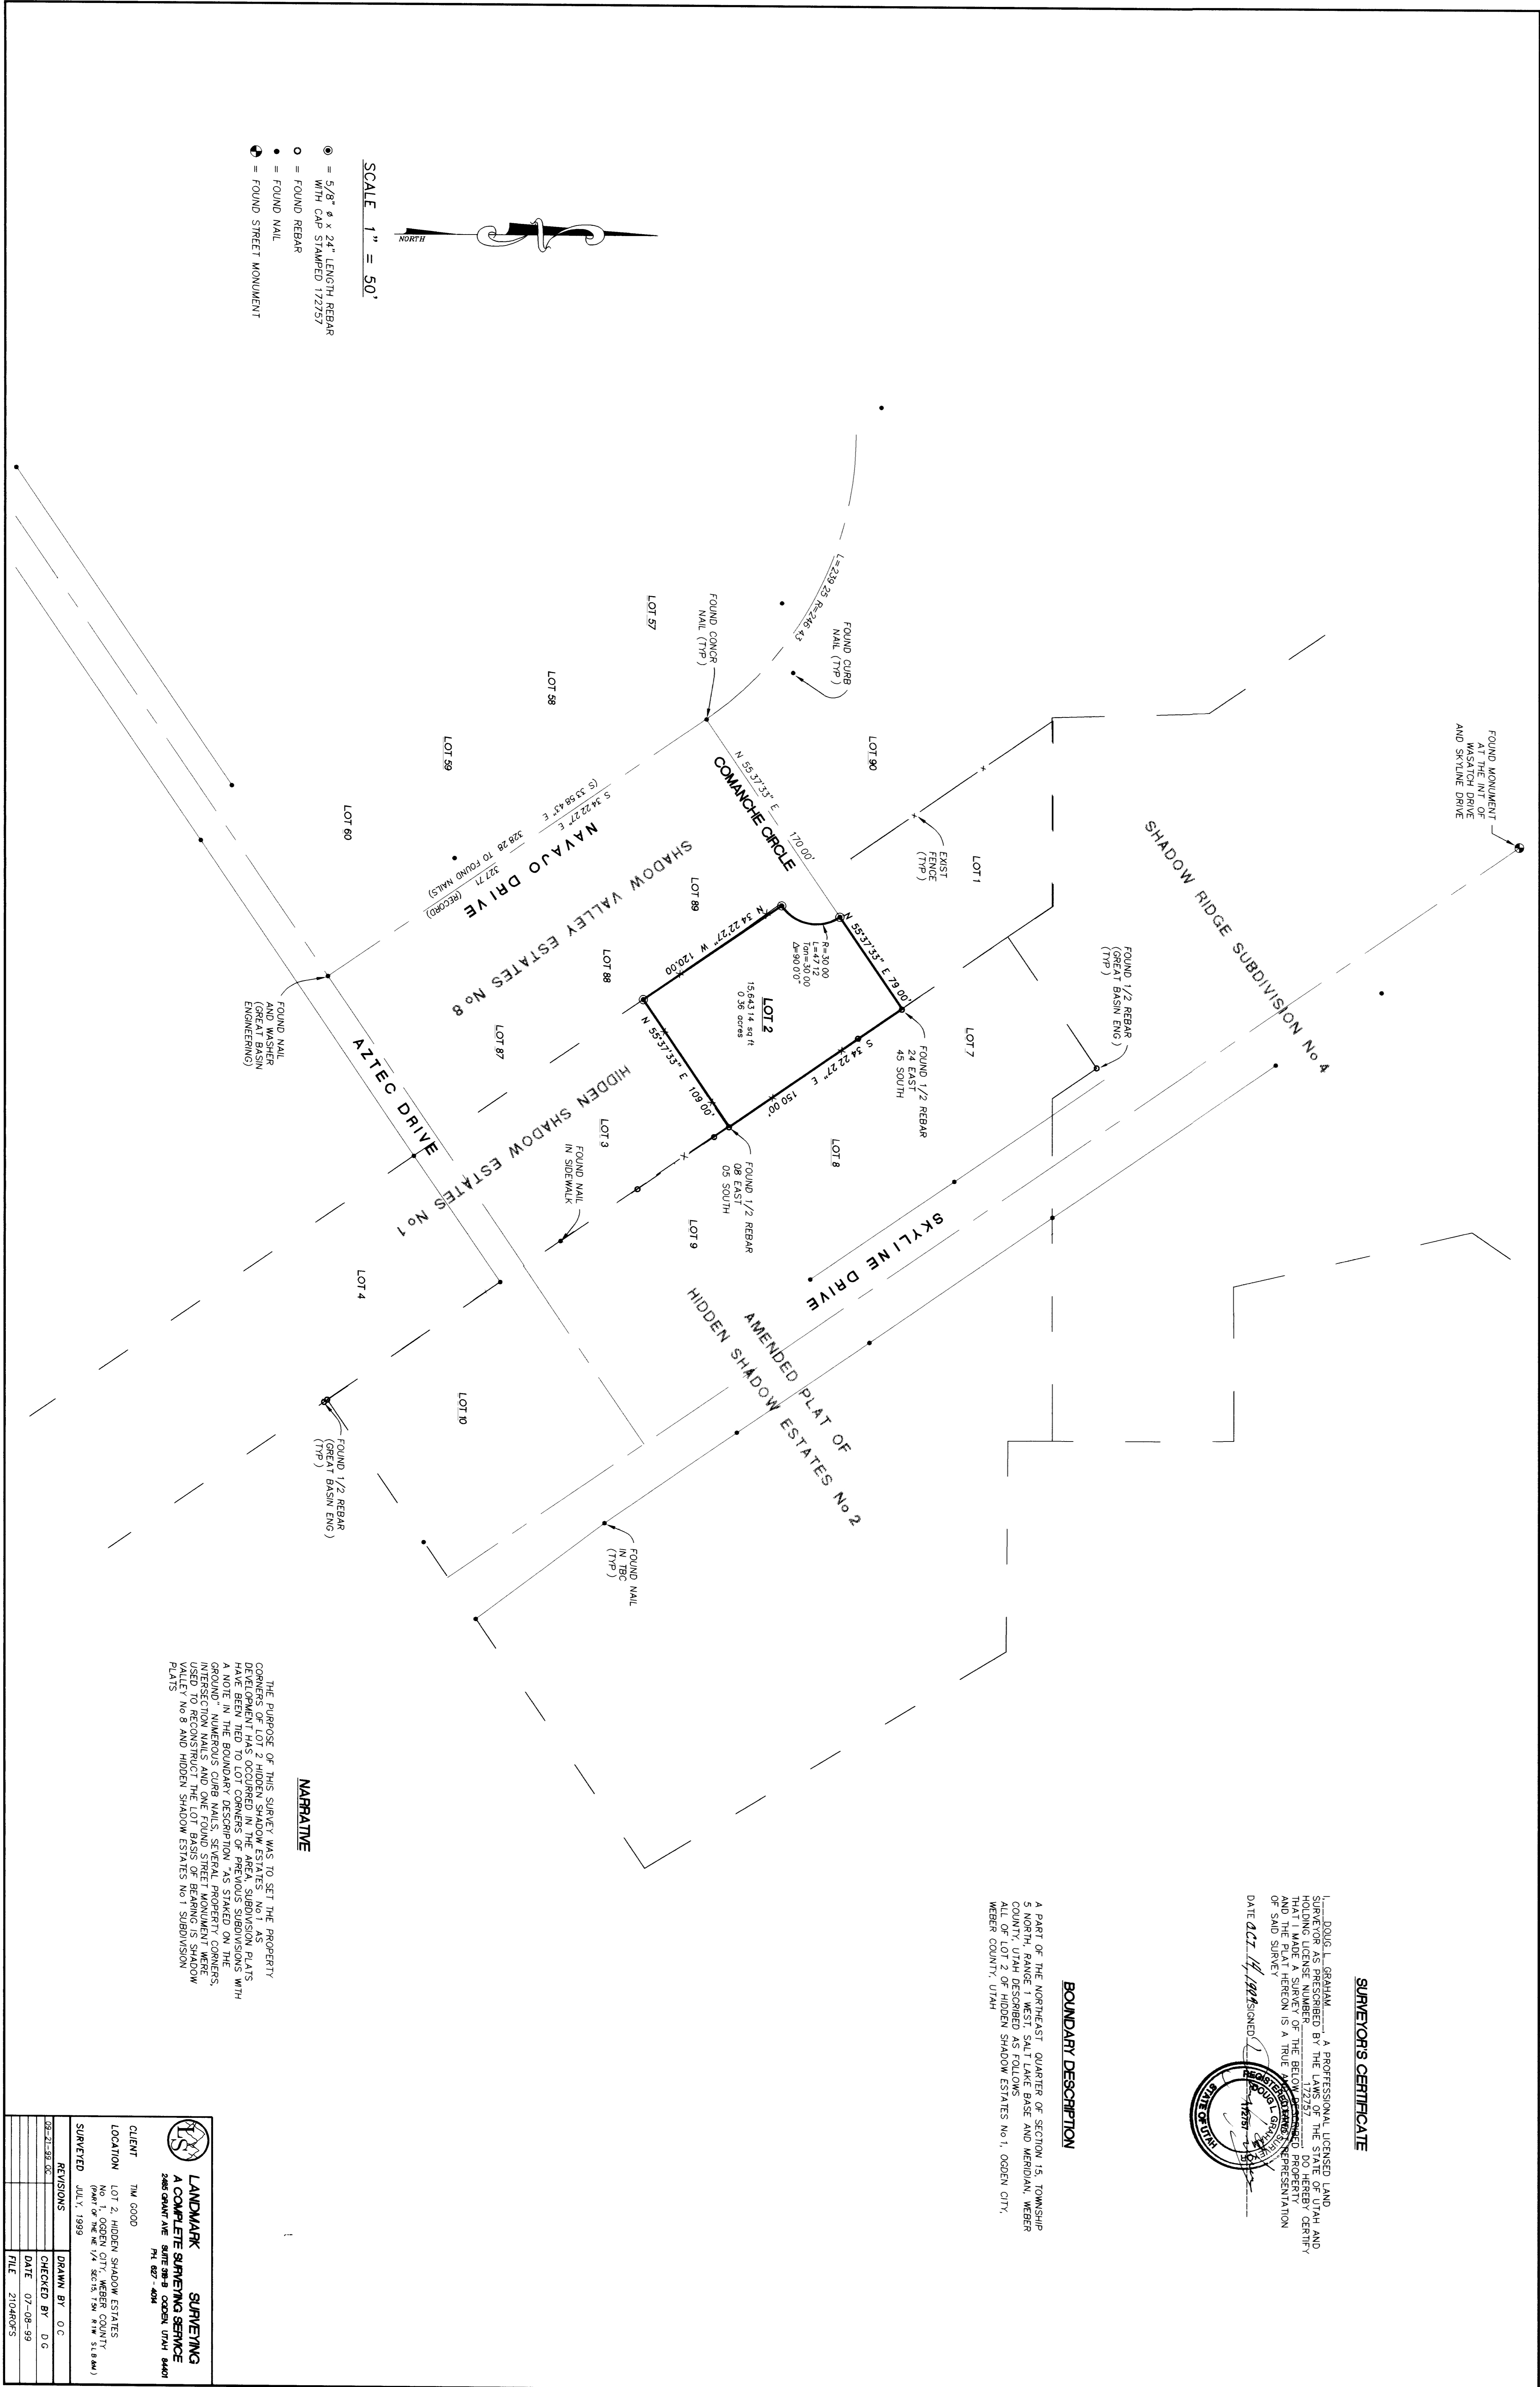


SCALE 1" = 50'
 ○ = FOUND REBAR
 ○ = FOUND NAIL
 ⊕ = FOUND STREET MONUMENT

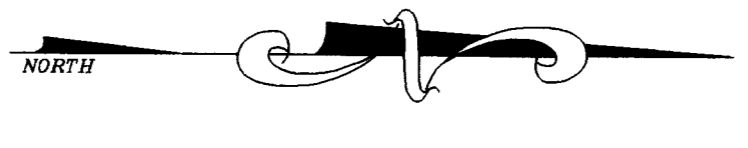

NARRATIVE
 THE PURPOSE OF THIS SURVEY WAS TO SET THE PROPERTY CORNERS OF LOT 2, HIDDEN SHADOW ESTATES, NO. 1, AS DEVELOPMENT HAS OCCURRED IN THE AREA. SUBDIVISION PLATS NO. 1, 2, 3, 1000.

BOUNDARY DESCRIPTION
 A PART OF THE NORTHEAST QUARTER OF SECTION 15, TOWNSHIP 5 NORTH, RANGE 1 WEST, SALT LAKE BASE AND MERIDIAN, WEBER COUNTY, UTAH DESCRIBED AS FOLLOWS:

SURVEYOR'S CERTIFICATE

002341

CLIENT	TM GOOD
REVISIONS	

LANDMARK SURVEYING
 A COMPLETE SURVEYING SERVICE
