


I, JON R. HILL, A PROFESSIONAL LAND SURVEYOR ACCORDING TO THE LAWS OF THE STATE OF UTAH, DO CERTIFY THAT I HAVE SURVEYED THE BOUNDARIES SHOWN ON THIS PLAT AND THAT THE CORNERS AND MONUMENTS SHOWN ON THE GROUND AS SHOWN ON THE DRAWING.

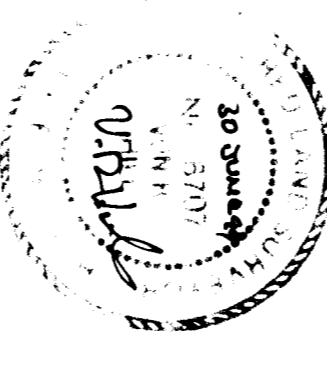

BOUNDARY DESCRIPTION:
 PHASE 1, POWDER RIDGE CONDOMINIUMS, PART OF SECTION 6, TOWNSHIP 7 NORTH, RANGE 2 EAST, SALT LAKE BASE AND MERIDIAN, WEBER COUNTY, UTAH
 INCLUDES ALL EXCEPTIONS PARCELS (X-4)

ABSTRACT:
 THE PURPOSE OF THE SURVEY WAS TO RE-ESTABLISH THE PROPERTY CORNERS FOR ALL PARCELS SHOWN ON THE PLAT. THE MONUMENTS SHOWN AND THE BUILDING CORNERS SHOWN ON THE PLAT ARE THE MONUMENTS AND BUILDING CORNERS SHOWN ON THE PLAT. 

LEGEND
 ● SET REBAR AND CAP HIA # 6707

BRASS CAP SHOWN ON PLAT UNDER DIRT - IT IS UNKNOWN IF IT IS STILL IN.

DATE	99-216
SHEET	OF 002354
DATE	6/21/99
DATE	6/21/99
DATE	6/21/99

SURVEY REQUESTED BY
GLEN SAXTON
 POWDER RIDGE CONDOMINIUMS PHASE 1, LOCATED IN THE SOUTH 1/2 OF SECTION 6, T7N, R2E, SLB&M
 WEBER COUNTY, UTAH

Hill, Jamison and Associates, Inc.
 Engineering and Surveying
 181 North 200 West, Bountiful, Utah 84010 (801)298-2236

002354