

DRAWING NUMBER  
002356

PLAN HOLD CORPORATION • IRVINE, CALIFORNIA  
REORDER BY NUMBER 075AR

DRAWING NUMBER  
002356



PLAN HOLD CORPORATION • IRVINE, CALIFORNIA  
REORDER BY NUMBER 075AR

DRAWING NUMBER  
002356

PLAN HOLD CORPORATION • IRVINE, CALIFORNIA  
REORDER BY NUMBER 075AR

DRAWING NUMBER  
002356

PLAN HOLD CORPORATION • IRVINE, CALIFORNIA  
REORDER BY NUMBER 075AR

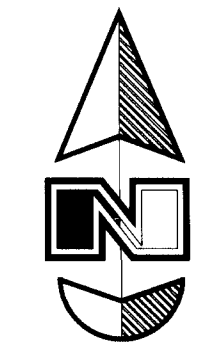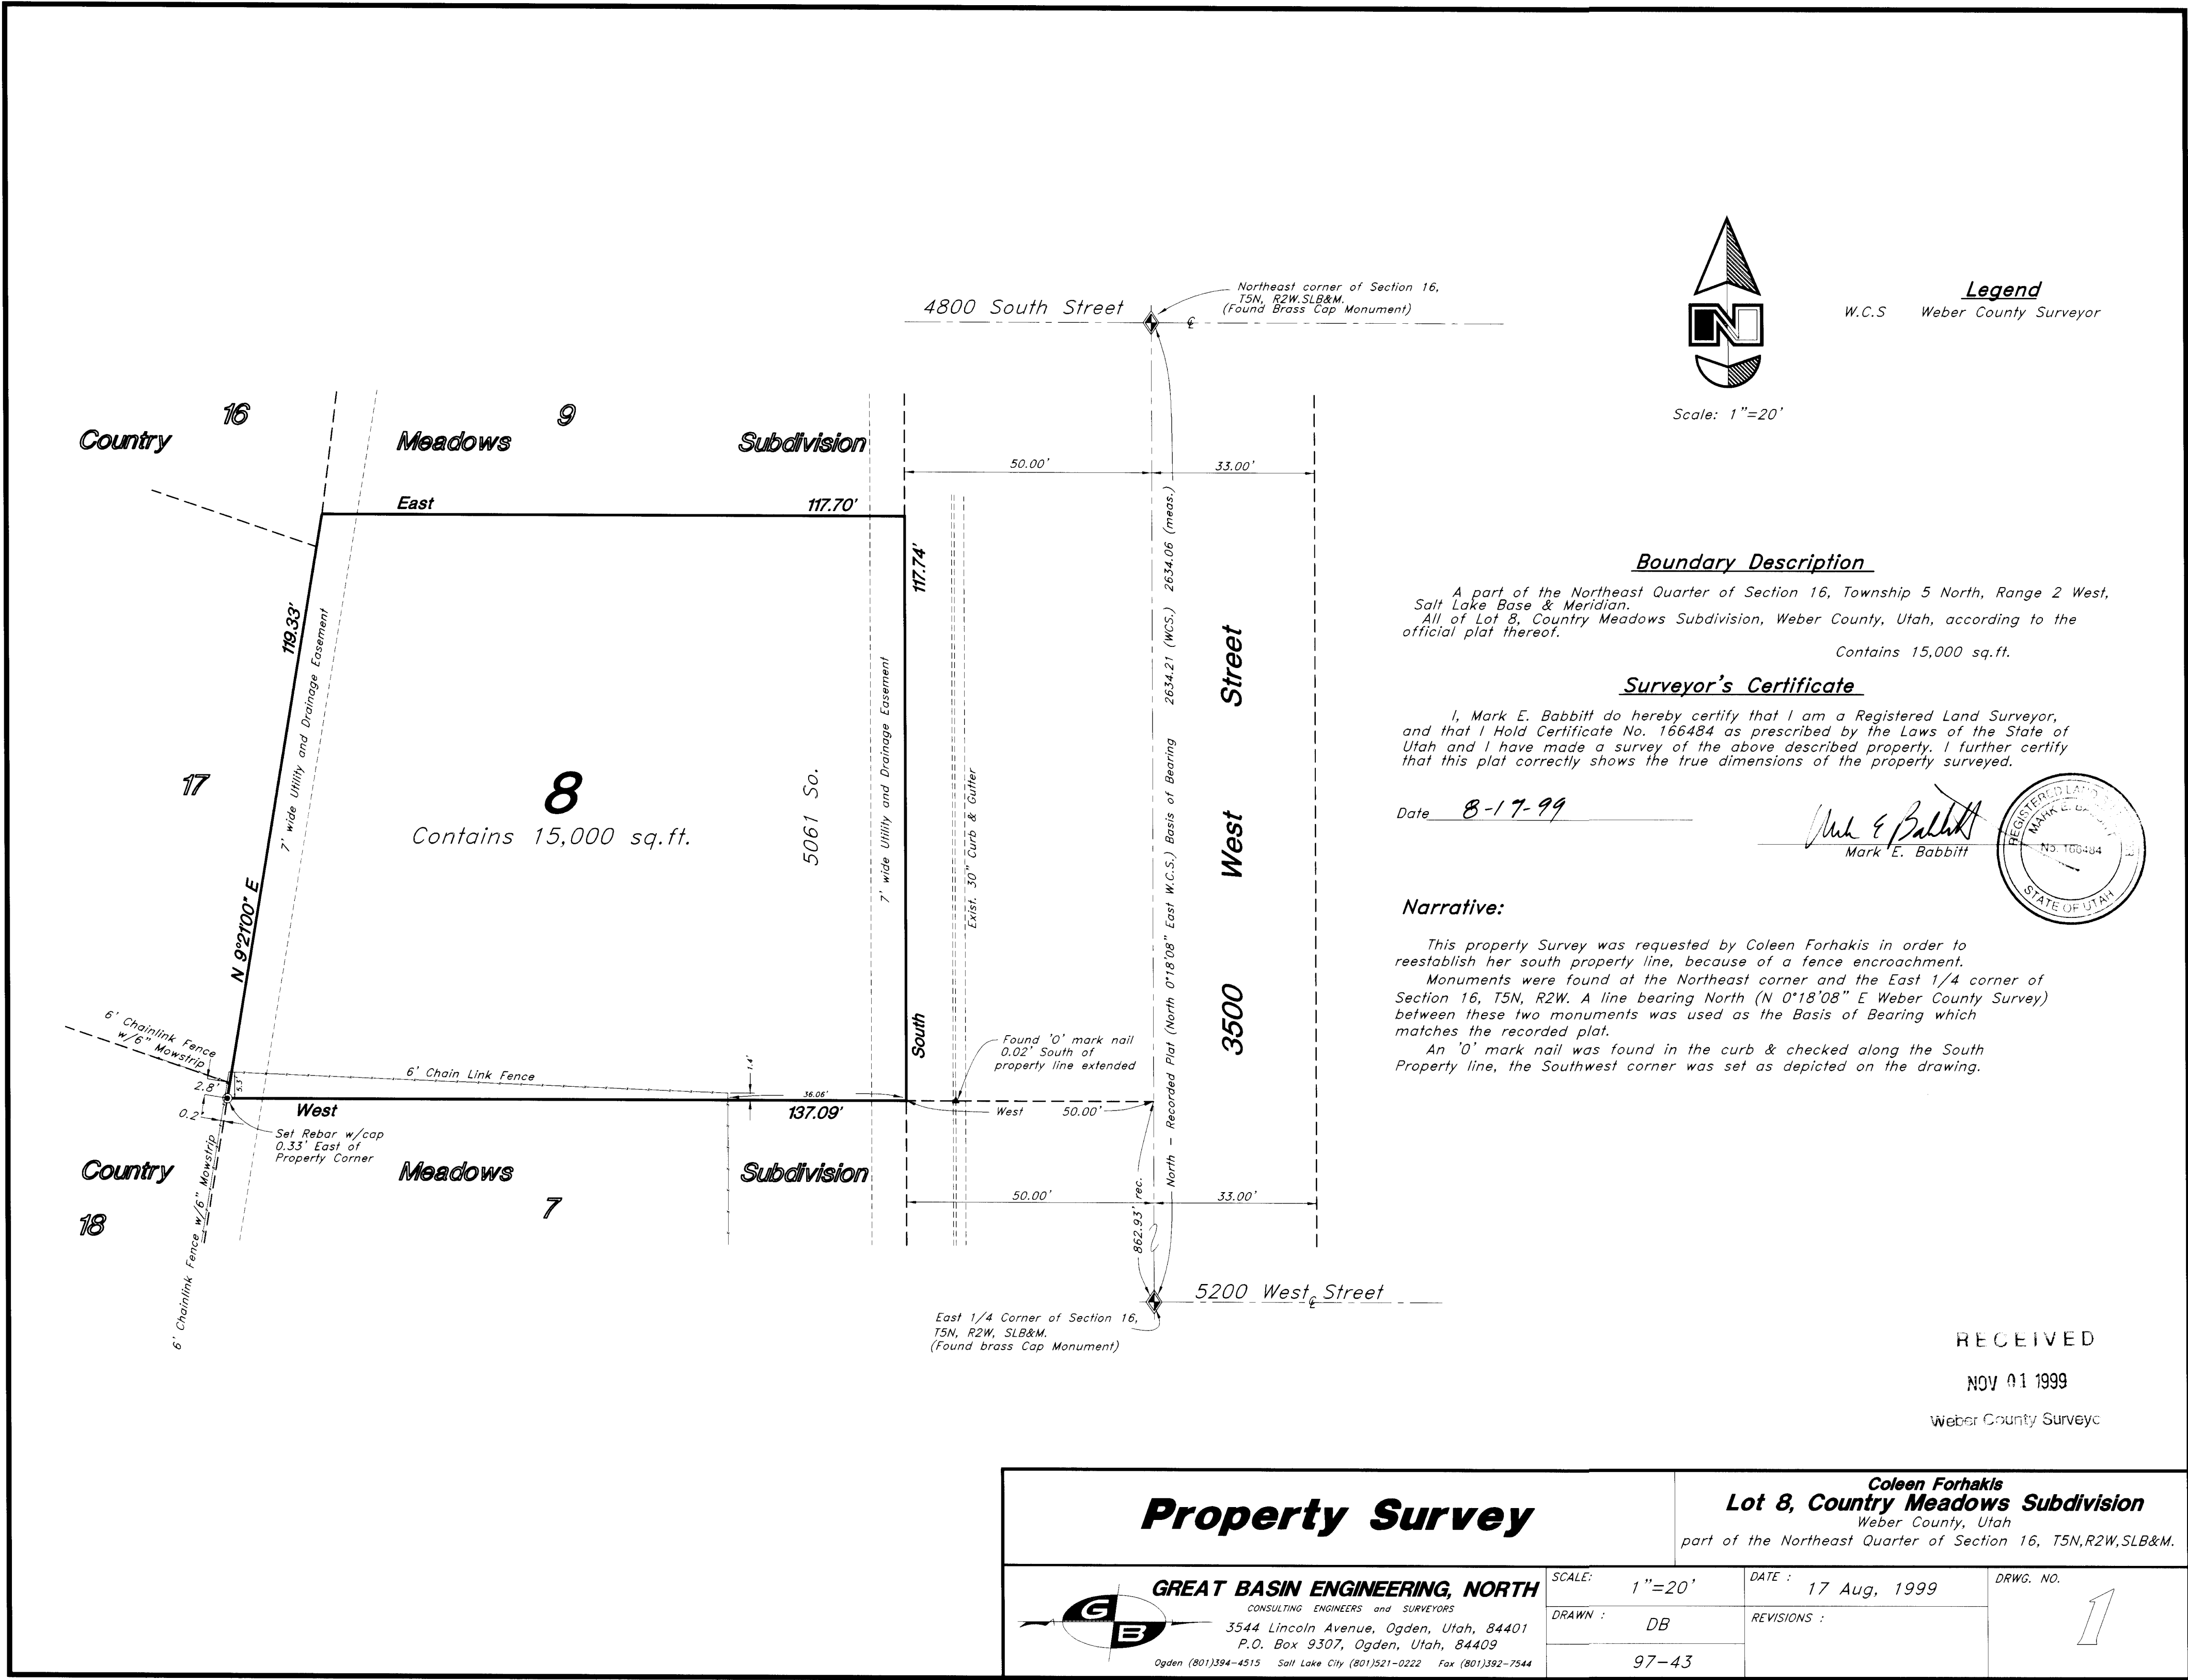

Scale: 1"=20'

**Legend**  
W.C.S. Weber County Surveyor

K:\ENGIN\DATA\DWG\97043\97-43.DWG Tue Aug 17 14:55:50 1999 ESL

002356

002356

RECEIVED  
NOV 01 1999  
Weber County Surveyor