DRAWING NUMBER 002363 PLAN HOLD CORPORATION • IRVINE, CALIFORNIA

REORDER BY NUMBER 075AR

DRAWING NUMBER 002363 PLAN HOLD CORPORATION • IRVINE, CALIFORNIA

REORDER BY NUMBER 075AR


DRAWING NUMBER 002363 PLAN HOLD CORPORATION • IRVINE, CALIFORNIA REORDER BY NUMBER 075AR

DRAWING NUMBER 002367

PLAN HOLD CORPORATION • IRVINE, CALIFORNIA

REORDER BY NUMBER 075AR

G: \ACAD\1999\99-3-75\99-3-75.dwg Tue Aug 24 11: 30: 49 1999 Greg

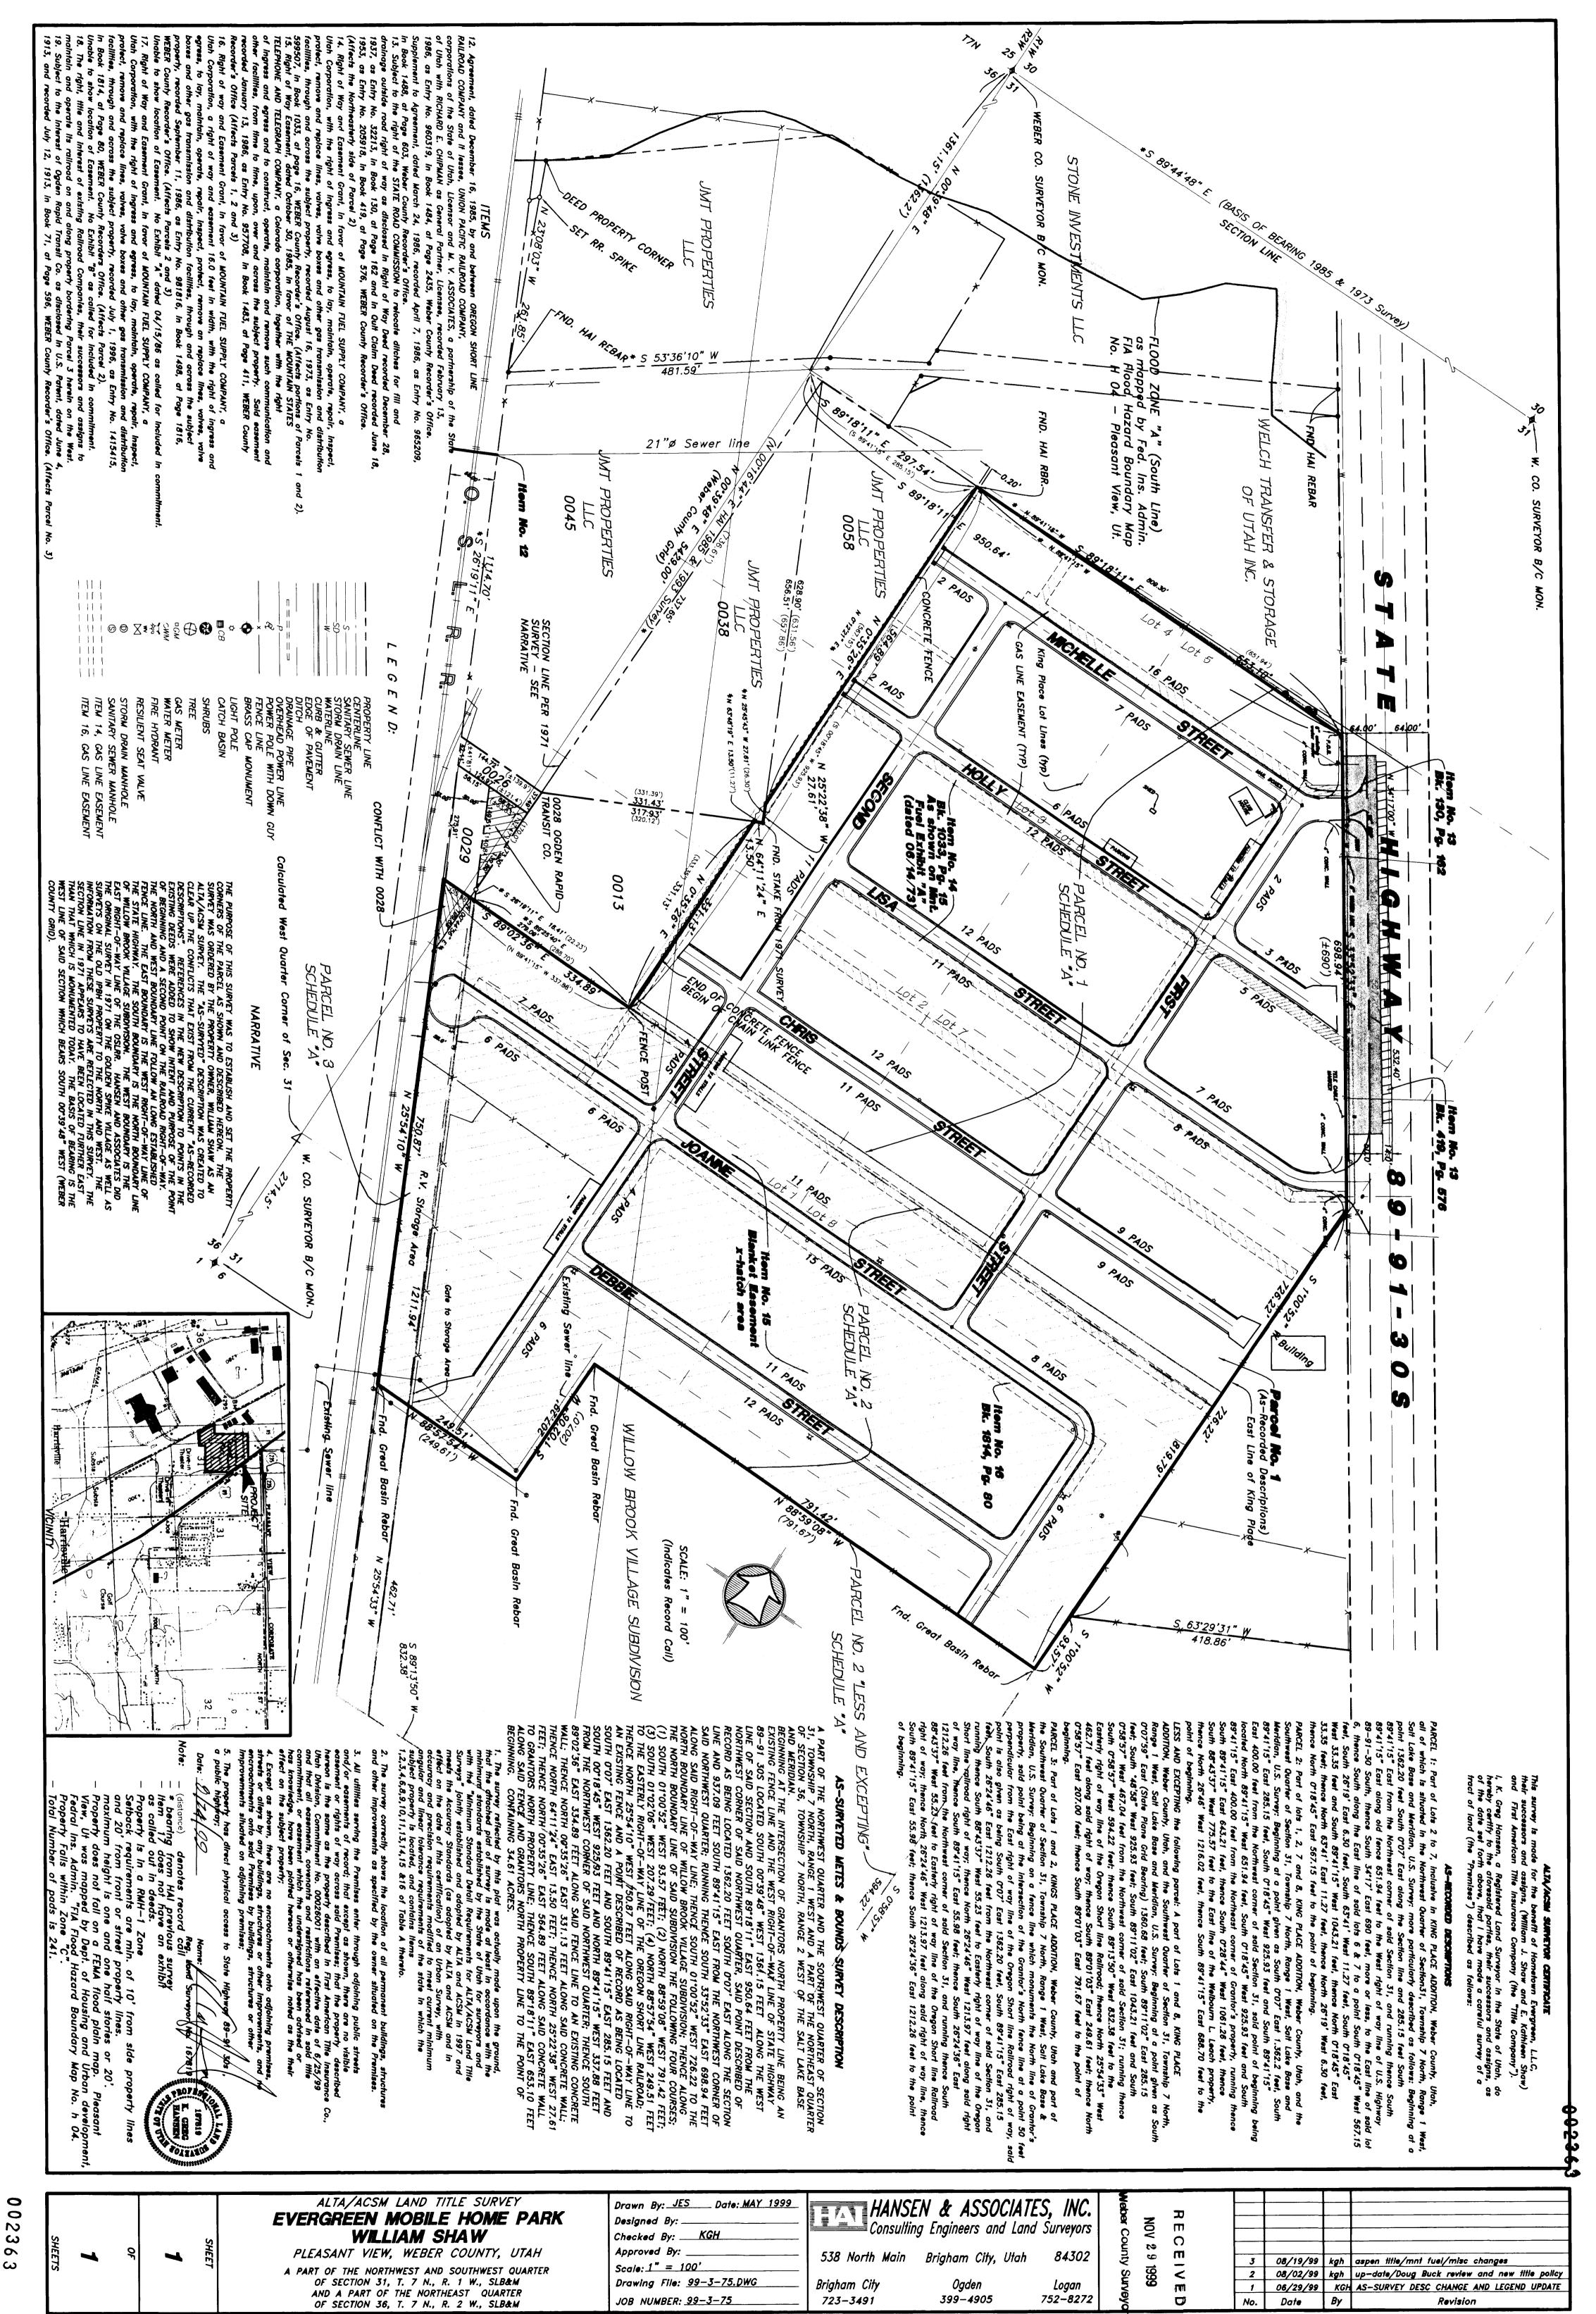

399-4905

723-3491

JOB NUMBER: 99-3-75