


9: LDR\KING\SHARED\3663\01-RAM\Survey.dwg wed Jan 05 08:18:04 2000 H.GUNN

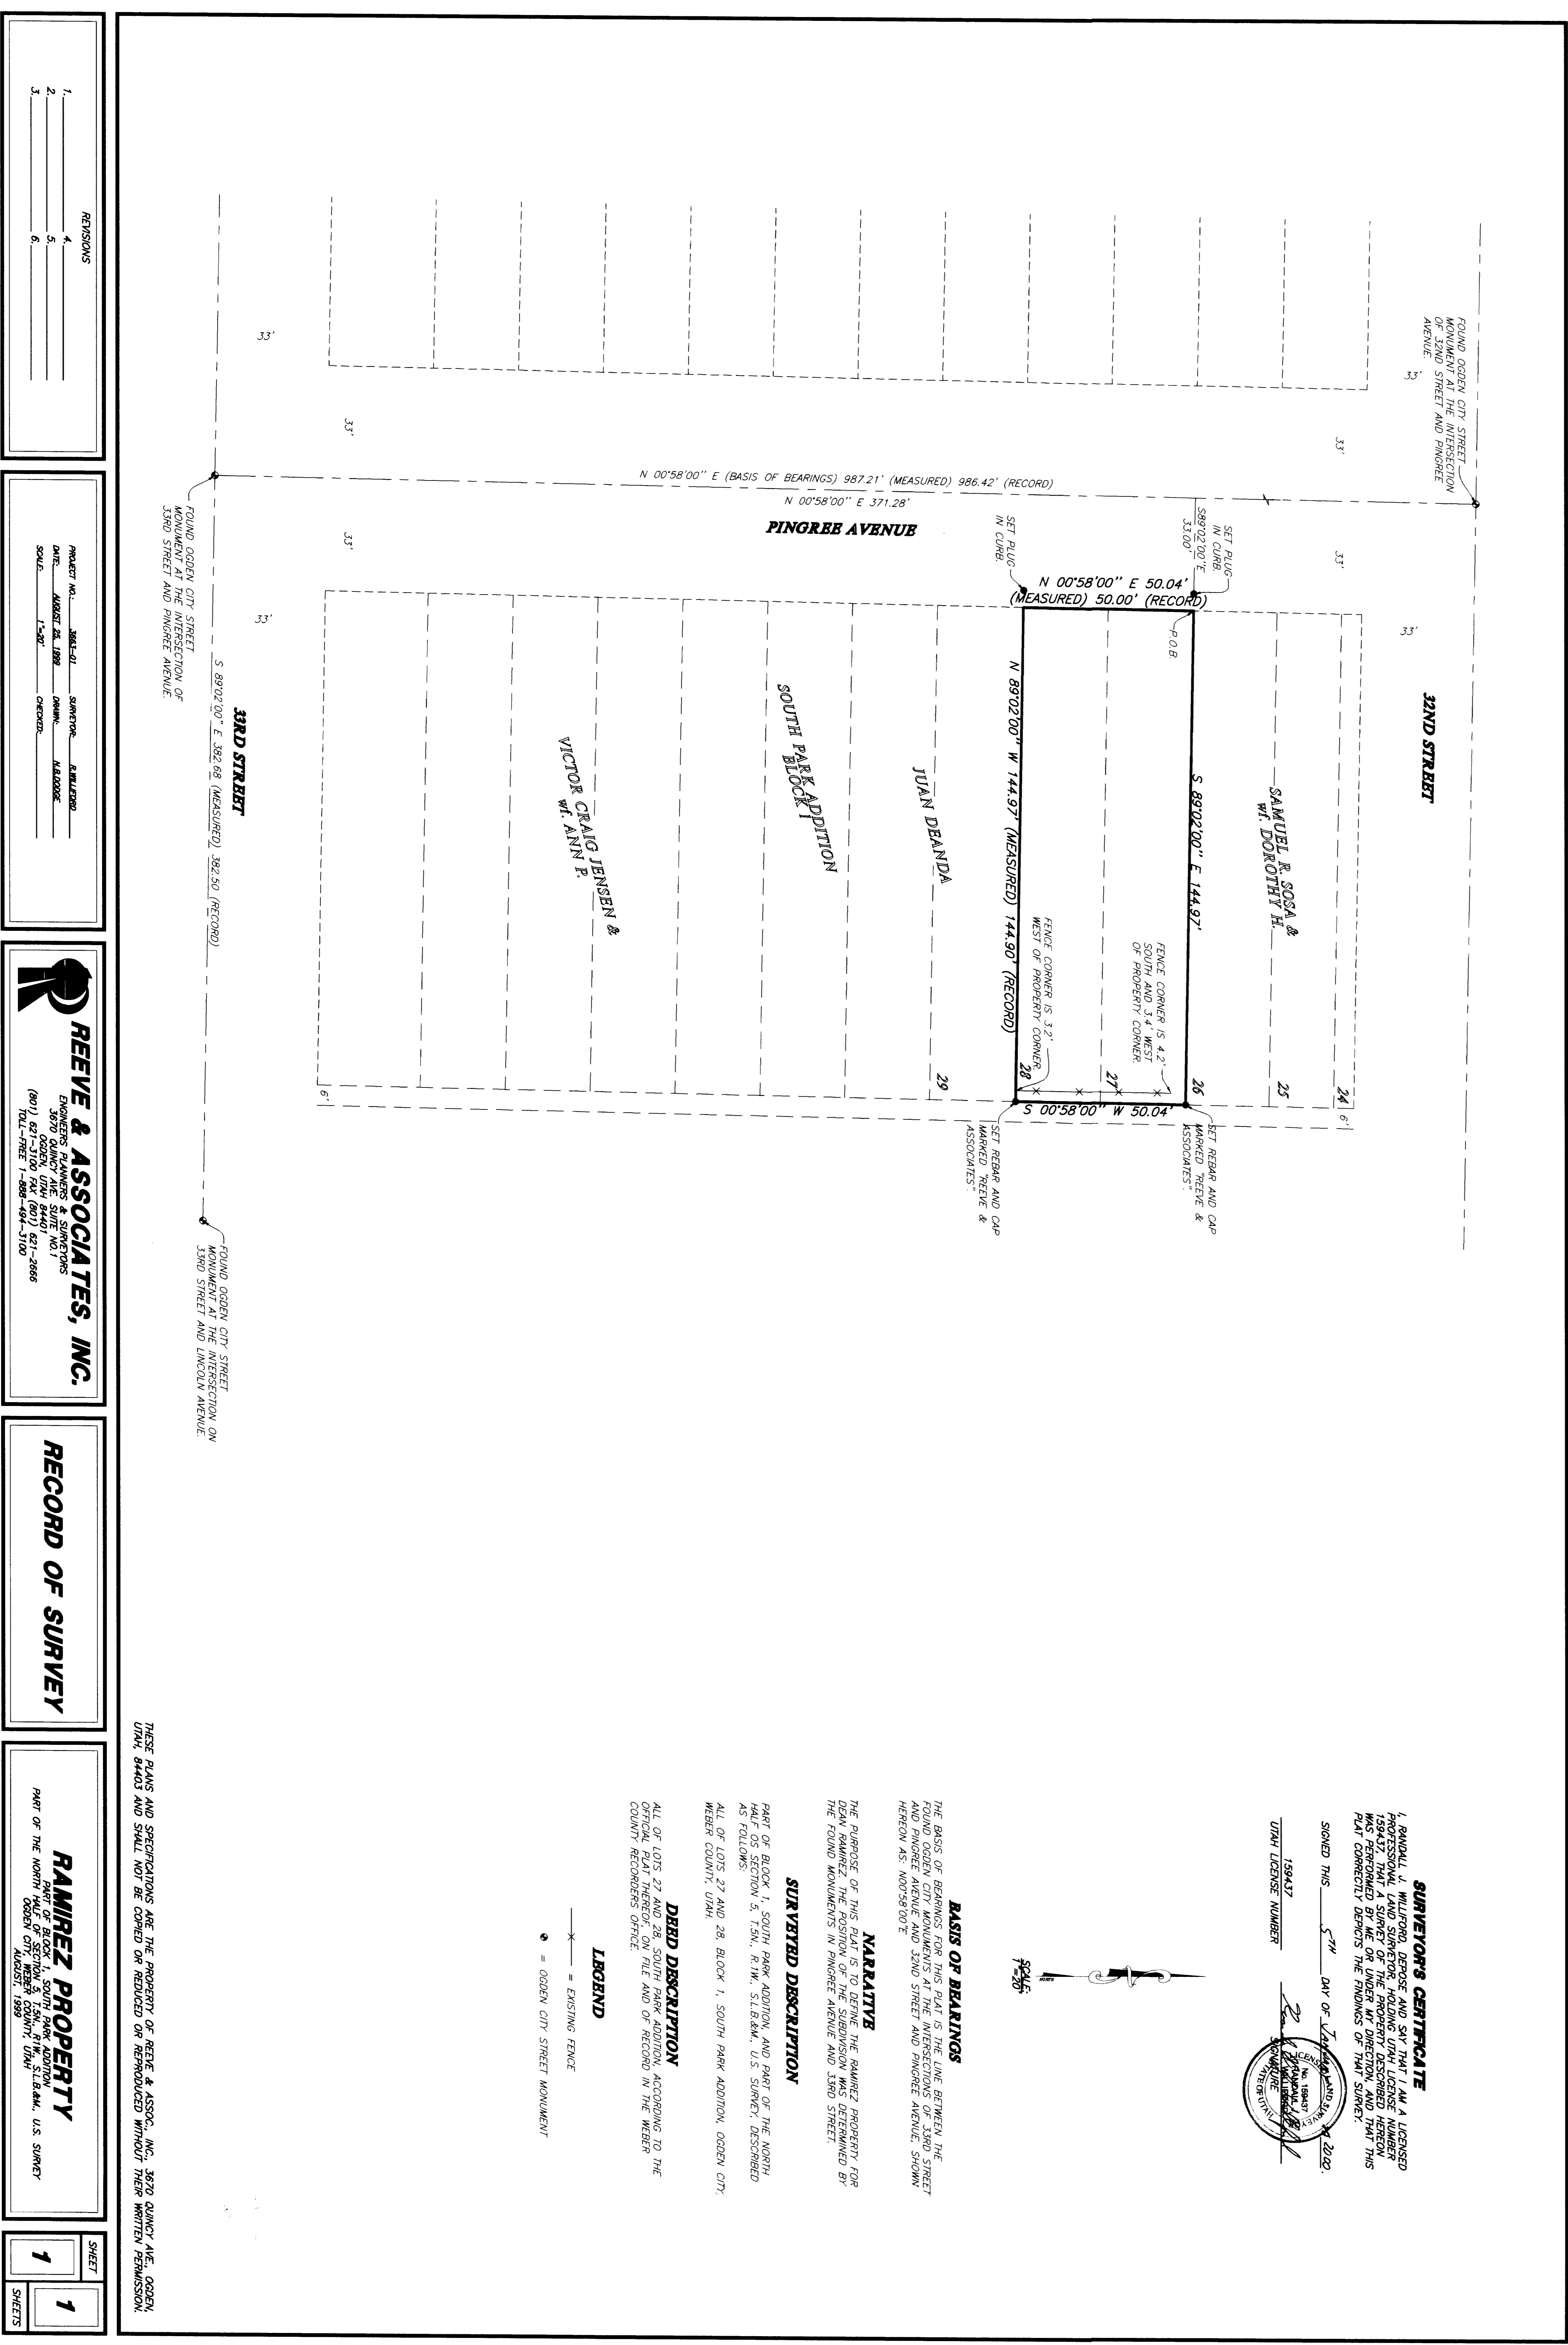


1.	4.
2.	5.
3.	6.


REEVE & ASSOCIATES, INC.
ENGINEERS, PLANNERS & SURVEYORS

RECORD OF SURVEY

RAMIREZ PROPERTY

SHEET 1 OF 1 SHEETS

THESE PLANS AND SPECIFICATIONS ARE THE PROPERTY OF REEVE & ASSOC., INC., 3870 QUINCY AVE., GREEN UTAH, 84403 AND SHALL NOT BE COPIED OR REPRODUCED OR REPRODUCED WITHOUT THEIR WRITTEN PERMISSION.

LEGEND
—X— = EXISTING FENCE

DEED DESCRIPTION

SURVEYED DESCRIPTION

NARRATIVE
THE PURPOSE OF THIS PLAT IS TO DEFINE THE RAMIREZ PROPERTY FOR DEAN RAMIREZ, THE POSITION OF THE SUBDIVISION WAS DETERMINED BY THE FOUND MONUMENTS IN PINGREE AVENUE AND 32ND STREET.

BASIS OF BEARINGS
THE BASIS OF BEARINGS FOR THIS PLAT IS THE LINE BETWEEN THE MONUMENTS AT THE INTERSECTION OF PINGREE AVENUE AND 32ND STREET AND PINGREE AVENUE AND 33RD STREET AND PINGREE AVENUE, SHOWN HEREON AS: N00°58'00"E.

SURVEYORS CERTIFICATE
I, RANDOLPH J. WILLIFORD, DEPOSE AND SAY THAT I AM A LICENSED SURVEYOR IN THE STATE OF UTAH, LICENSE NUMBER 159447, AND THAT I HAVE PERSONALLY EXAMINED THE PROPERTY DESCRIBED HEREON AND THAT A SURVEY OF THE PROPERTY DESCRIBED HEREON WAS PERFORMED BY ME OR UNDER MY DIRECTION, AND THAT THIS PLAT CORRECTLY DEPICTS THE FINDINGS OF THAT SURVEY.

SIGNED THIS 5TH DAY OF JANUARY, 2000.
159447
UTAH LICENSE NUMBER
RANDOLPH J. WILLIFORD
SURVEYOR


SCALE 1"=20'