

G:\DRAWINGS\SHARED\2869\13-LOTT\Survey\vey.dwg Wed Jan 05 09:23:31 2000 H.GUNN

REVISIONS

1					
2					
3					
4					
5					
6					

PROJECT NO. 2869-13 SURVEYOR: ARLANDER  
DATE: APRIL 28, 1999 DRAWN: ARLANDER  
SCALE: 1"=50' CHECKED: \_\_\_\_\_

**REEVE & ASSOCIATES, INC.**  
ENGINEERS, PLANNERS & SURVEYORS  
3670 QUINCY AVE., SUITE 101  
(901) 621-3100 FAX (901) 621-2666  
TOLL-FREE 1-888-444-3100

**RECORD OF SURVEY**

**FIRST NATIONAL INVESTMENTS COMPANY**  
PART OF BLOCK 15, BROOKLYN ADDITION, S.B.M., U.S. SURVEY  
OGDEN CITY, WEBER COUNTY, UTAH, MAY 26, 1989


SHEET

1
---

SHEETS

1
---

THESE PLANS AND SPECIFICATIONS ARE THE PROPERTY OF REEVE & ASSOC., INC., 3670 QUINCY AVE., OGDEN, UTAH. REVISIONS AND SHALL NOT BE COPIED OR REDUCED OR REPRODUCED WITHOUT THEIR WRITTEN PERMISSION.

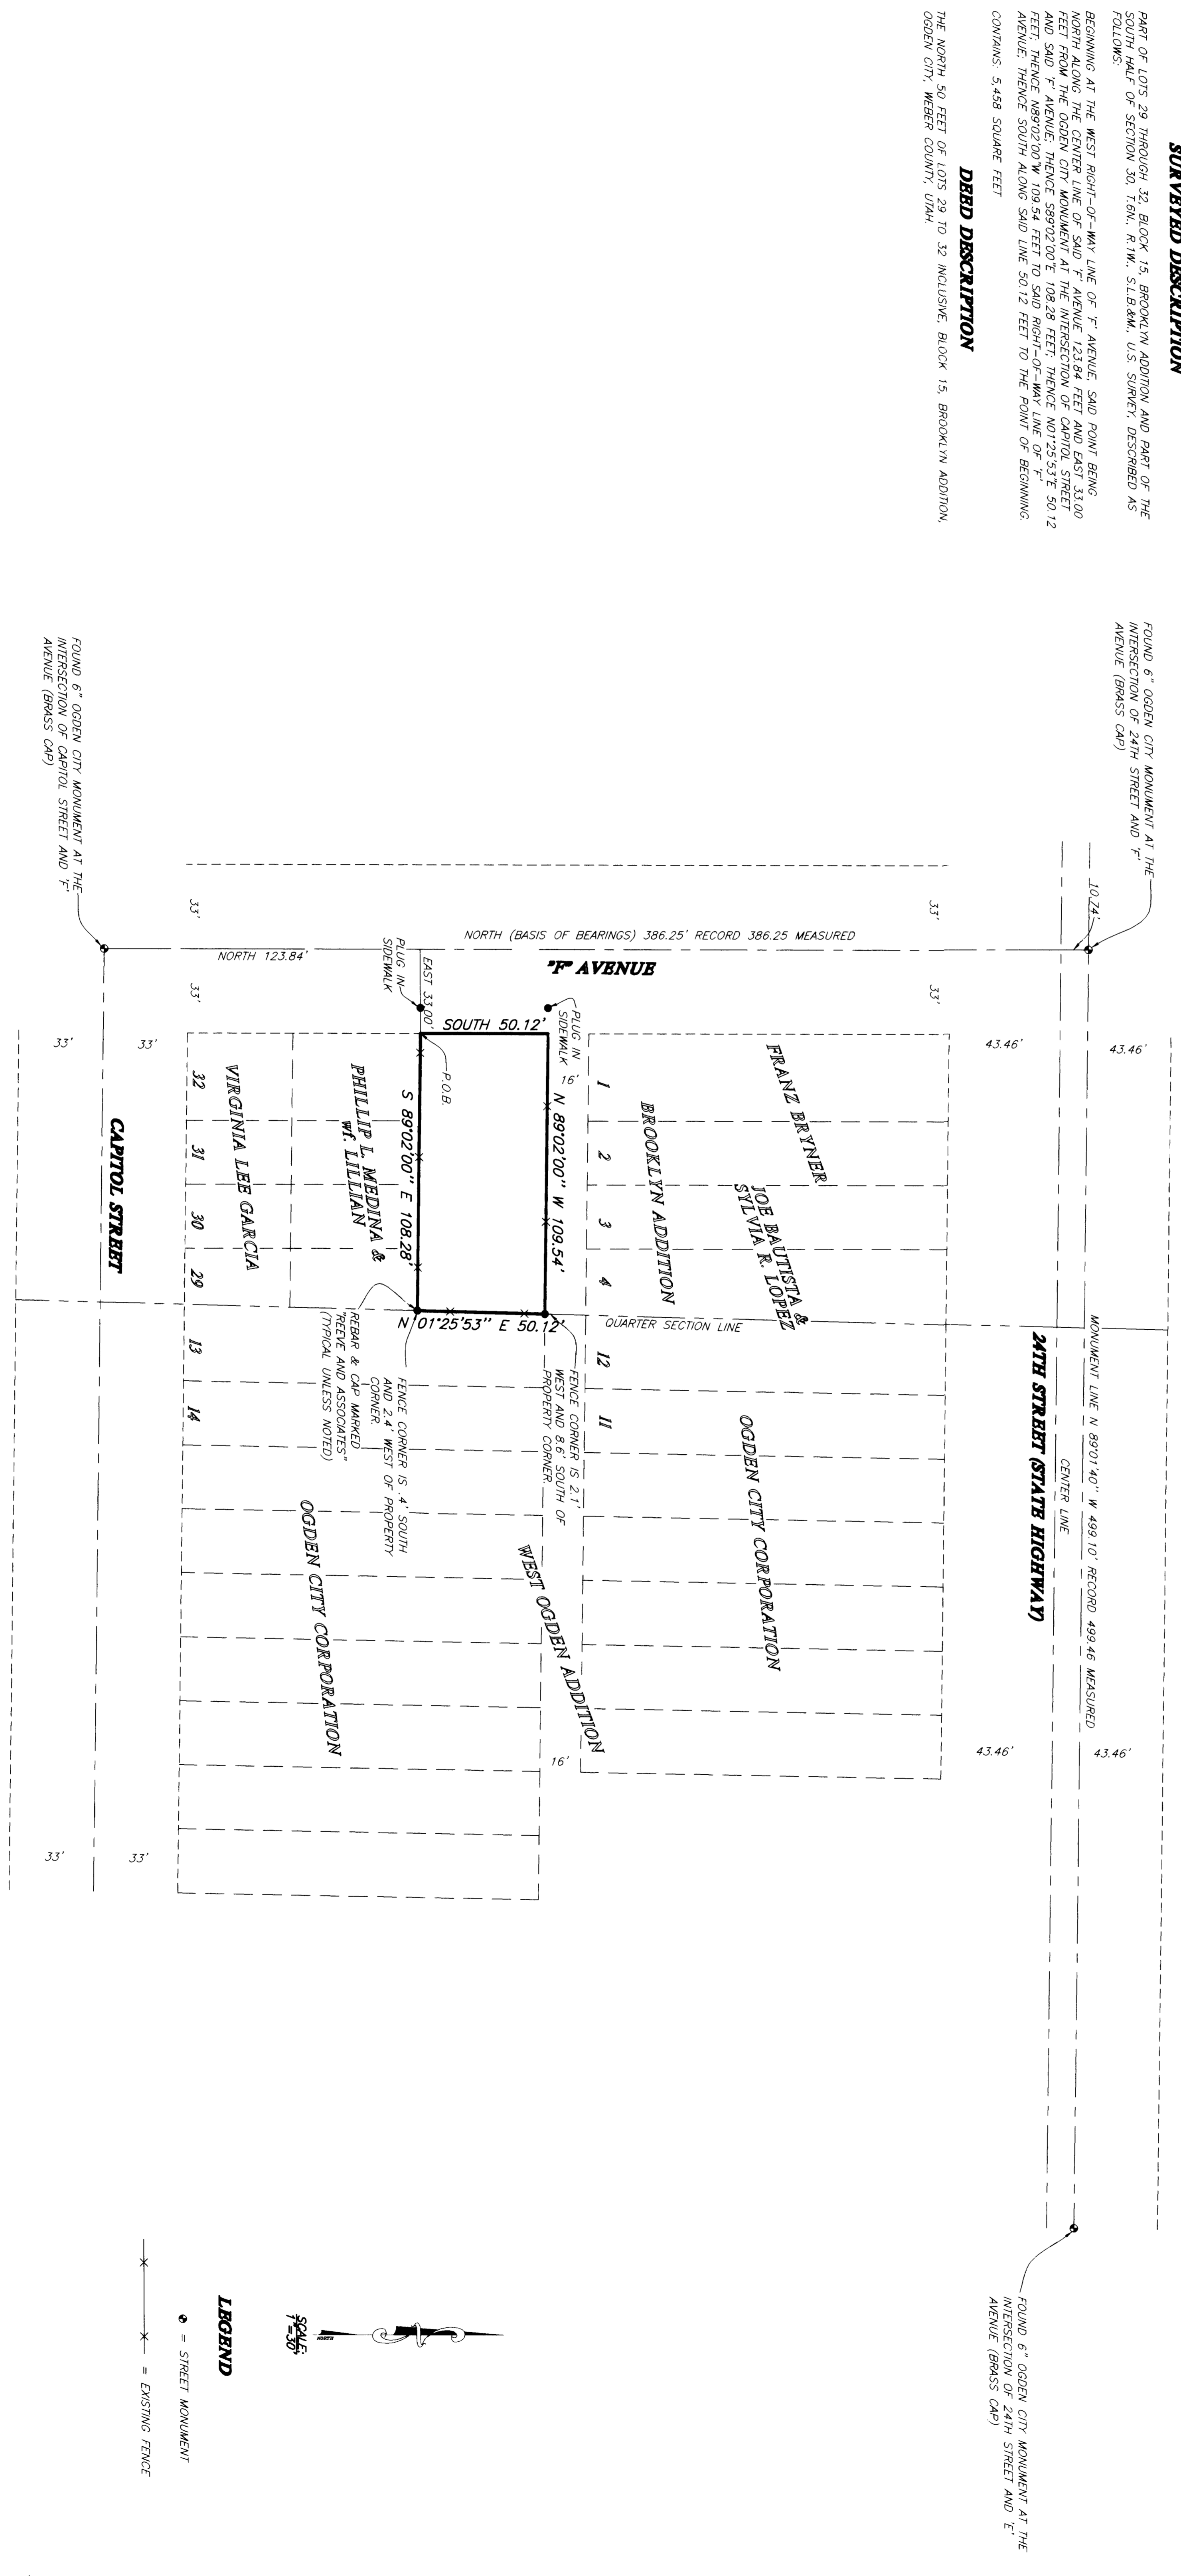

**BASIS OF BEARINGS**  
THE BASIS OF BEARINGS FOR THIS PLAT IS THE LINE BETWEEN THE TWO FOUND STREET MONUMENTS THE INTERSECTIONS OF 24TH STREET & 'F' AVENUE AND CAPITOL STREET & 'F' AVENUE, SHOWN HEREON AS N0070000E.

**NARRATIVE**  
THE PURPOSE OF THIS PLAT IS TO DEFINE THE FIRST NATIONAL INVESTMENTS COMPANY PROPERTY FOR LMC CONSTRUCTION. ALL LINES WERE SET BY THE FOUND OGDEN CITY MONUMENTS.

**SURVEYED DESCRIPTION**  
PART OF LOTS 29 THROUGH 32, BLOCK 15, BROOKLYN ADDITION AND PART OF THE SOUTH HALF OF SECTION 20, T6N., R1W., S1B.M., U.S. SURVEY, DESCRIBED AS FOLLOWS:  
BEGINNING AT THE WEST RIGHT-OF-WAY LINE OF 'F' AVENUE, SAID POINT BEING NORTH ALONG THE CENTER LINE OF SAID 'F' AVENUE, 123.84 FEET AND EAST 33.00 FEET FROM THE OGDEN CITY MONUMENT AT THE INTERSECTION OF CAPITOL STREET AND SAID 'F' AVENUE; 

**DEED DESCRIPTION**  
THE NORTH 50 FEET OF LOTS 29 TO 32 INCLUSIVE, BLOCK 15, BROOKLYN ADDITION, OGDEN CITY, WEBER COUNTY, UTAH.

FOUND 6" OGDEN CITY MONUMENT AT THE INTERSECTION OF 24TH STREET AND 'F' AVENUE (BRASS CAP)  
10.24'  
43.46'  
43.46'  
CENTER LINE  
24TH STREET (STATE HIGHWAY)  
43.46'  
43.46'


**SURVEYOR'S CERTIFICATE**  
I, RONALD A. WILSON, DEPOSE AND SAY THAT I AM A LICENSED SURVEYOR AND THAT I AM THE SURVEYOR OF THE ABOVE DESCRIBED SURVEY. I HAVE PERSONALLY CONDUCTED THE SURVEY AND THAT THIS PLAN CORRECTLY DEPICTS THE FINDINGS OF THE SURVEY.

SIGNED THIS 5<sup>TH</sup> DAY OF JANUARY, 1999.  
R. A. WILSON  
SURVEYOR  
UTAH LICENSE NUMBER 159437

**LEGEND**  
◆ = STREET MONUMENT  
—X— = EXISTING FENCE

SCALE


