


G:\DRAWINGS\SHARE\013736\01-rcluf\Plat.dwg Thu Dec 02 15:03:48 1999 H.GUNN

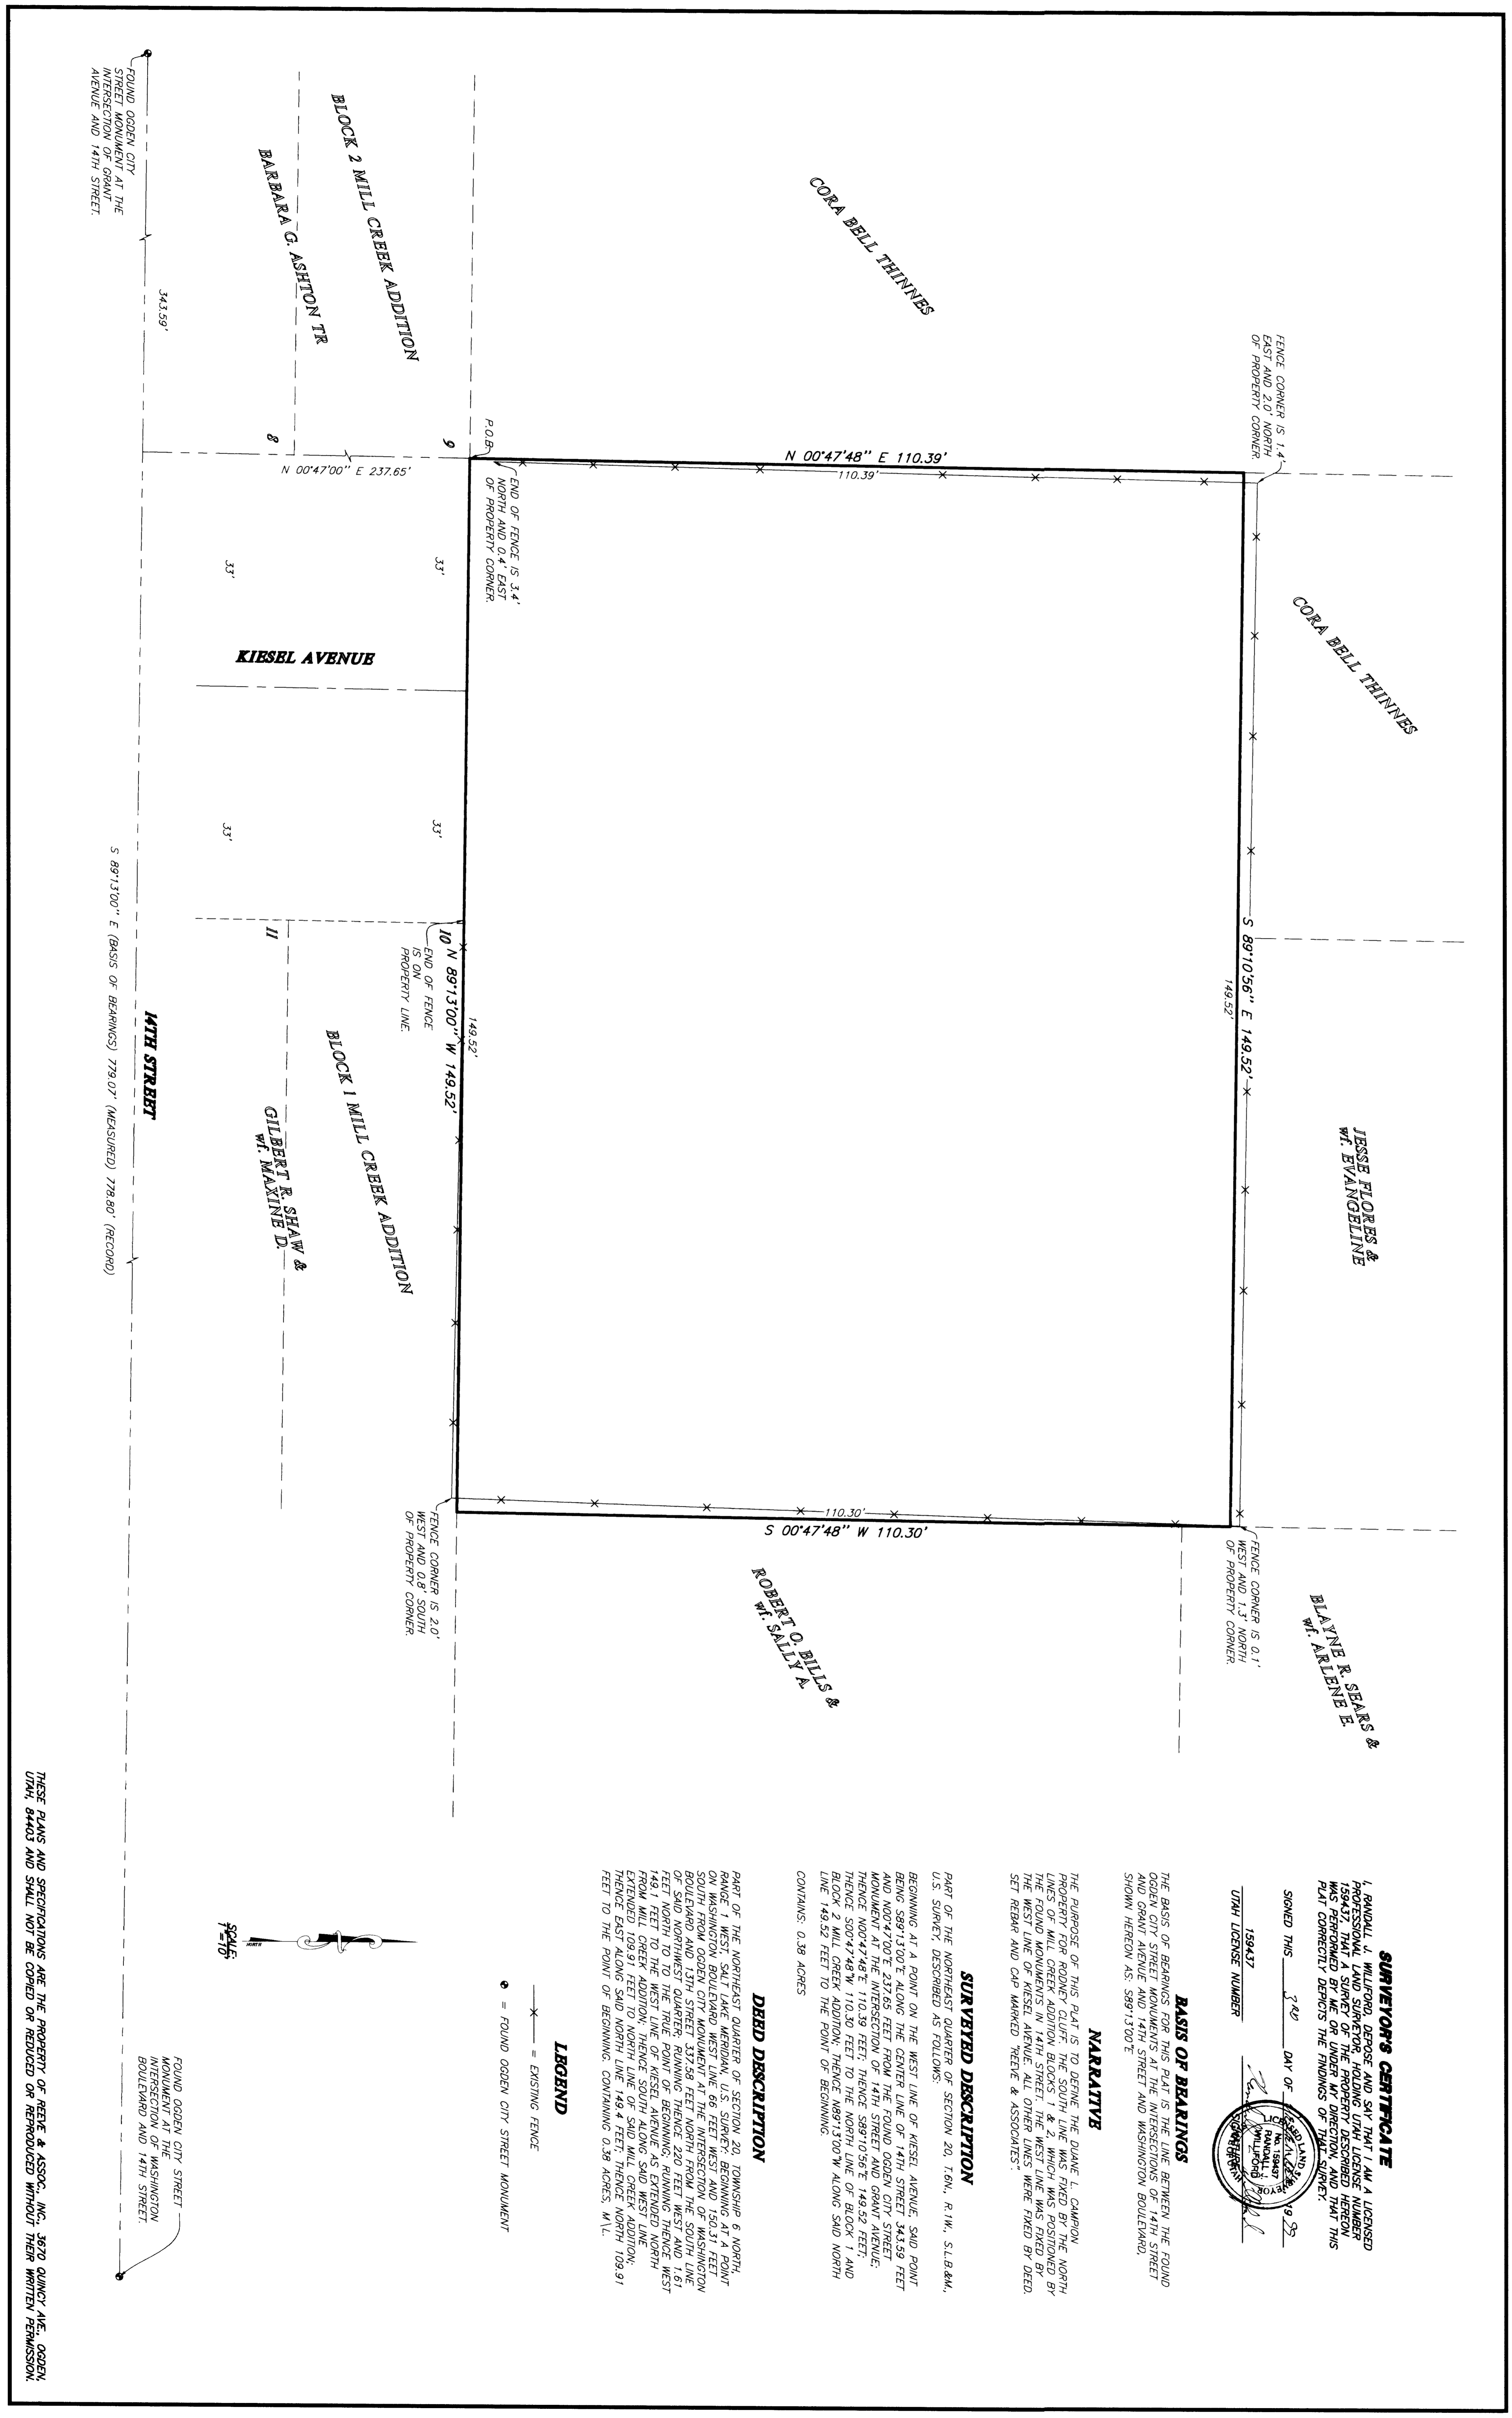

SURVEYORS CERTIFICATE


SIGNED THIS 3rd DAY OF SEPTEMBER 1999


(Signature)

BASIS OF BEARINGS


NARRATIVE


SURVEYED DESCRIPTION


PART OF THE NORTHEAST QUARTER OF SECTION 20, T.6N., R.1W., S.L.B.M., U.S. SURVEY, DESCRIBED AS FOLLOWS:

THENCE N00°47'48"E 110.39 FEET; THENCE S89°10'56"E 149.52 FEET; THENCE S00°47'48"W 110.30 FEET TO THE NORTH LINE OF BLOCK 1 AND BLOCK 2 MILL CREEK ADDITION; THENCE N89°13'00"W ALONG SAID NORTH LINE 149.52 FEET TO THE POINT OF BEGINNING.

CONTAINS: 0.38 ACRES

DEED DESCRIPTION



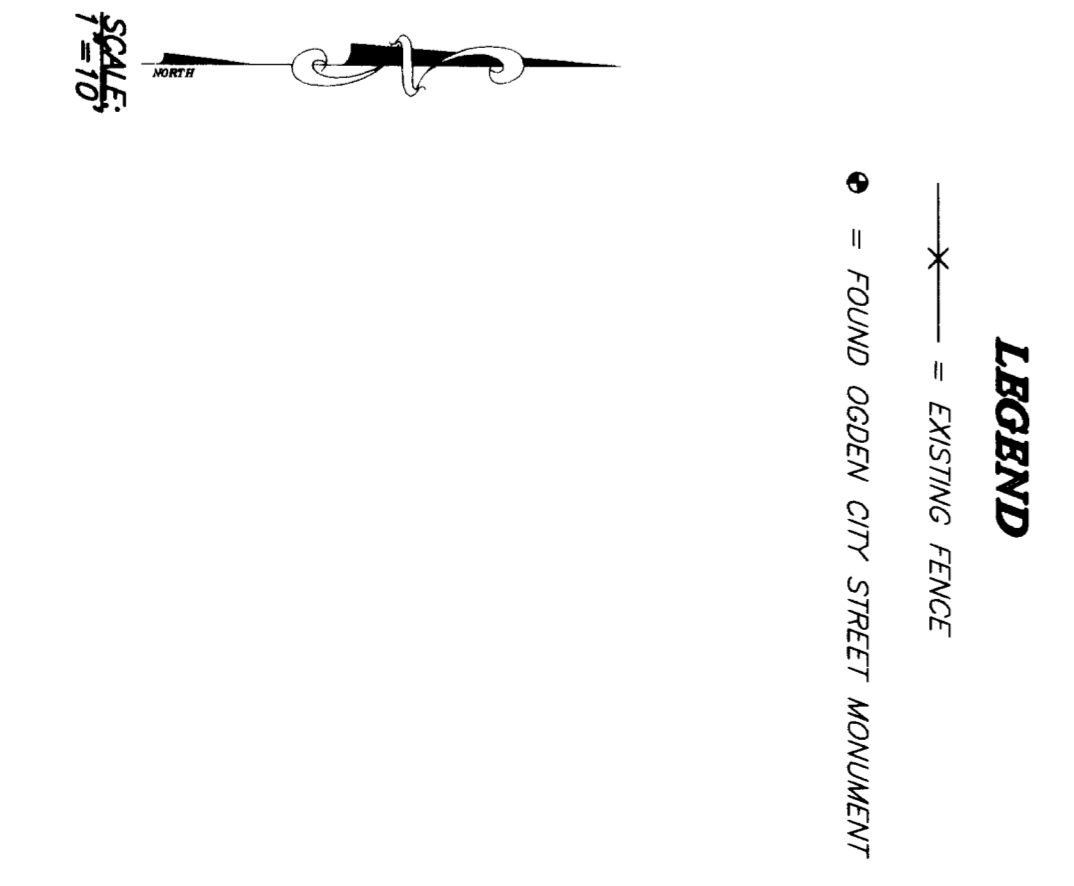

DIMENSIONS

1.	4.
2.	5.
3.	6.

PROJECT NO. JR-81 SURVEYOR J. MILLER
 DATE NOVEMBER 2, 1998 DRAWN M. BOGGS
 SCALE 1"=100' CHECKED _____

REEVE & ASSOCIATES, INC.

City Engineering & Surveying
 (801) 871-7100 FAX (801) 871-2888

City Engineering & Surveying
 92 W. 100 S. STE. #110
 LOGAN, UTAH 84321
 (435) 752-3503 FAX (435) 752-2888

RECORD OF SURVEY

CAMPION PROPERTY

PART OF THE NORTHEAST QUARTER OF SECTION 20, T.6N., R.1W., S.L.B.M., U.S. SURVEY
 OCTOBER, 1999

SHEET	1
SHEETS	1

002380

002380