

BASIS OF BEARINGS


NARRATIVE

THE SOUTHWEST AND NORTHEAST CORNERS OF THIS SECTION WERE A PROPER RECOGNIZED. THE SOUTH EAST CORNER OF SECTION 26 IS A PROPER RECOGNIZED. THE SURVEY WAS MADE BY ACQUISITION CONSIDERATIONS. THE WEST LINE WAS TIED TO AN OLD SURVEY POINT MARKED WITH AN AXLE IS OVER 20 YEARS AND WAS ERECTED WITH THE BELIEF THAT IT WAS THE BOUNDARY LINE. THE OLD SURVEY POINT MARKED WITH AN AXLE IS DEDICATED BY REMAINING VEGETATION. THE LOCATION OF THE POINT OF BEGINNING WAS TIED BY DISTANCES FROM THE RAILROAD DEEDS.

SURVEYED DESCRIPTION






DEED DESCRIPTION



SURVEYOR'S CERTIFICATE

I, SANDRA L. WILLIAMS, DOHERE AND SAY THAT I AM A LICENSED PROFESSIONAL SURVEYOR IN THE STATE OF UTAH, LICENSE NUMBER 158437, THAT A SURVEY OF THE PROPERTY DESCRIBED BY THIS PLAT CORRECTLY DENOTES THE FINDINGS OF THIS SURVEY.

SIGNED THIS 30TH DAY OF SEPTEMBER, 1999.
158437
SANDRA L. WILLIAMS
UTAH LICENSE NUMBER SIGNATURE

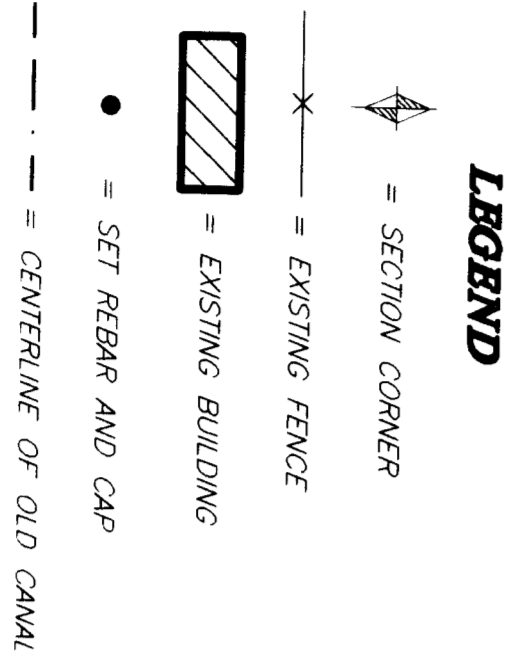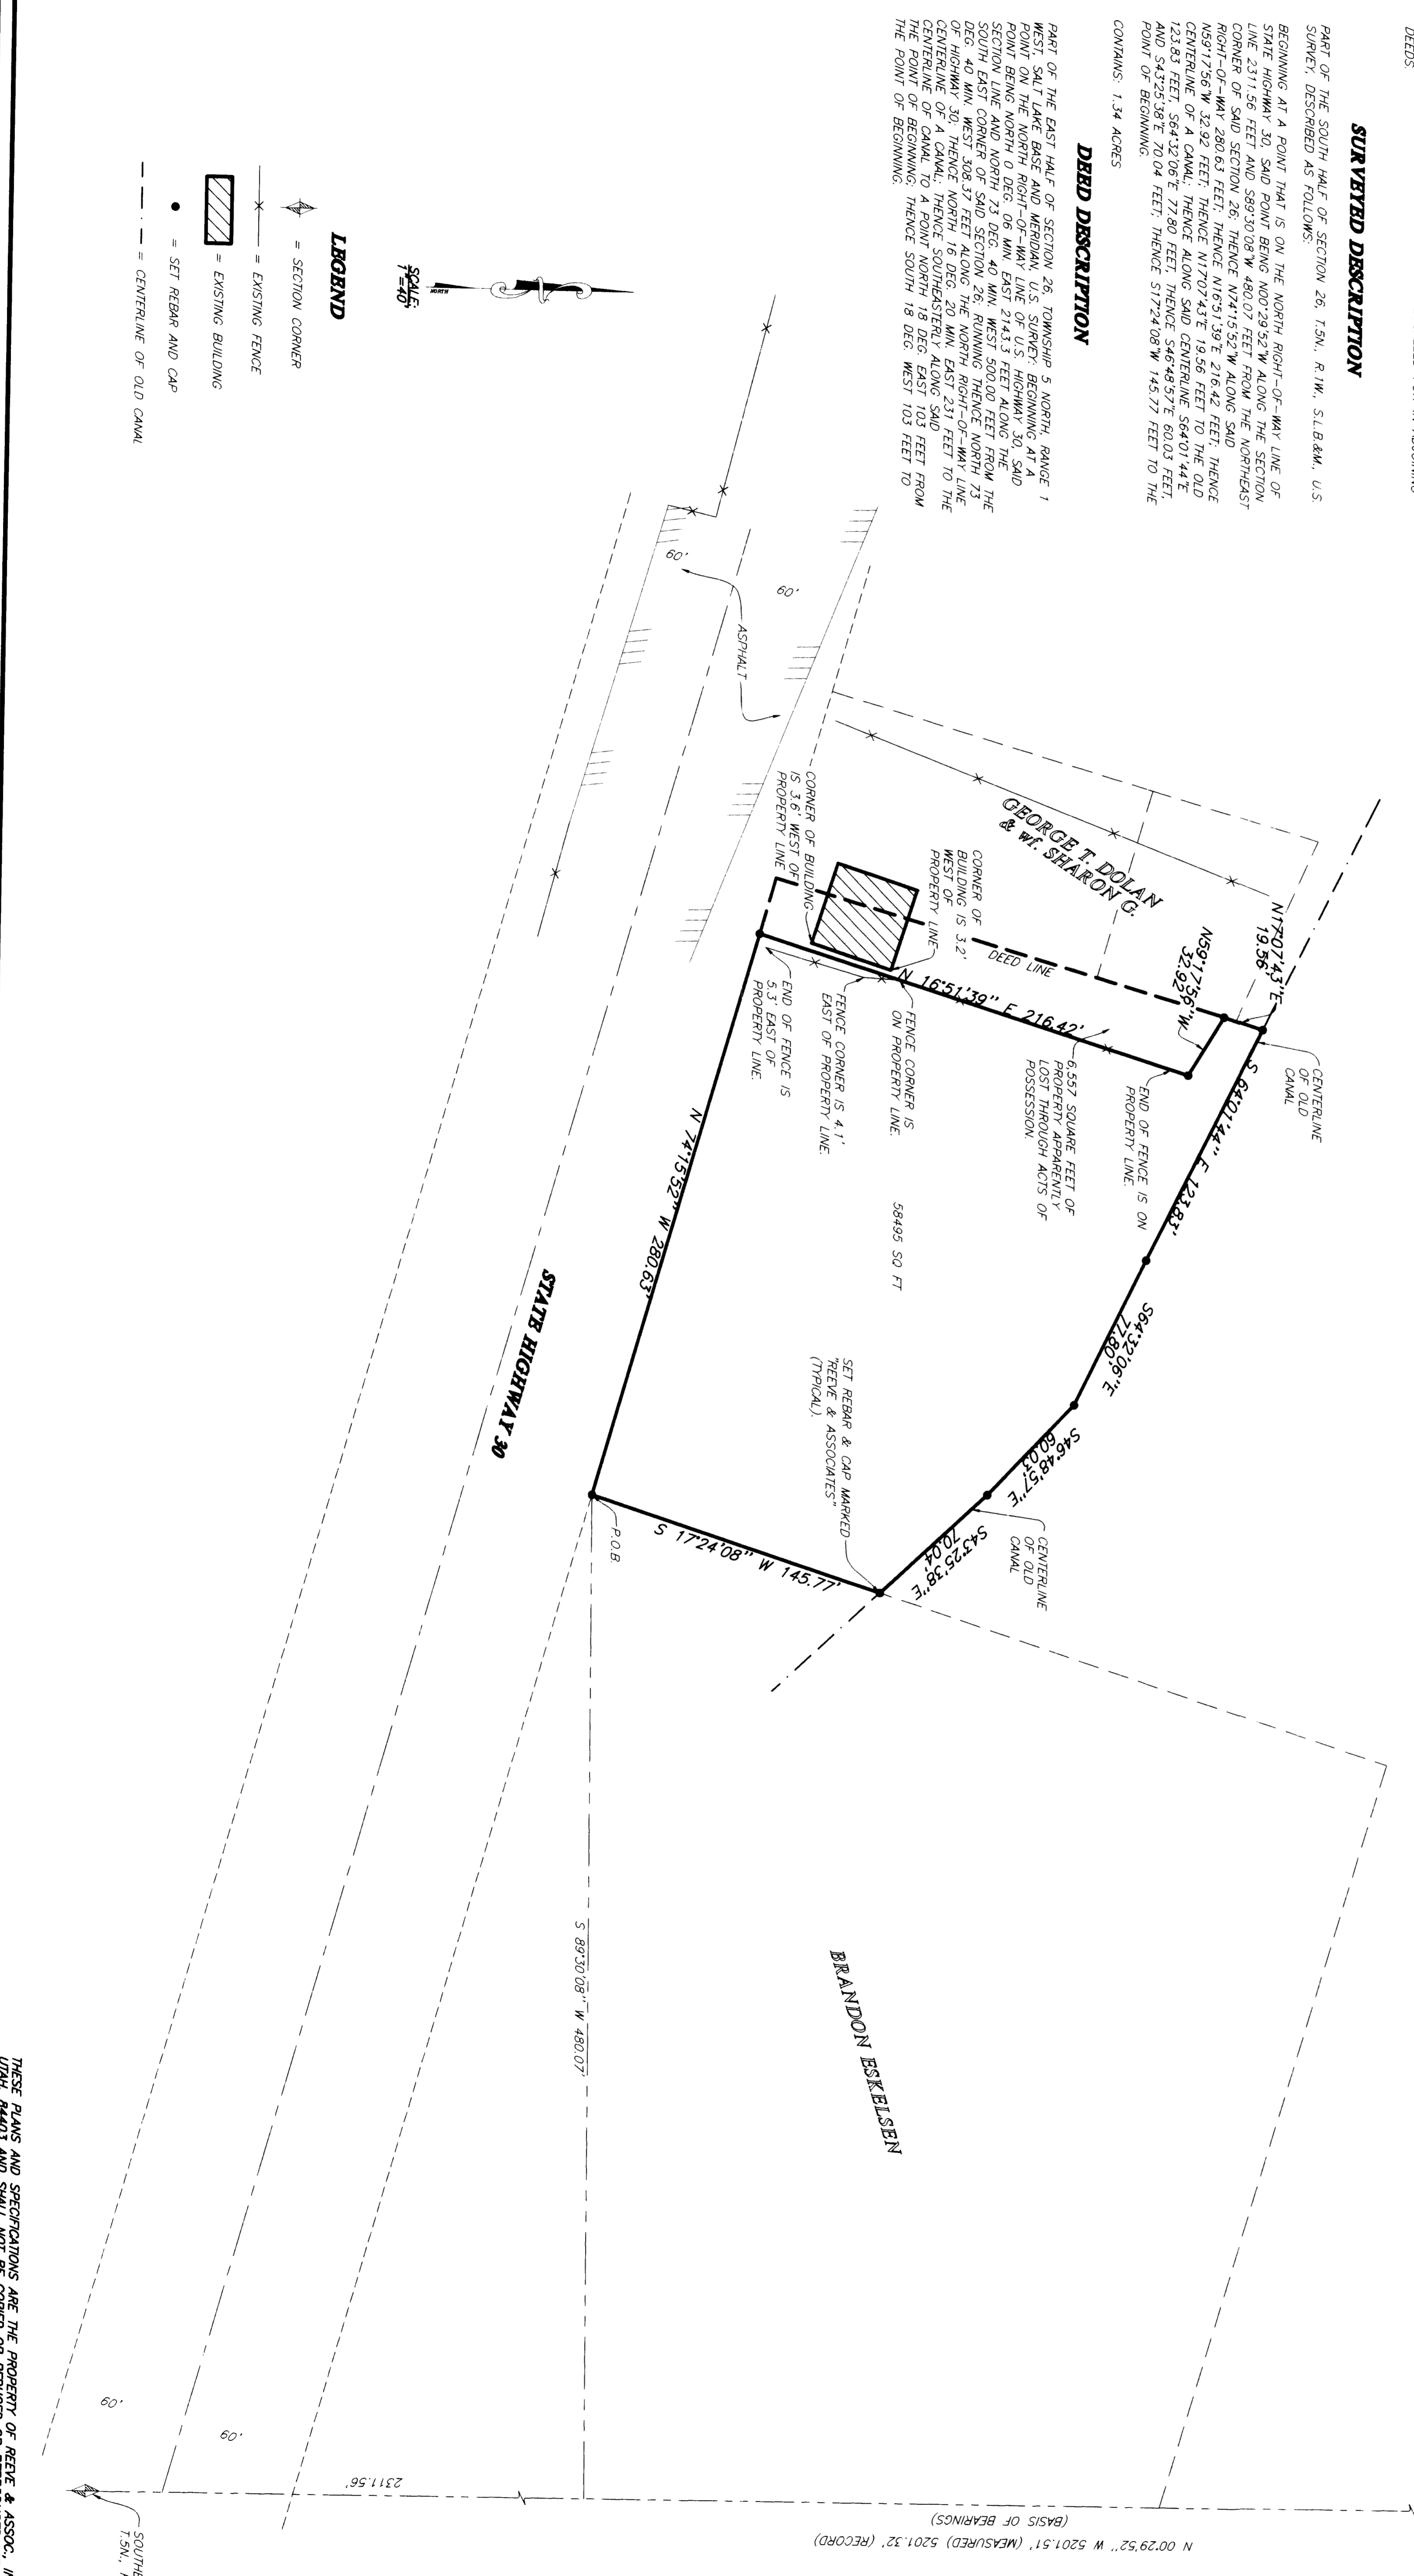

REVISIONS

1.	
2.	
3.	
4.	
5.	
6.	

PROJECT NO.	150-1-01	DATE:	AUGUST 12, 1999
DRAWN BY:	AMBLER	CHECKED BY:	AMBLER
SCALE:	1"=40'	DESIGNED BY:	AMBLER

REEVE & ASSOCIATES, INC.
ENGINEERING, PLANNING & SURVEYING

RECORD OF SURVEY

PITCHER PROPERTY
DATE: JULY 1999

THESE PLANS AND SPECIFICATIONS ARE THE PROPERTY OF REEVE & ASSOC., INC. 3920 QUINCY AVE. OGDEN, UTAH 84403 AND SHALL NOT BE COPIED OR REDUCED OR REPRODUCED WITHOUT THEIR WRITTEN PERMISSION.