

REVISIONS

1.		4.
2.		5.
3.		6.

PROJECT NO. 2704-04
 DATE: JUN 28, 1999
 SCALE: 1"=50'


SYNOPSIS: SURVEY
 DRAWN BY: M. ALLEN
 CHECKED BY: M. ALLEN

REEVE & ASSOCIATES, INC.
 ENGINEERS PLANNERS & SURVEYORS
 3070 OGDEN, UTAH 84403
 (801) 527-5100 FAX (801) 527-2888
 TOLL-FREE 1-888-491-5100

RECORD OF SURVEY


ALL OF LOT 51 AND PART OF LOT 52 WOODLAND ESTATES SUBDIVISION UNIT 2
 PART OF THE NORTHWEST CORNER OF SECTION 33, T4N, S12E, R40E, CO. 9, UT.
 OGDEN CITY, WEBER COUNTY, UTAH
 FEBRUARY, 1999

SHEET 1
 SHEETS 1

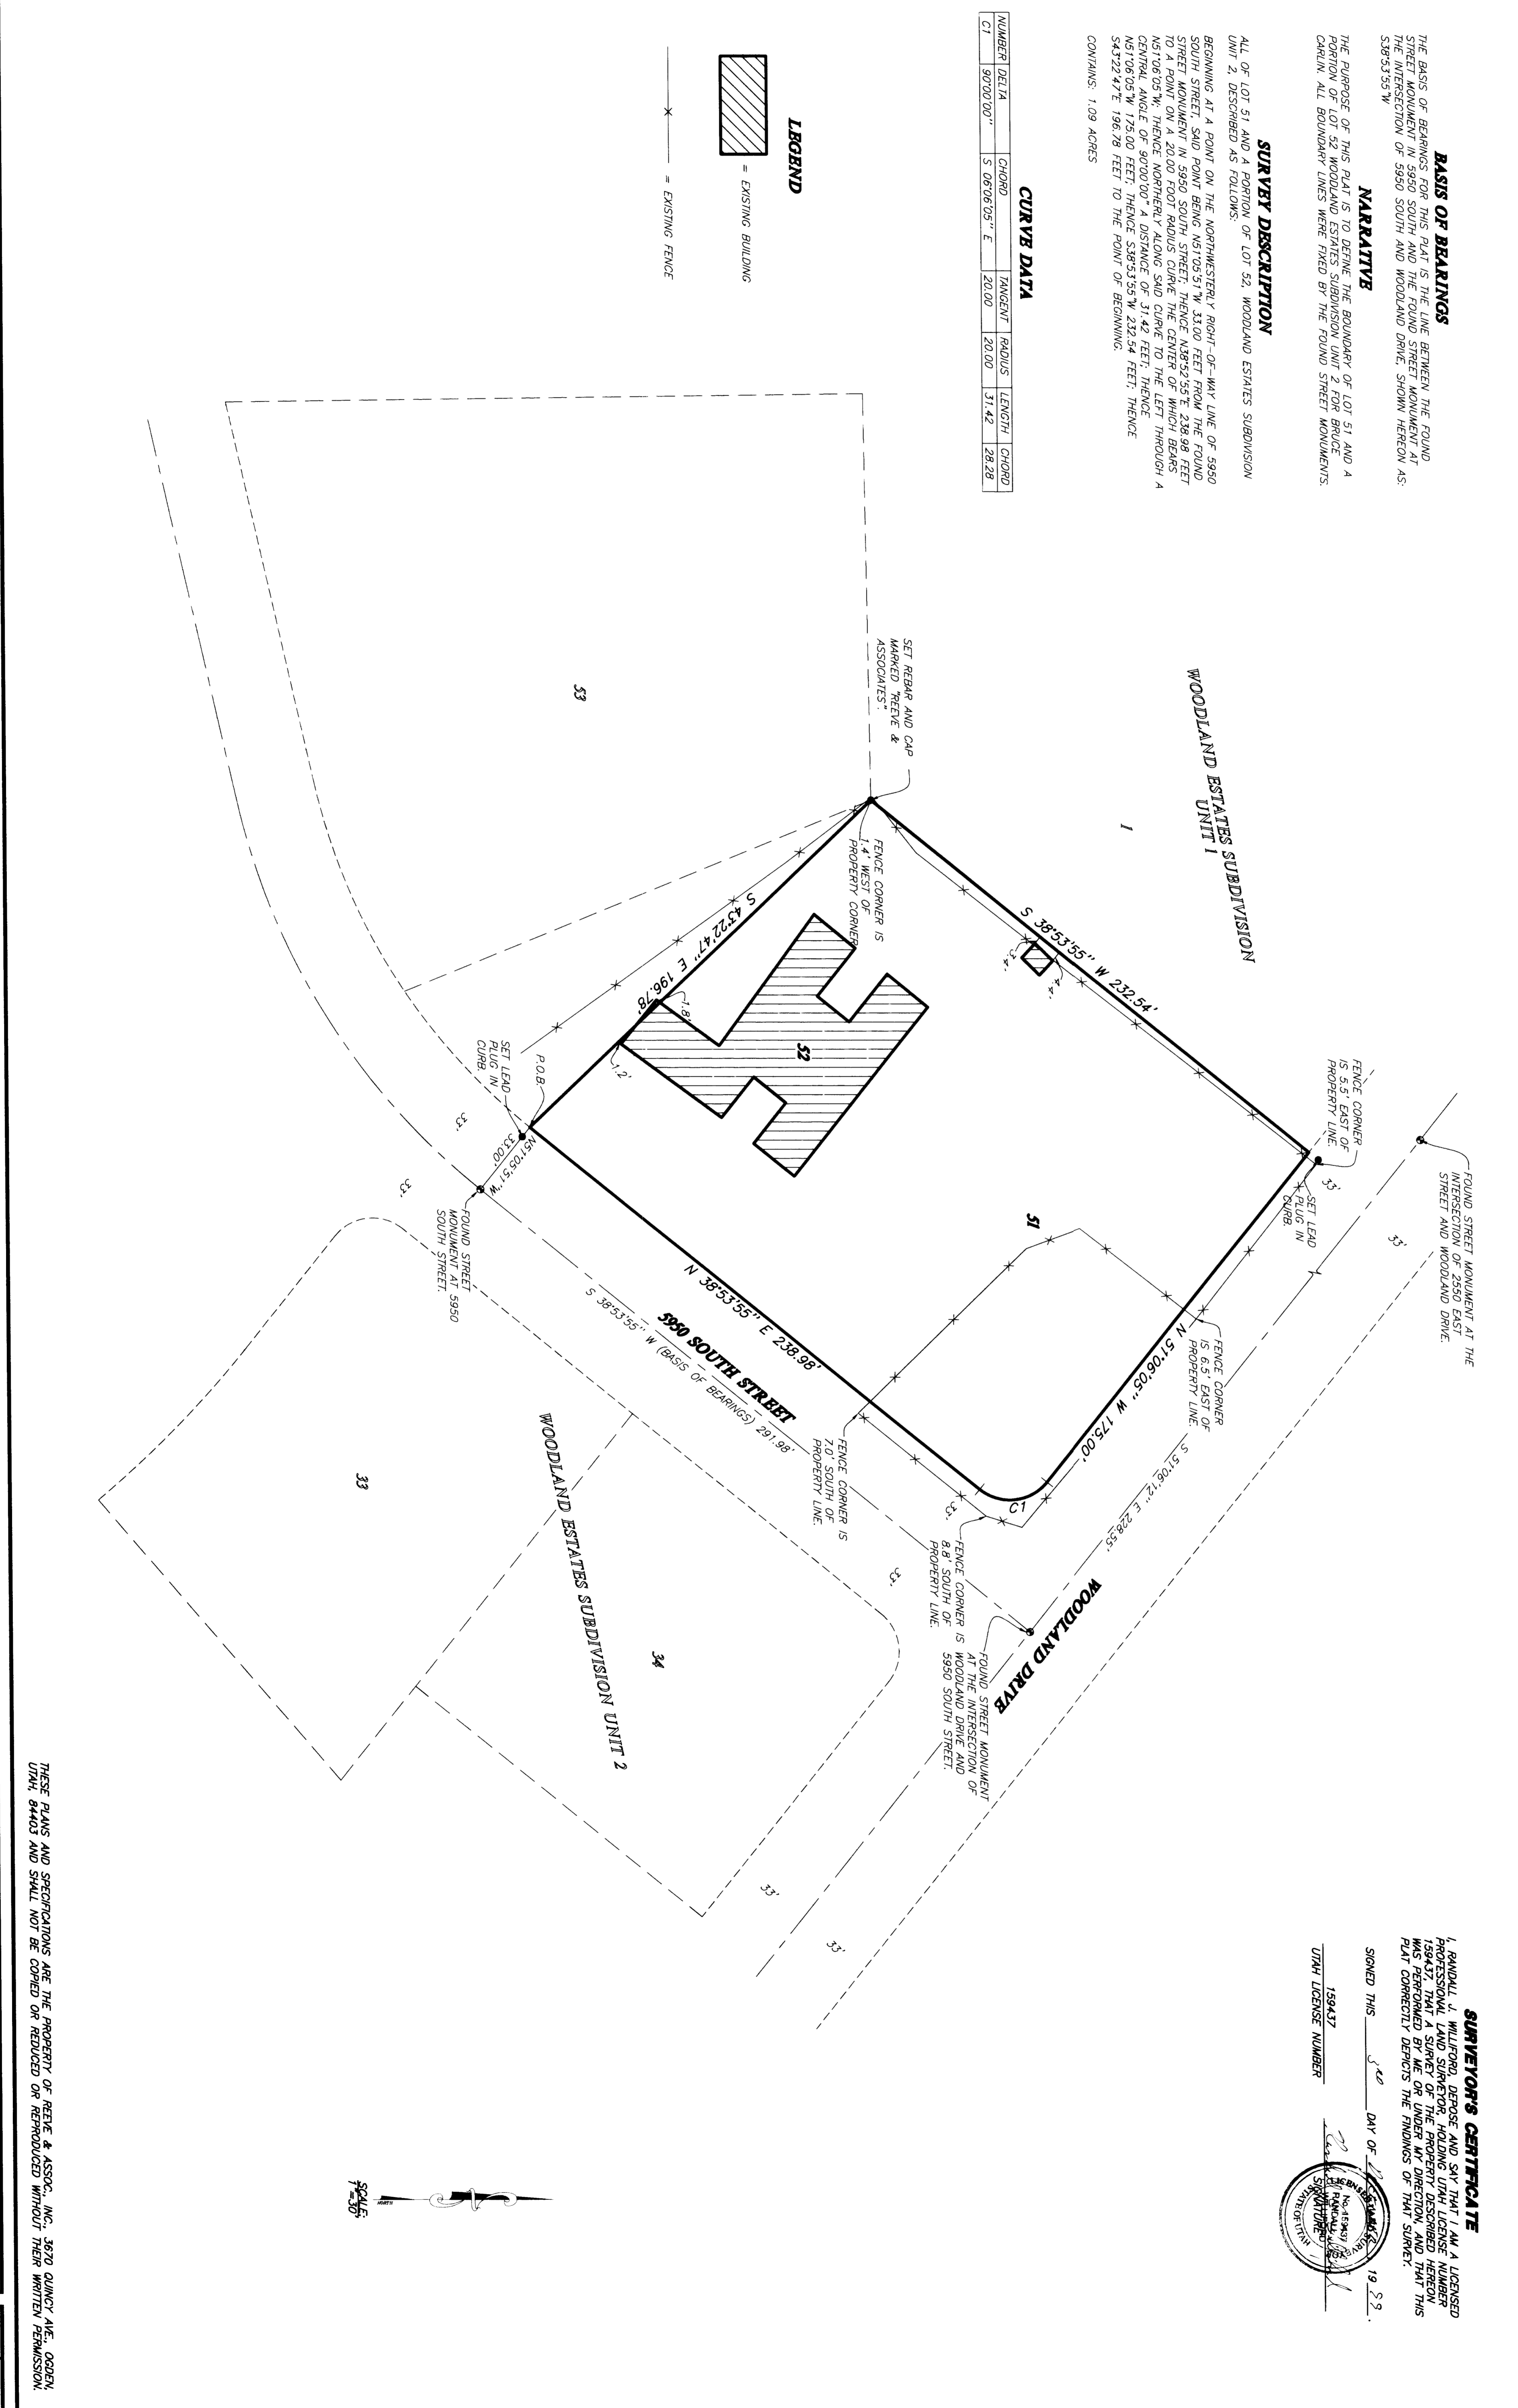

CURVE DATA

NUMBER	DELTA	CHORD	TANGENT	RADIUS	LENGTH	CHORD

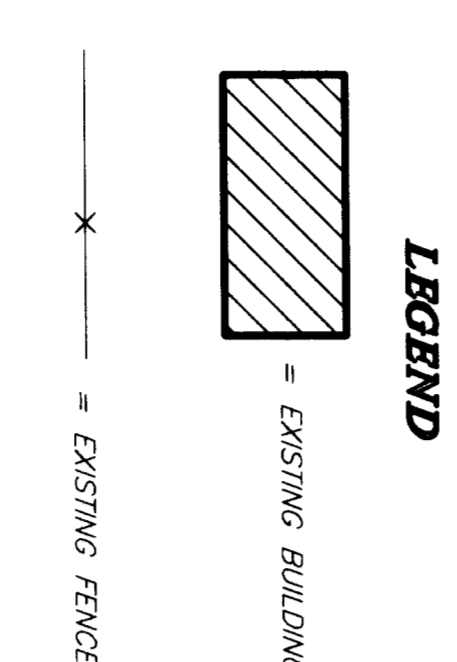

BASIS OF BEARINGS

NARRATIVE

SURVEY DESCRIPTION
 ALL OF LOT 51 AND A PORTION OF LOT 52, WOODLAND ESTATES SUBDIVISION UNIT 2, DESCRIBED AS FOLLOWS:


SURVEYOR'S CERTIFICATE
 I, RANDALL J. WILFORD, DEPOSE AND SAY THAT I AM A LICENSED PROFESSIONAL SURVEYOR IN THE STATE OF UTAH, AND THAT THE SURVEY AND PLAT HEREON WERE PERFORMED BY ME OR UNDER MY DIRECTION, AND THAT THIS PLAT CORRECTLY DEPICTS THE FINDINGS OF THAT SURVEY.

 UTAH LICENSE NUMBER

