

5:\DRAWINGS\SHARED\365B\01\Boundary.dwg Thu Dec 02 15:24:33 1999 H GUNN

SURVEYORS CERTIFICATE
SURVEYOR
STATE OF UTAH

LEGEND
[Hatched Box] = EXISTING BUILDING
[Line with X] = EXISTING FENCE


- REVISIONS**
- | | | | | | |
|----|--|--|--|--|--|
| 1. | | | | | |
| 2. | | | | | |
| 3. | | | | | |
| 4. | | | | | |
| 5. | | | | | |
| 6. | | | | | |

PROJECT NO.: 308-01 SURVEYOR: A.M. JACOBO
DATE: OCTOBER 16, 1999 DRAWING: M.A. JACOBO
SCALE: 1"=40' CHECKED: _____

REEVE & ASSOCIATES, INC.
Civil Engineering, Structural Engineering

RECORD OF SURVEY

HARRIS, NELSON, & SHUPE PROPERTIES
MAY 1999

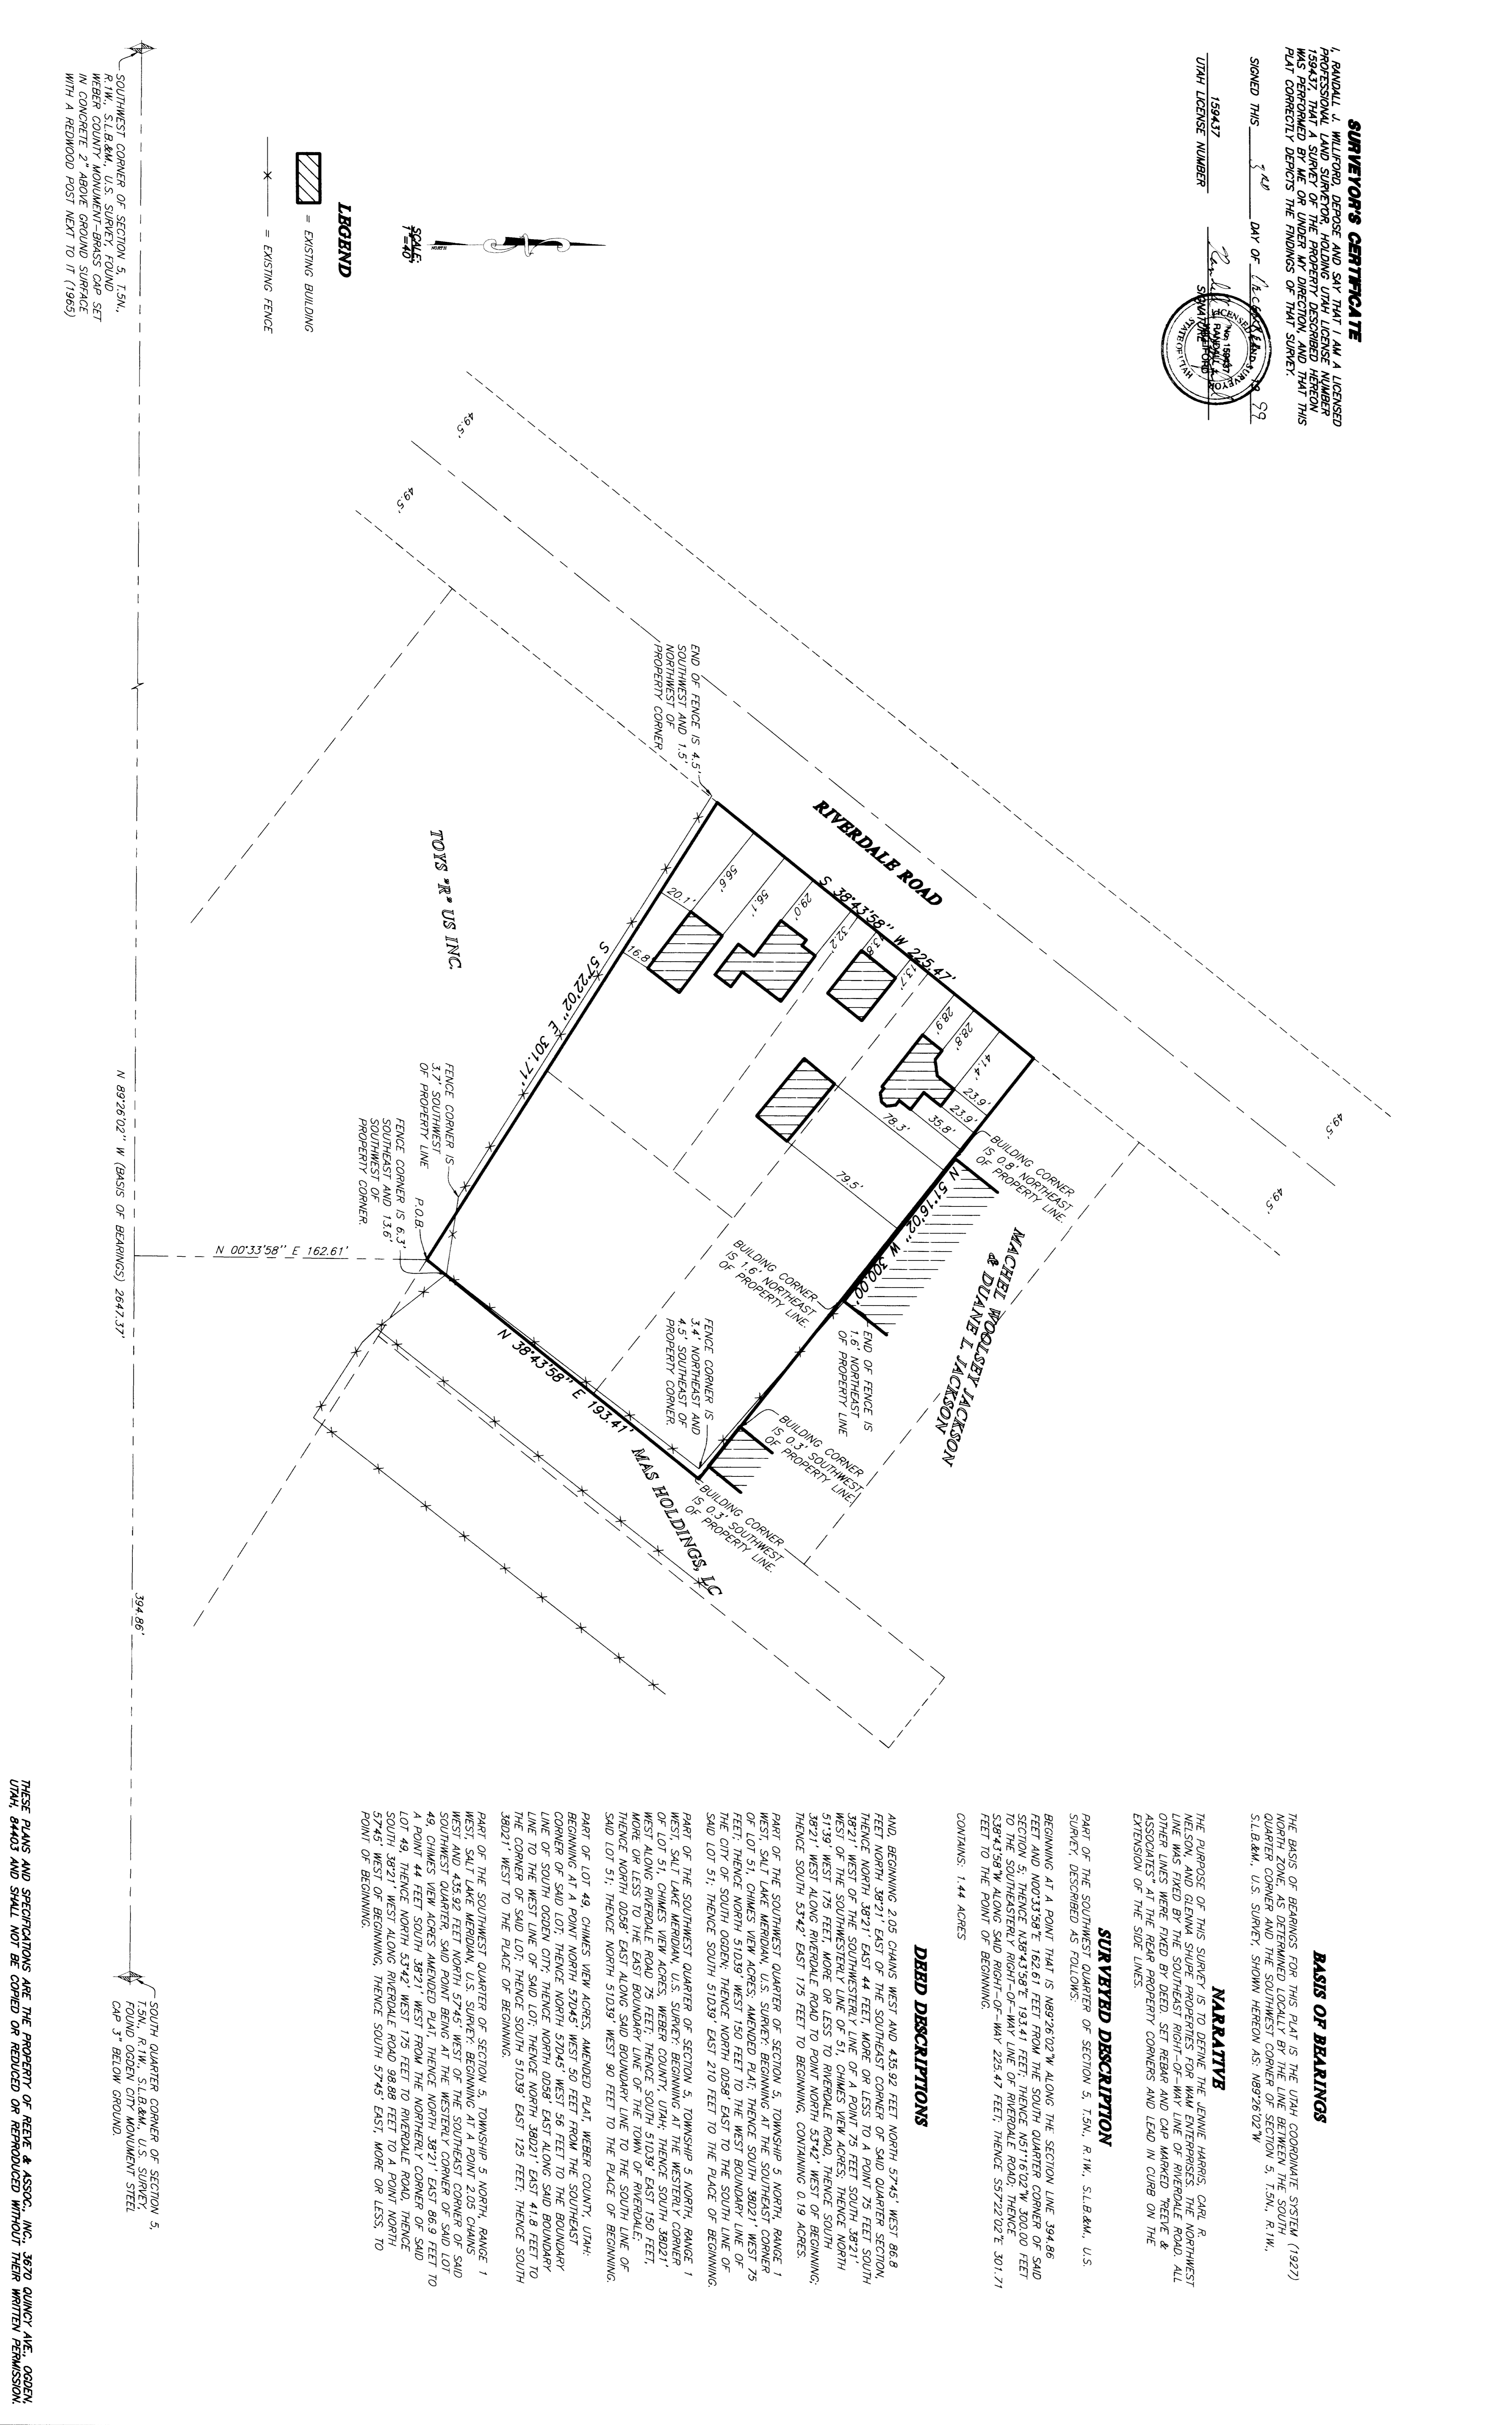

BASES OF BEARINGS

NARRATIVE

SURVEYED DESCRIPTION

DEED DESCRIPTIONS
WEST OF BEGINNING; THENCE SOUTH 53°42' EAST 175 FEET TO BEGINNING, CONTAINING 0.19 ACRES.

PART OF THE SOUTHWEST QUARTER OF SECTION 5, TOWNSHIP 5 NORTH, RANGE 1 WEST, SALT LAKE MERIDIAN, U.S. SURVEY, BEGINNING AT THE WESTERLY CORNER OF LOT 51, CHIMES NEW ACRES, AMENDED PLAT; THENCE SOUTH 38°21' WEST 75 FEET; THENCE NORTH 51°03' WEST 150 FEET TO THE WEST BOUNDARY LINE OF THE CITY OF SOUTH OGDEN, THENCE NORTH 00°58' EAST TO THE SOUTH LINE OF SAID LOT 51; THENCE SOUTH 51°03' EAST 210 FEET TO THE PLACE OF BEGINNING.

PART OF THE SOUTHWEST QUARTER OF SECTION 5, TOWNSHIP 5 NORTH, RANGE 1 WEST, SALT LAKE MERIDIAN, U.S. SURVEY, BEGINNING AT THE WESTERLY CORNER OF SAID LOT 49, CHIMES NEW ACRES, AMENDED PLAT, WEBER COUNTY, UTAH; THENCE NORTH 00°58' EAST ALONG SAID BOUNDARY LINE TO THE SOUTH LINE OF SAID LOT 51; THENCE NORTH 51°03' WEST 90 FEET TO THE PLACE OF BEGINNING.

PART OF LOT 49, CHIMES NEW ACRES, AMENDED PLAT, WEBER COUNTY, UTAH; BEGINNING AT A POINT NORTH 57°45' WEST 50 FEET FROM THE SOUTHWEST CORNER OF SAID LOT; THENCE NORTH 57°45' WEST 56 FEET TO THE BOUNDARY LINE OF SOUTH OGDEN, CITY OF SOUTH OGDEN, ASY CONG. EAST 150 FEET TO THE CORNER OF SAID LOT; THENCE SOUTH 51°03' EAST 125 FEET; THENCE SOUTH 38°21' WEST TO THE PLACE OF BEGINNING.

PART OF THE SOUTHWEST QUARTER OF SECTION 5, TOWNSHIP 5 NORTH, RANGE 1 WEST, SALT LAKE MERIDIAN, U.S. SURVEY, BEGINNING AT A POINT 2.05 CHAINS WEST AND 435.82 FEET NORTH, 57°45' WEST OF THE SOUTHWEST CORNER OF SAID SOUTHWEST QUARTER, SAID POINT BEING AT THE WESTERLY CORNER OF SAID LOT 49, CHIMES NEW ACRES, AMENDED PLAT, WEBER COUNTY, UTAH; THENCE SOUTH 38°21' WEST 175 FEET TO RIVERDALE ROAD, THENCE SOUTH 38°21' WEST ALONG RIVERDALE ROAD 98.88 FEET TO A POINT NORTH 57°45' WEST OF BEGINNING, THENCE SOUTH 57°45' EAST, MORE OR LESS, TO POINT OF BEGINNING.


THESE PLANS AND SPECIFICATIONS ARE THE PROPERTY OF REEVE & ASSOC., INC., 3870 QUINCY AVE., OGDEN, UTAH, 84403 AND SHALL NOT BE COPIED OR REDUCED OR REPRODUCED WITHOUT THEIR WRITTEN PERMISSION.