

REVISIONS

1.	_____	4.	_____
2.	_____	5.	_____
3.	_____	6.	_____

PROJECT NO. 202-01 SURVEYOR R. MILLER

DATE SEPTEMBER 23, 1999 DRAWN N. HADDOCK



SCALE 1" = 40' CHECKED \_\_\_\_\_

**REEVE & ASSOCIATES, INC.**  
Civil Engineering • Structural Engineering  
Surveying • Planning • Landscape Architecture  
3670 Old Orchard Lane, Suite 110  
Ogden, Utah 84403  
(801) 621-3100 FAX (801) 621-2868 (435) 752-3100 FAX (435) 752-2868

**RECORD OF SURVEY**

**STREBEL PROPERTY**  
A PORTION OF LOT 23 AND ALL OF LOTS 24 AND 25, BLOCK 2, TERRACE SUBDIVISION, OGDEN CITY, WASHINGTON BOULEVARD AND WASHINGTON BOULEVARD, OGDEN, UTAH, U.S. SURVEY  
SEPTEMBER 1999

SHEET **1**

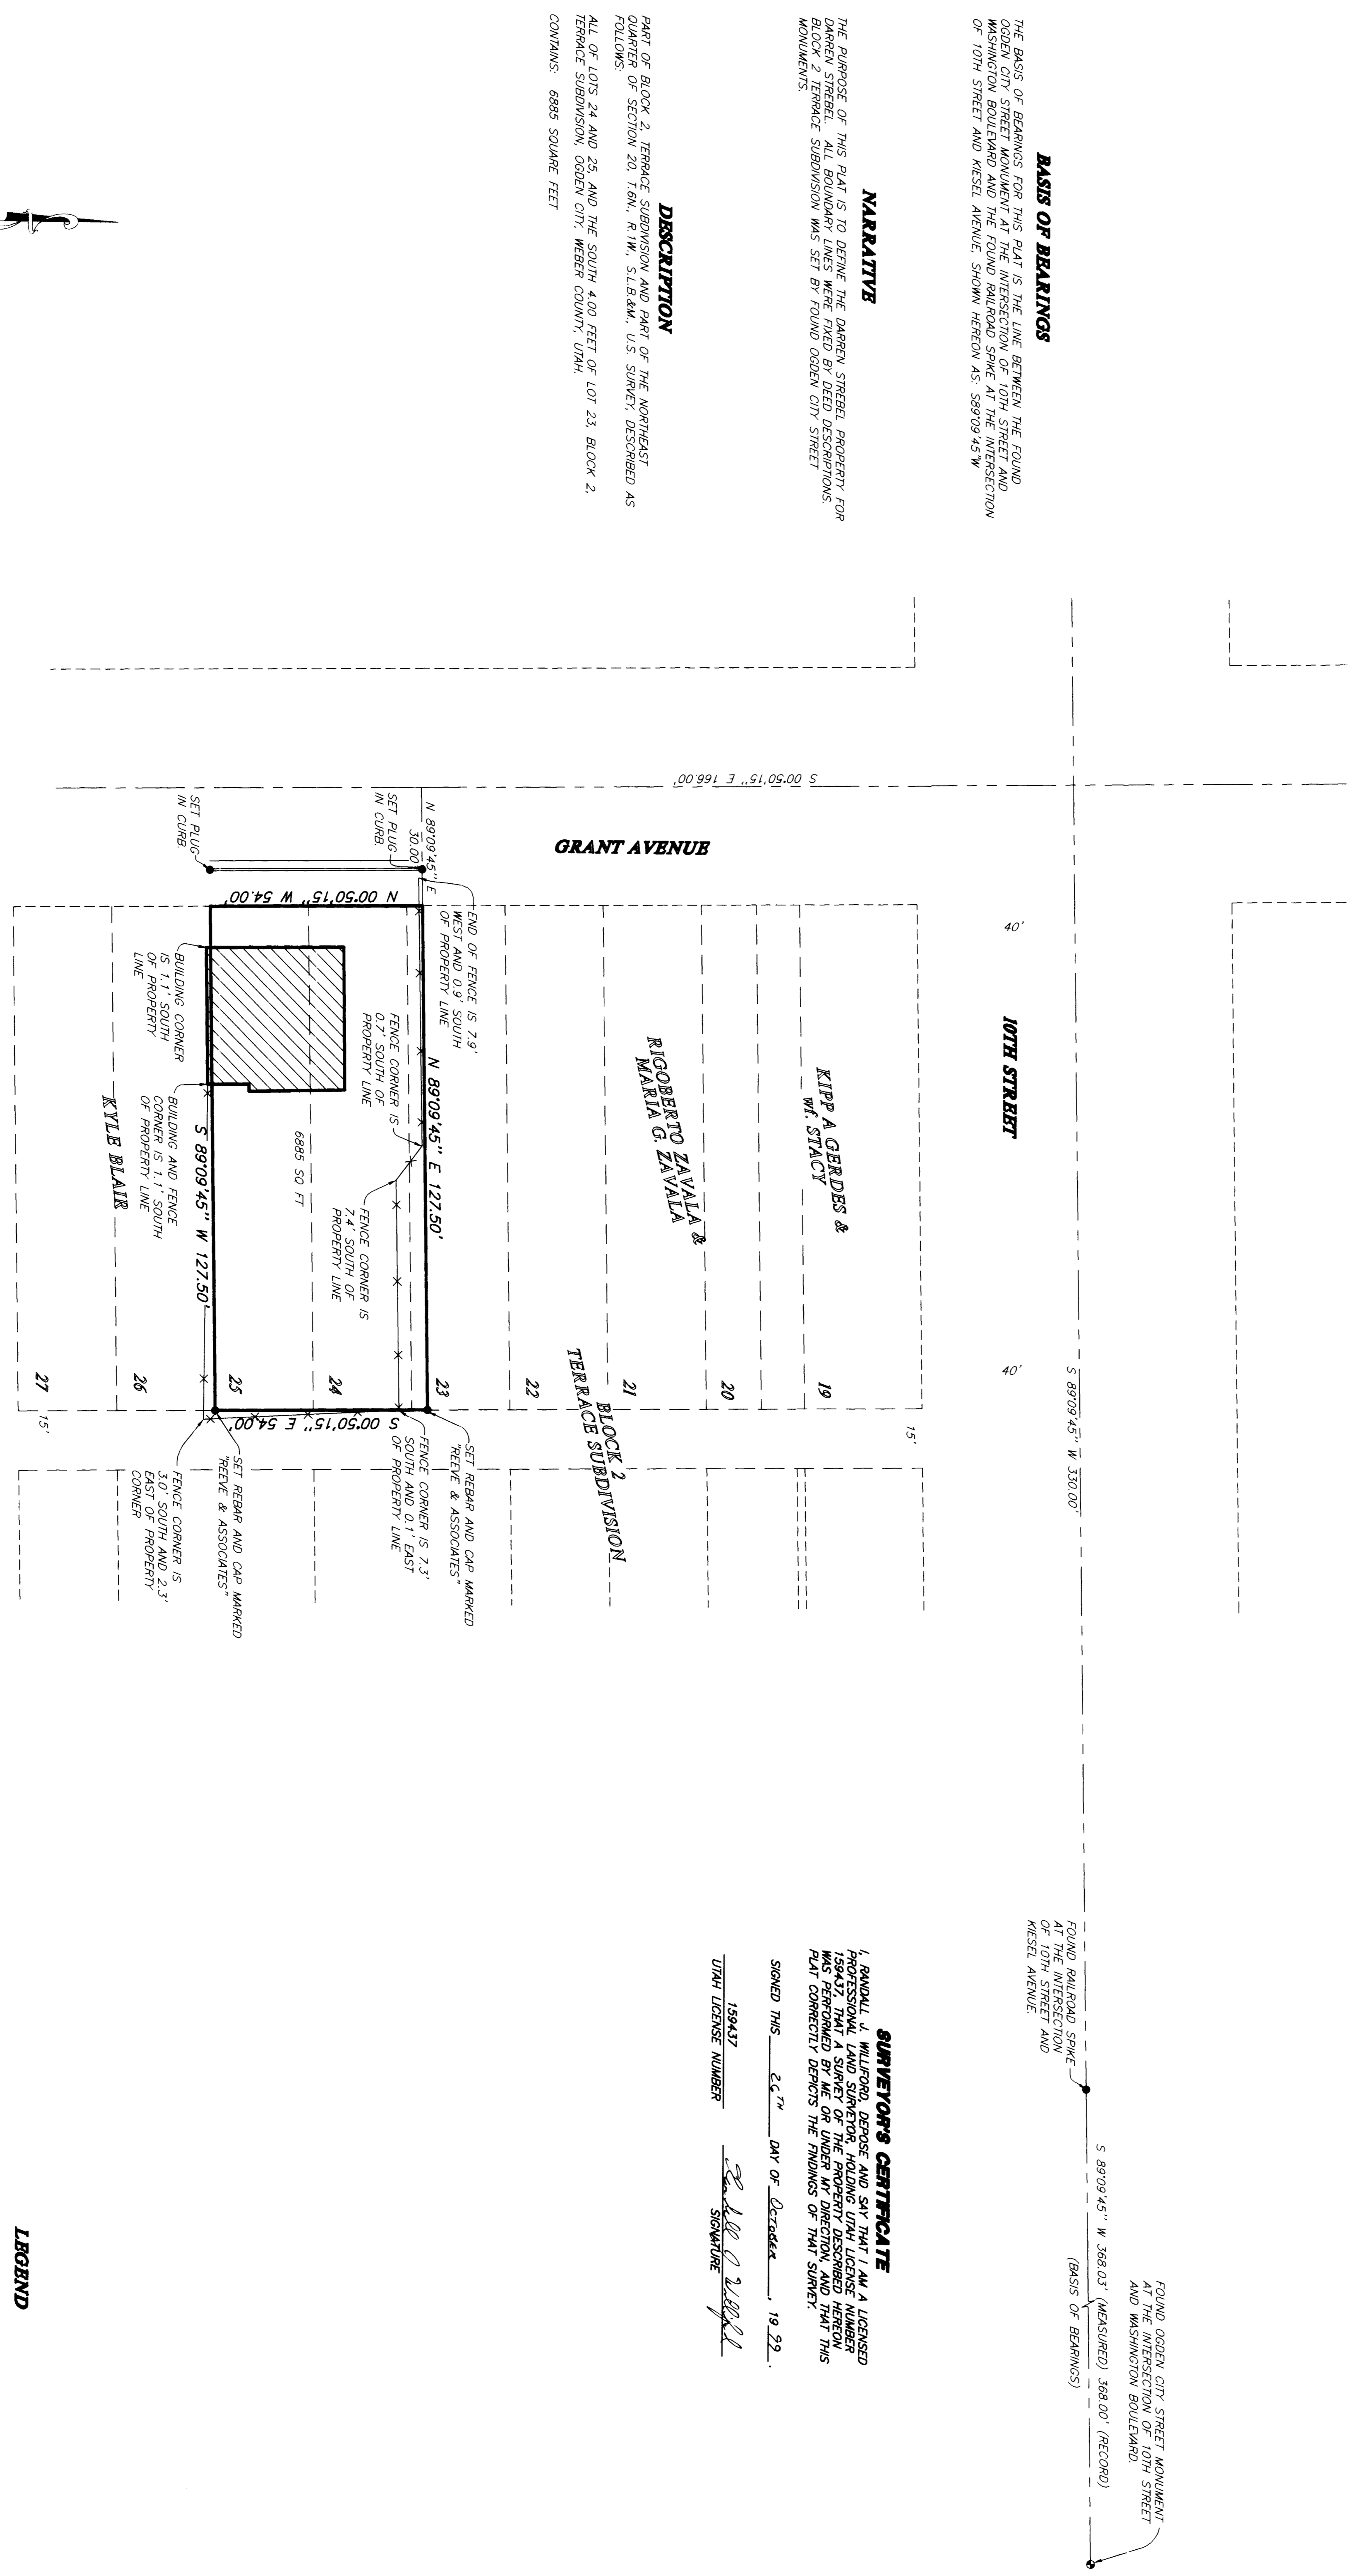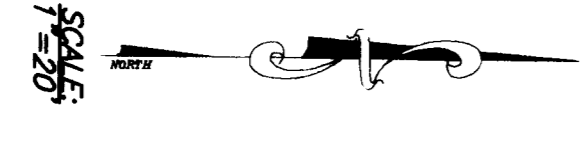

**NARRATIVE**

THE PURPOSE OF THIS PLAT IS TO DEFINE THE DARREN STREET PROPERTY FOR BLOCK 2 TERRACE SUBDIVISION WAS SET BY FOUND OGDEN CITY STREET MONUMENTS.

**DESCRIPTION**

CONTAINS 6885 SQUARE FEET

**BASIS OF BEARINGS**

THE BASIS OF BEARINGS FOR THIS PLAT IS THE LINE BETWEEN THE FOUND OGDEN CITY STREET MONUMENT AT THE INTERSECTION OF 10TH STREET AND OF 10TH STREET AND KESEL AVENUE, SHOWN HEREON AS S89°09'45"W

**SURVEYOR CERTIFICATE**




**LEGEND**

●	= FOUND OGDEN CITY STREET MONUMENT
•	= FOUND RAILROAD SPIKE
-x-	= EXISTING FENCE
[Hatched Box]	= EXISTING BUILDING