

G:\DRAWINGS\SHARED\3593\01-reg\BNDRY.dwg Thu Dec 02 15:06:41 1999 H.GLANZ

REVISIONS

1.					
2.					
3.					
4.					
5.					
6.					


PROJECT NO. 3593-01 SURVEYOR: J. HAMILTON  
DATE: JUNE 28, 1999 DRAWN: M. BARBER  
SCALE: 1"=50' CHECKED: \_\_\_\_\_

**REEVE & ASSOCIATES, INC.**  
ENGINEERING, PLANNING & SURVEYING  

**RECORD OF SURVEY**

**ALL OF LOT 2 BAY VIEW ESTATES SUBDIVISION**  
PART OF THE NORTHWEST QUARTER OF SECTION 14, T5N, R3W, S1/4, U.S. SURVEY  
CORNER OF SECTION 14, T5N, R3W, S1/4, U.S. SURVEY  
COUNTY OF WEBER, UTAH

SHEET 1 OF 1 SHEETS

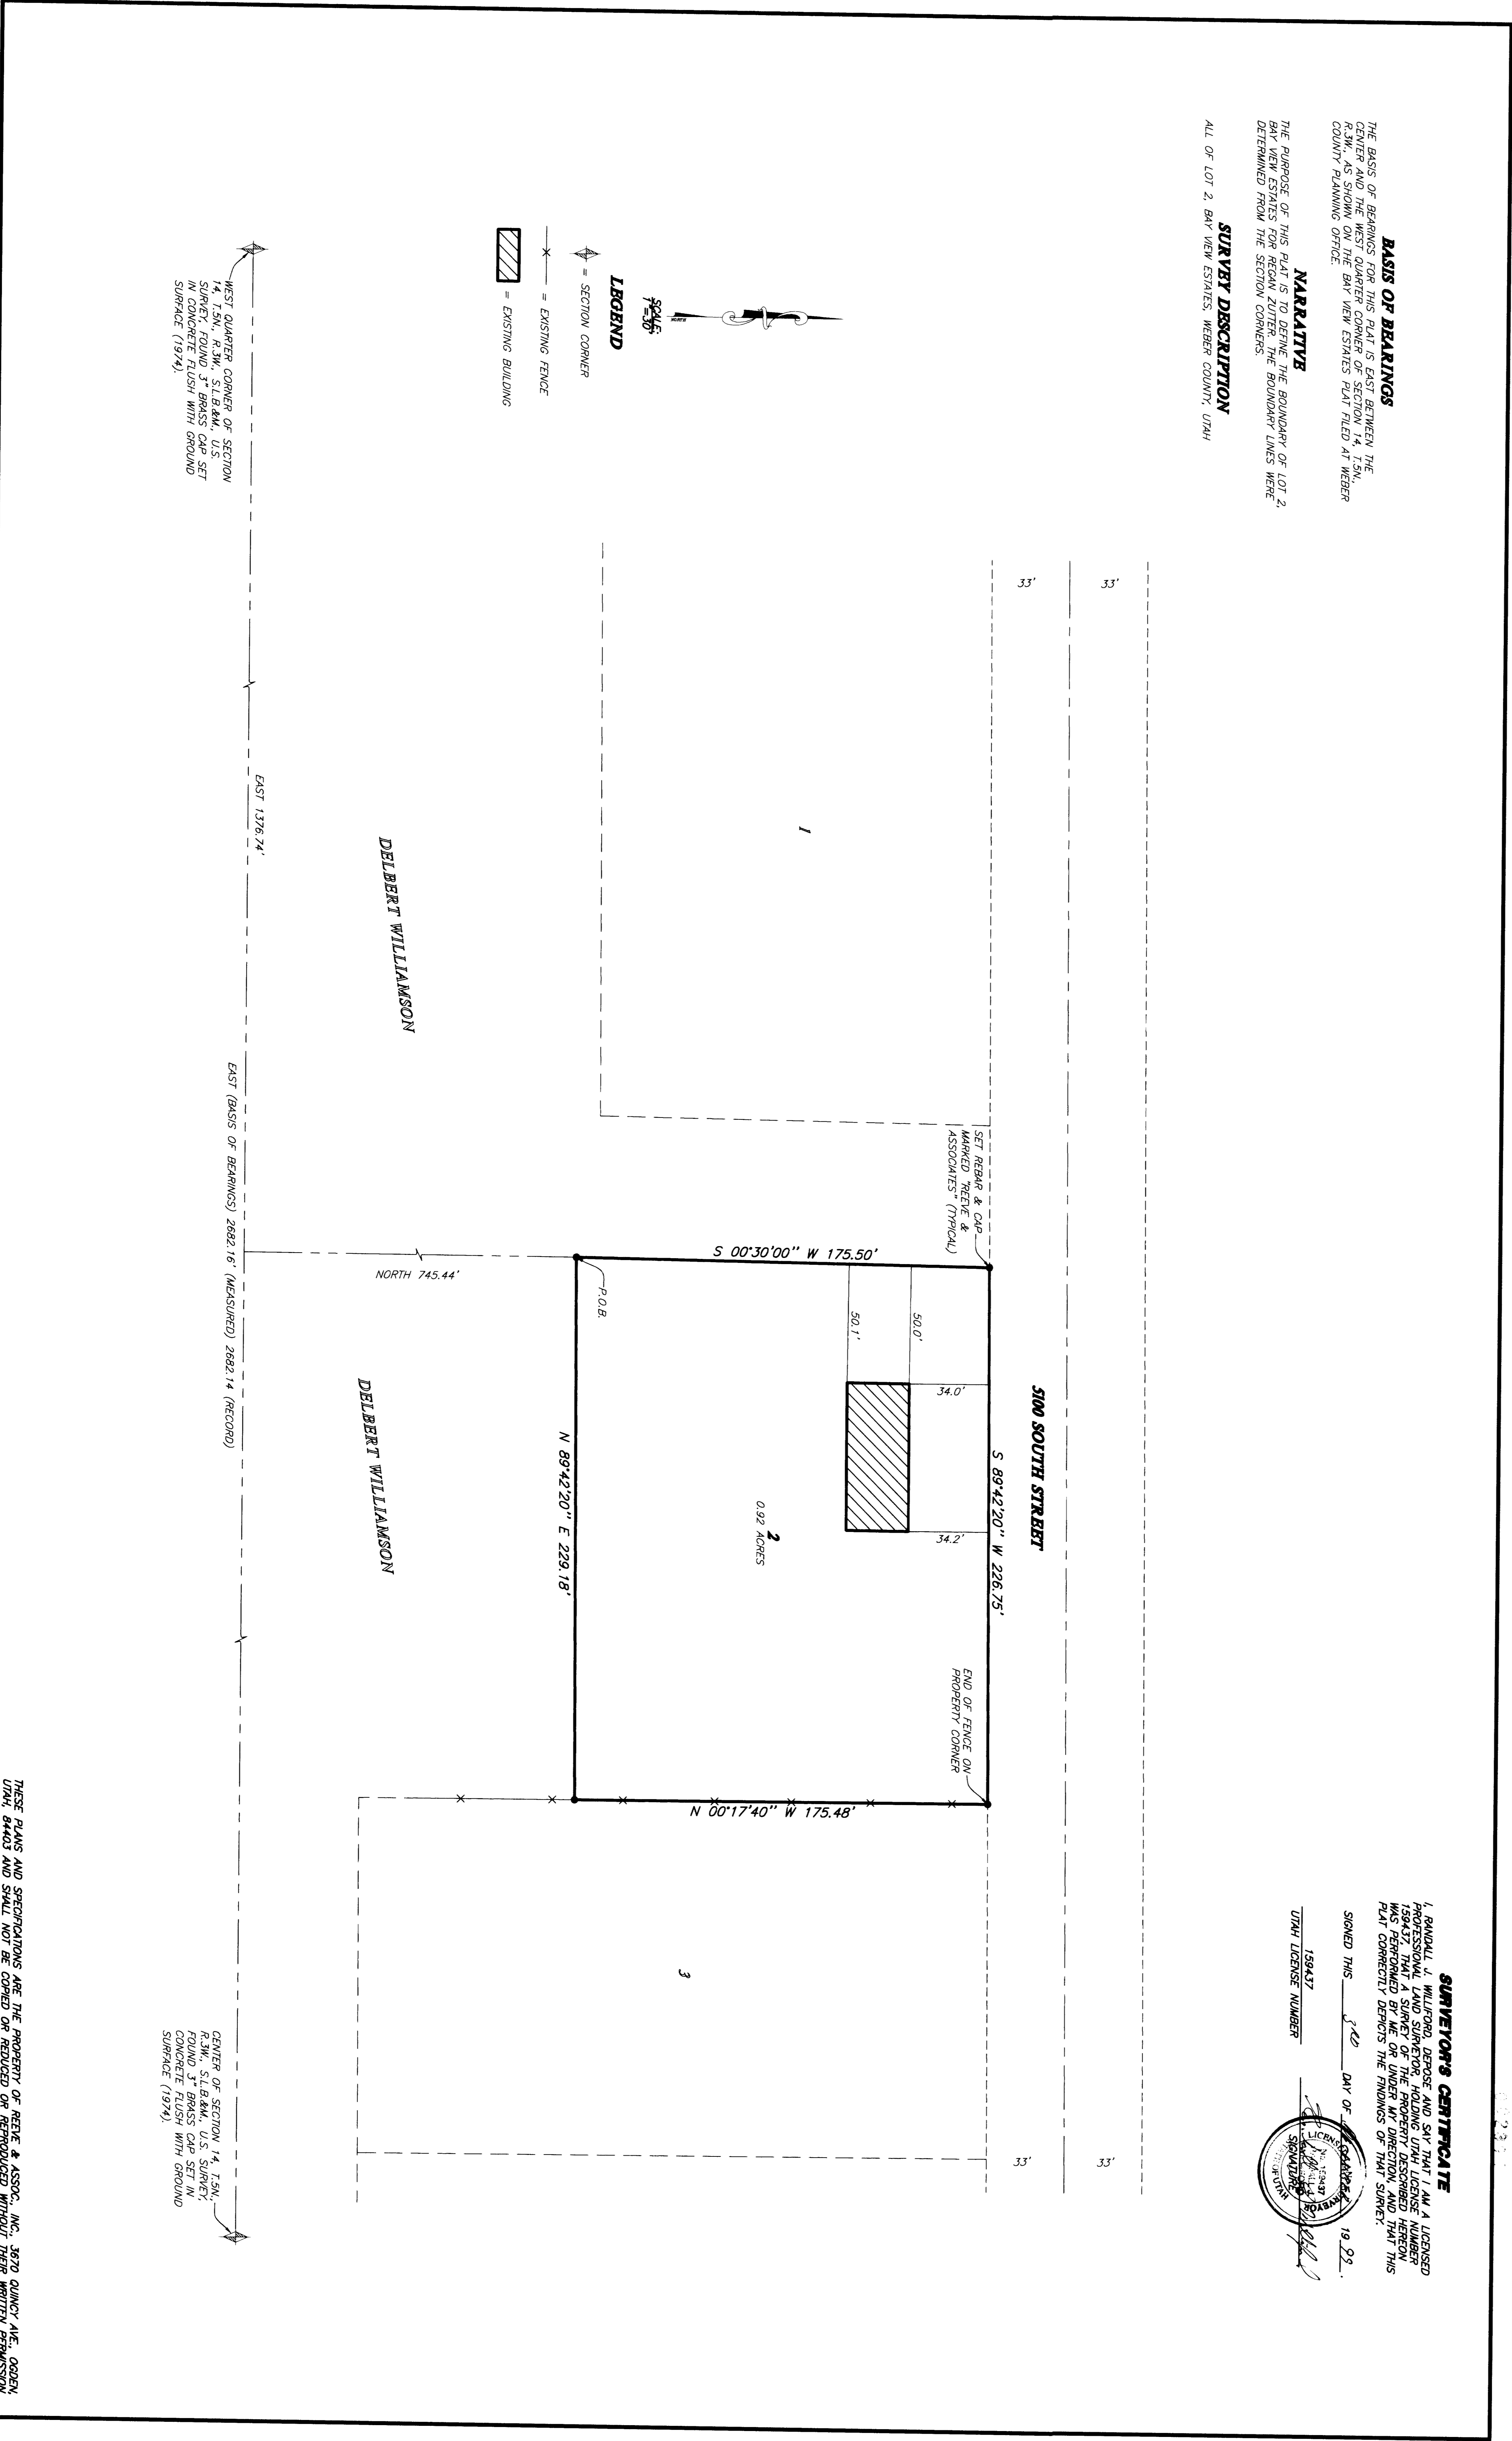

**SURVEYORS CERTIFICATE**  

