

G:\DRAWINGS\SHARED\3605\01-nr\survey.dwg Thu Sep 30 10:32:12 1998 H.GUNN

REGIONS

1	2	3	4	5	6


PROJECT NO. 98-01 SURVEY AREA 844300
DATE JUL 20, 1998 DRAWN BY J.A. DOORE
SCALE 1"=30' CHECKED BY

REEVE & ASSOCIATES, INC.
ENGINEERS PLANNERS & SURVEYORS

RECORD OF SURVEY

ALL OF LOT 83 VALLEY SIDE SUBDIVISION NO. 3
PART OF THE EAST HALF OF SECTION 13, T.5N., R.2W., S.L.B.M., U.S. SURVEY
A.C. 1, 1980

SHEET 1 OF 1 SHEETS

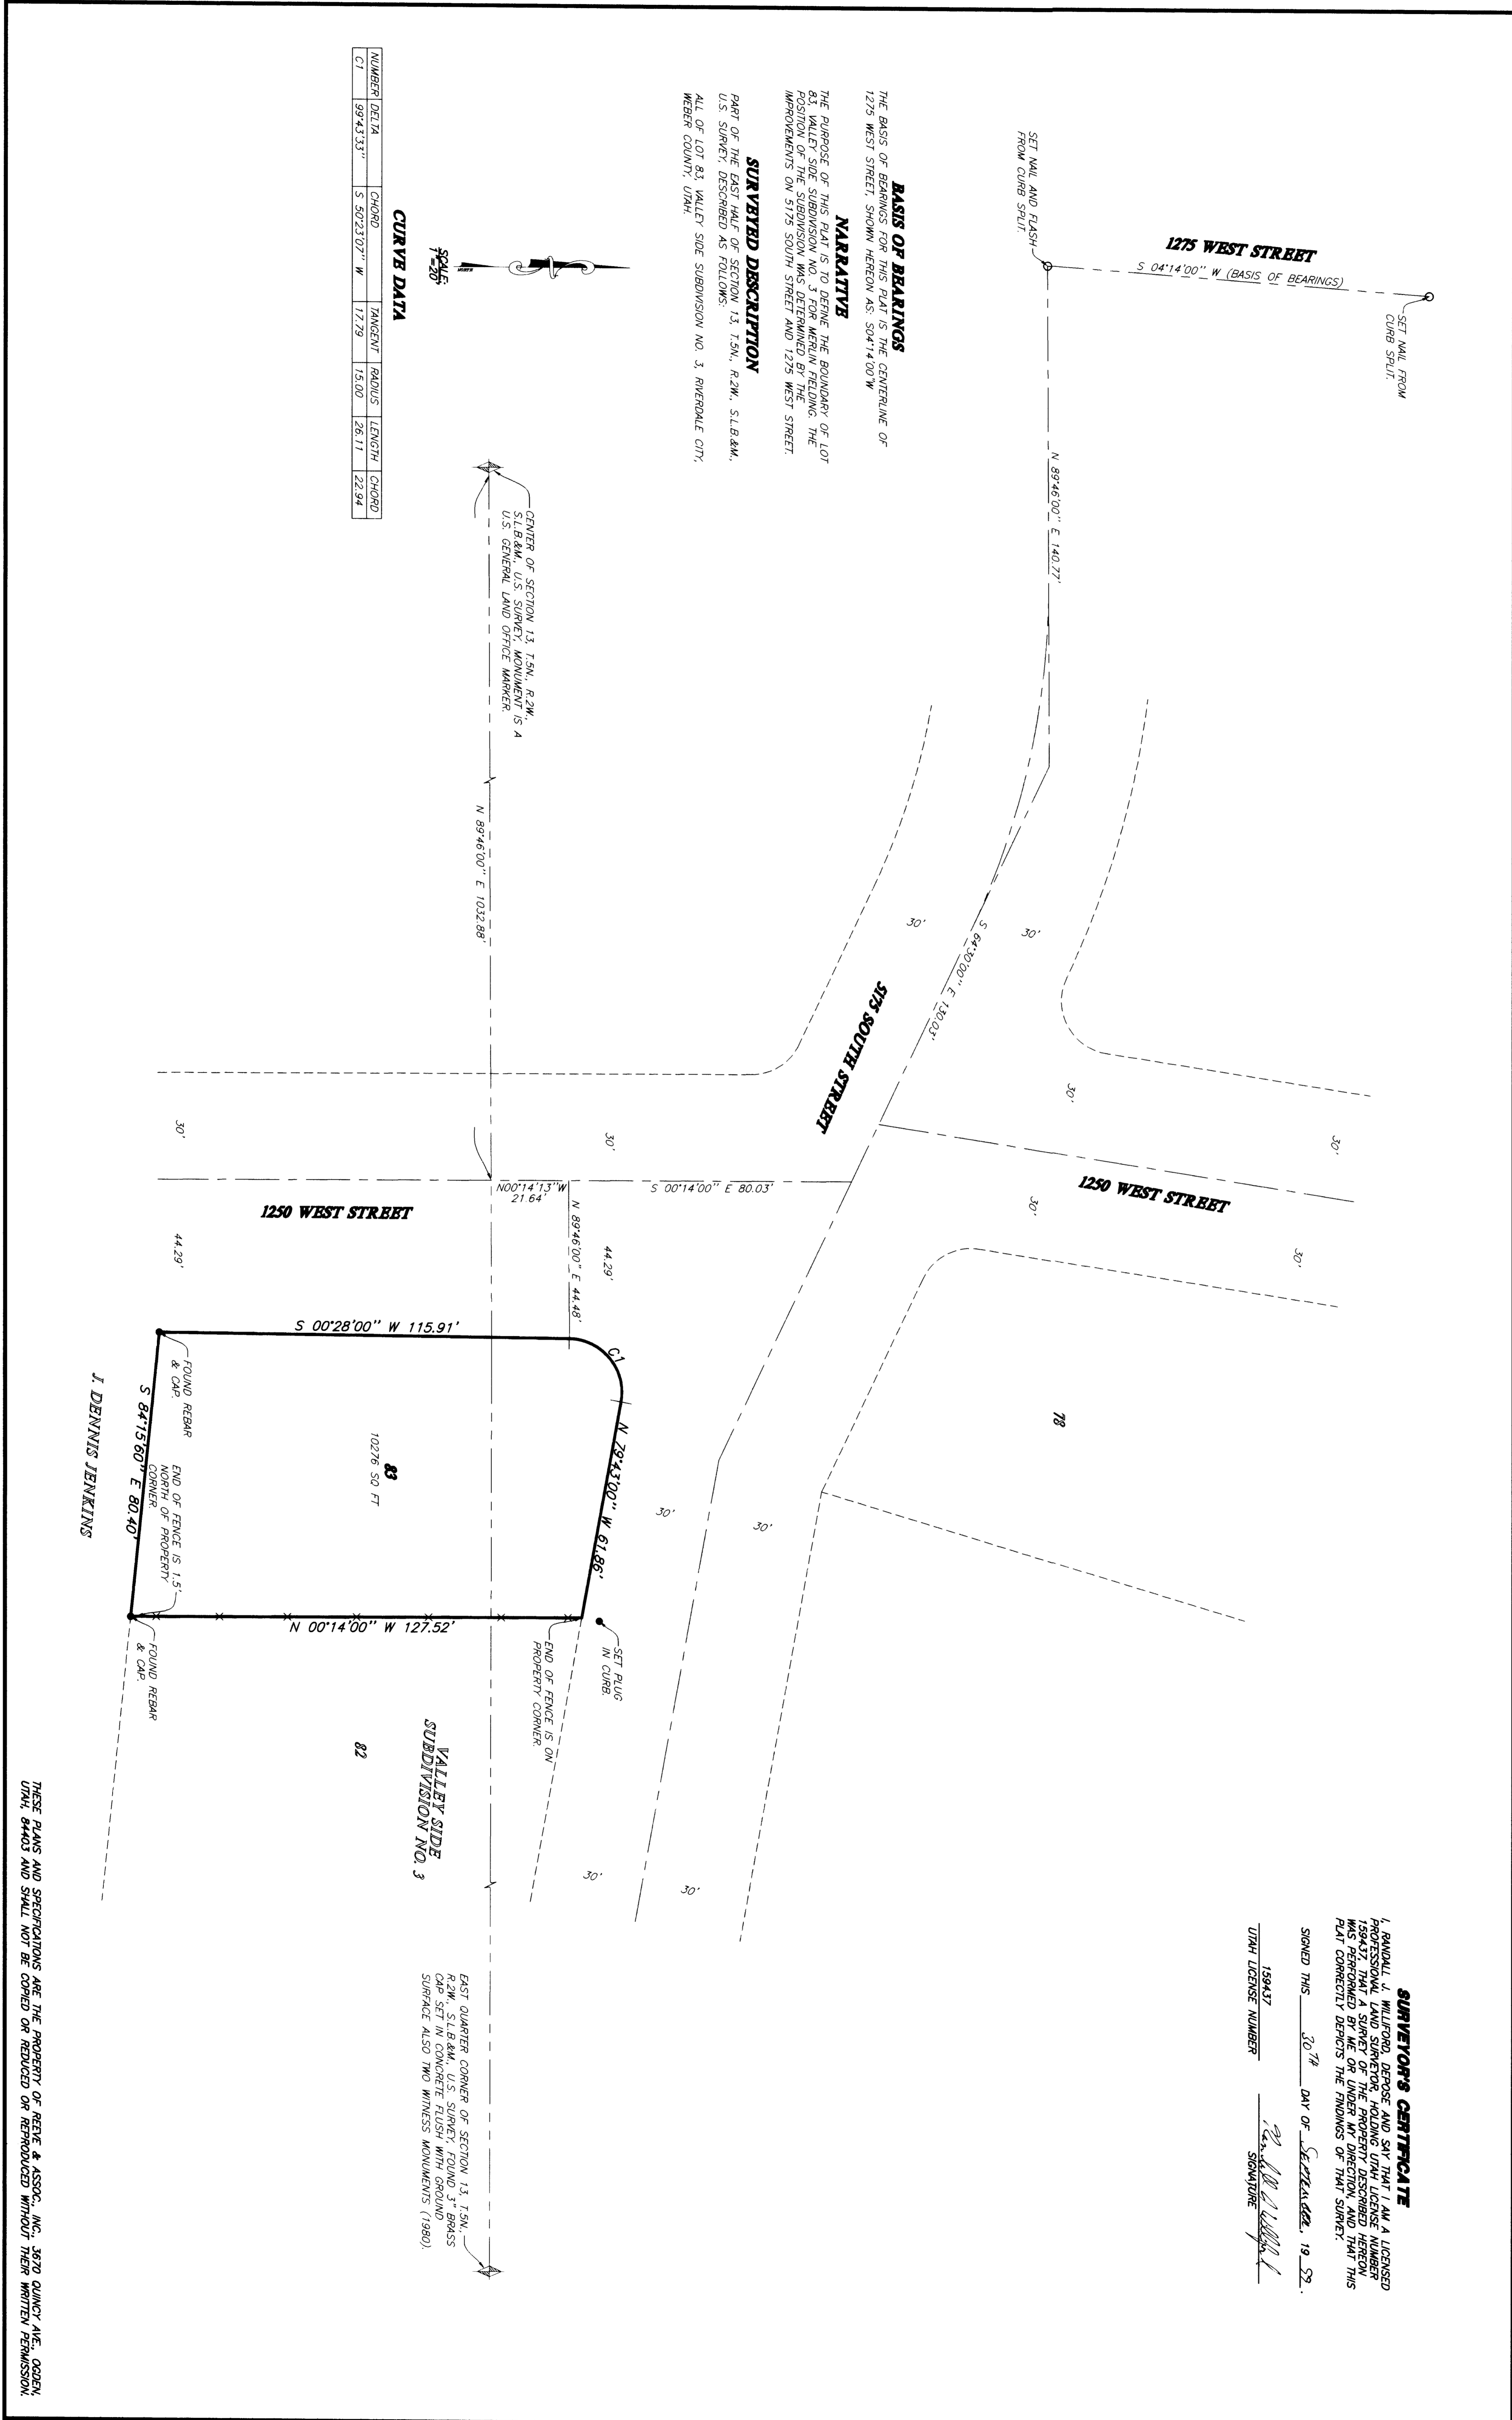

002392

002392