

NARRATIVE


The purpose of this survey is to locate the original lot corners according to the Evergreen Park Subdivision plat. There have been other corners used as the back line which do not conform to the official plat. They are as shown on this plat. Basis of bearing, N.79 39'45"W., is the southerly line of lots 314, 315 as established by a prior survey of Lot 315.

Note: Residence near line between lots 248 and 249 not shown.

LEGAL DESCRIPTION

All of lots 249, 250 according to the official plat thereof on file and of record with the Weber County Recorder's Office, Ogden, Utah.

MAY 3, 1998

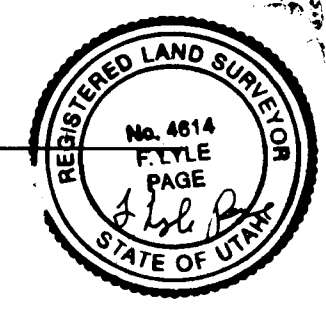

LEGEND

- Property corner— set 5/8" rebar and yellow cap 4 places.

RECEIVED  
FEB 11 2000  
Mark Hammond Surveyor

SURVEY FOR		SECTION	TOWNSHIP	RANGE	DATE	SCALE
Mark Hammond P.O. Box 35 Huntsville, Utah 84317		31	7 No.	3 E.	5-09-98	1"=80'
LOT	BLOCK	PLAT	SURVEY			
249		1	EVERGREEN PARK SUBDIVISION			

CONTRACT SURVEYORS  
REGISTERED LAND SURVEYORS  
9740 SO. SITZMARK DR. SANDY, UTAH

002405

002405