


002407




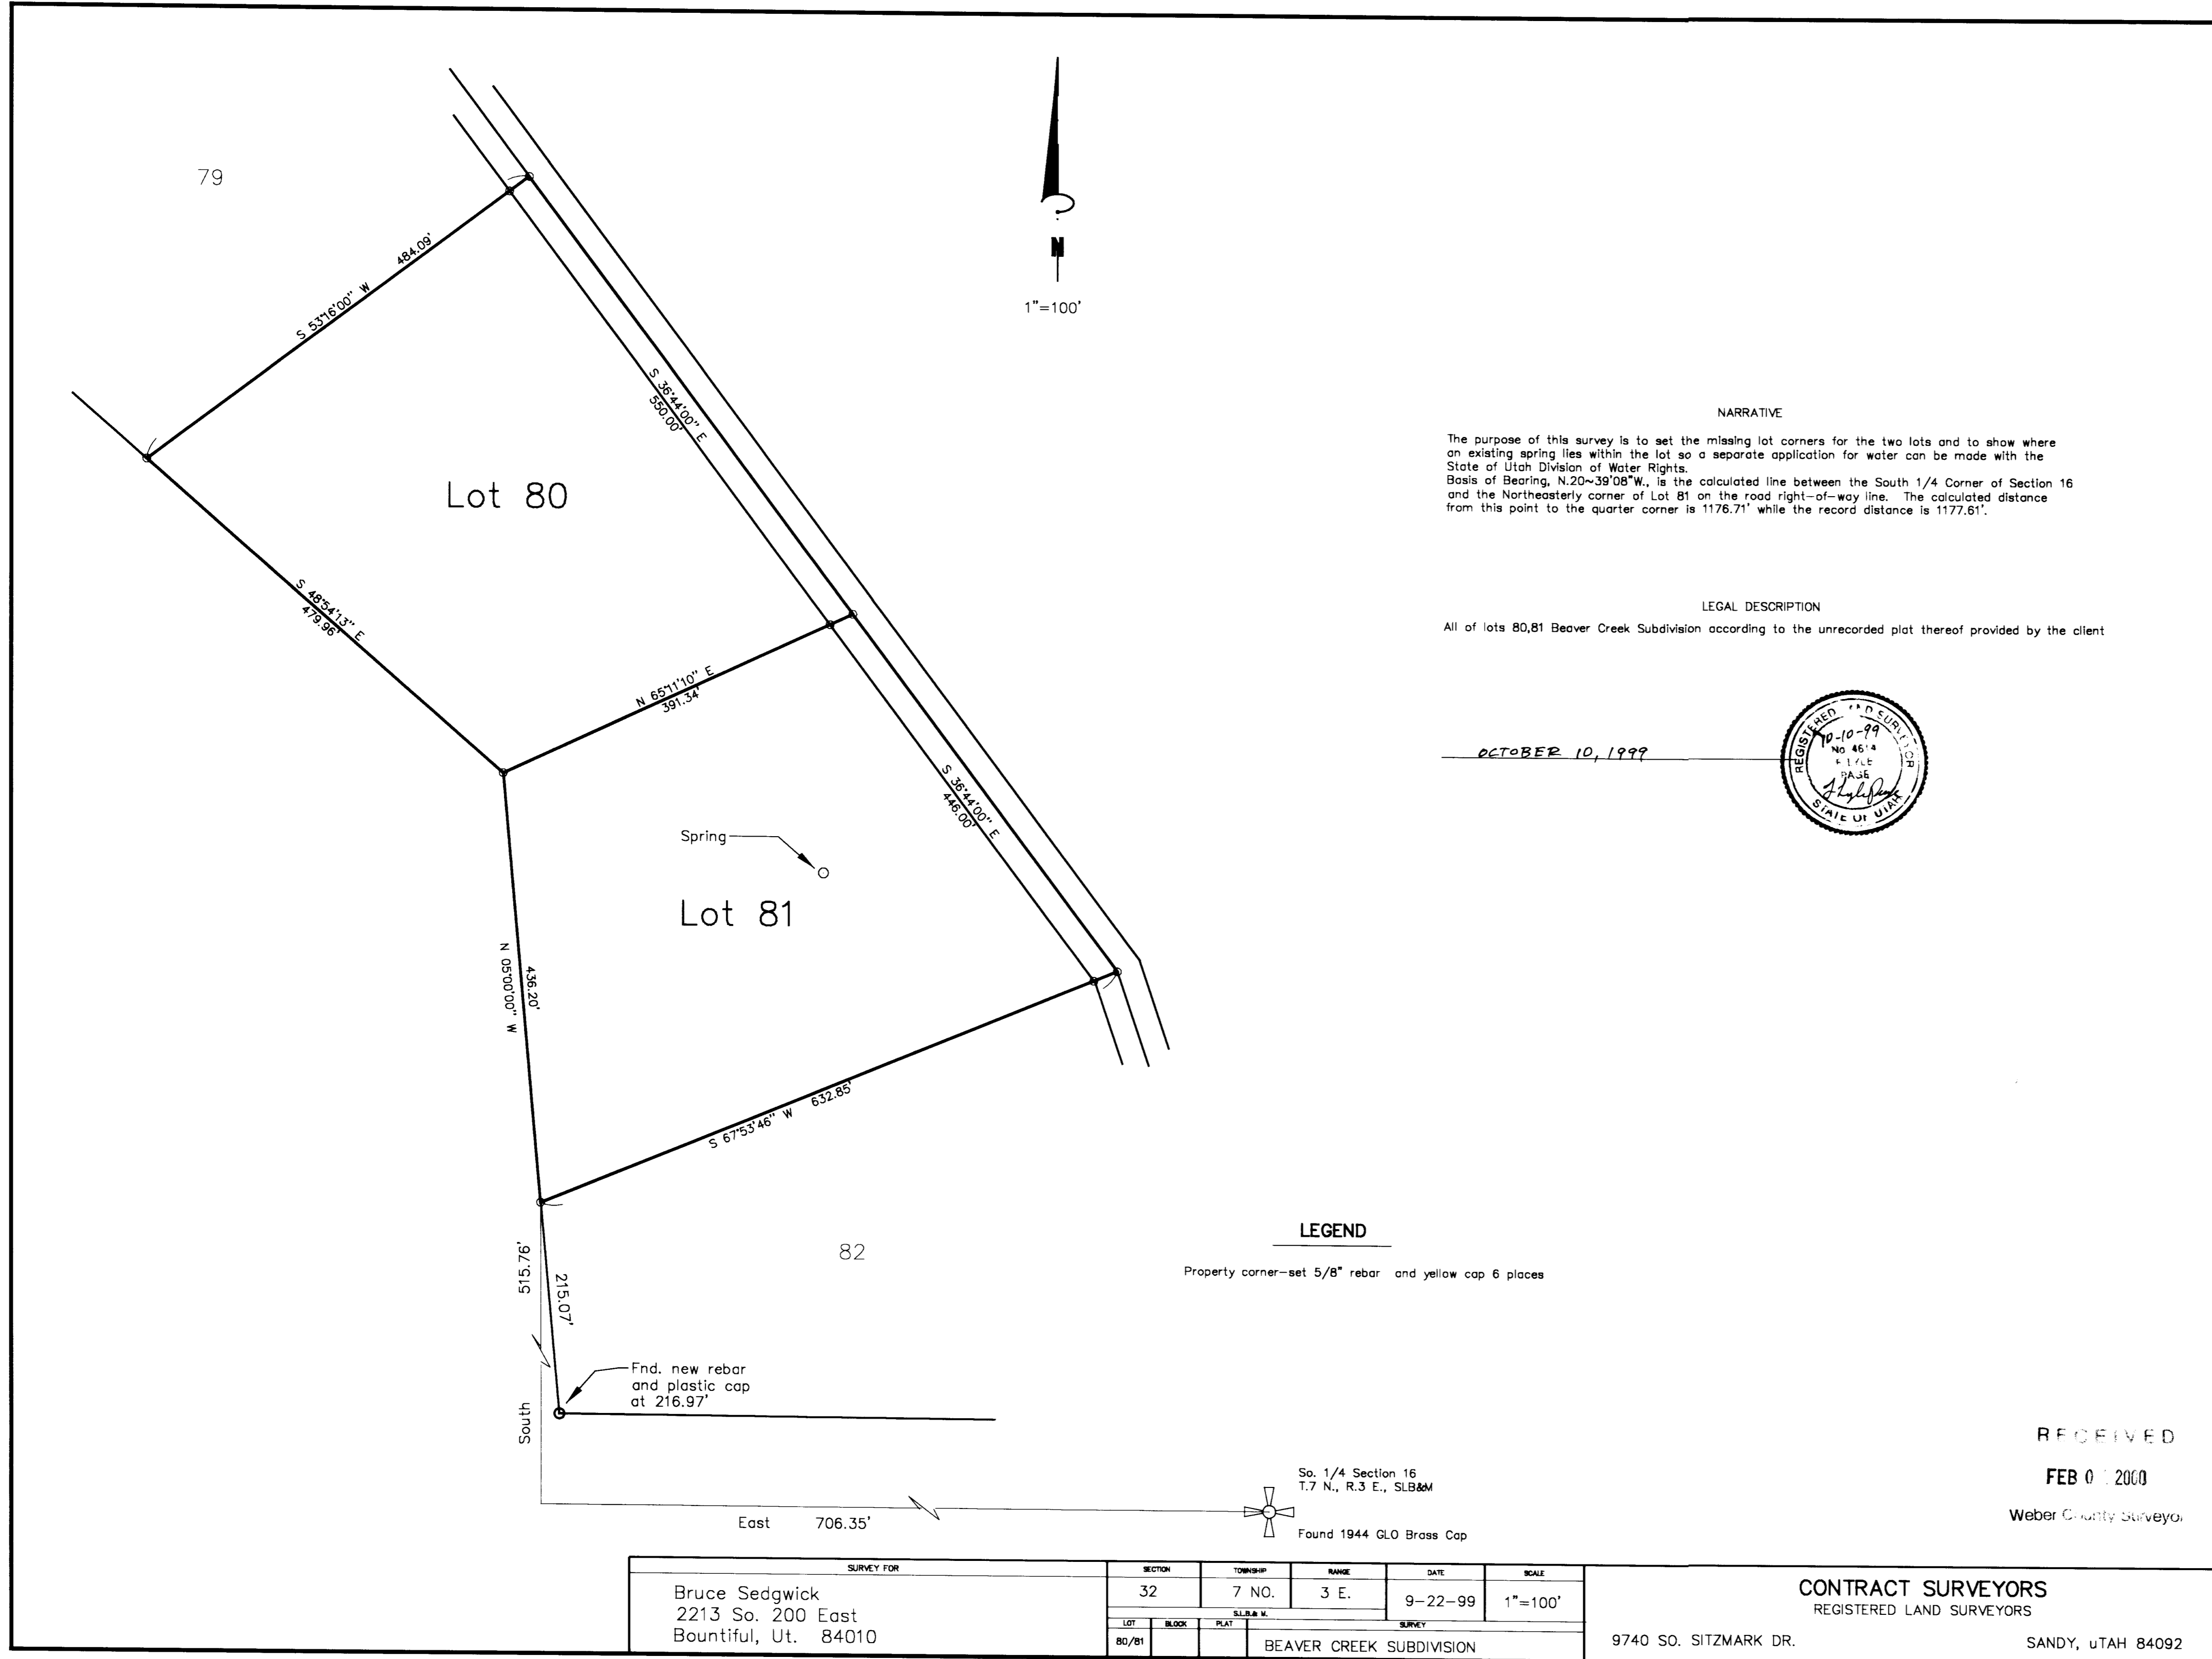


