


NARRATIVE

The purpose of this survey is to locate and verify the lot corners of lot 311. The westerly lot corners were set during a survey of adjacent lot 310 and were used for control to set the easterly corners. Control for the 1981 survey was a traverse through the 5 exterior section and quarter corners of the Evergreen Park Subdivision using as basis of bearing the NE subdivision section corner and the quarter corner to the west, N.89 11'07\"W.

LEGAL DESCRIPTION

All of Lot 311, Evergreen Park Subdivision, according to the official plat thereof on file and of record with the Weber County Recorder's Office, Ogden, Utah.

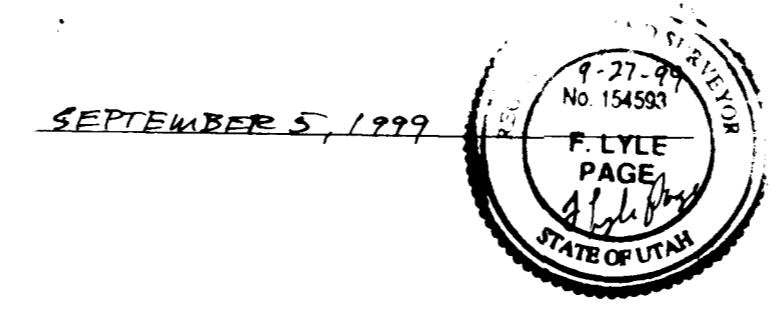

LEGEND

- Property corner—set 5/8\" rebar and yellow cap at northeast corner and southeast corner
- Found rebar and caps set in prior survey at two westerly corners
- ⊕ Power Pole

RECEIVED
FEB 0 2000
Weber County Surveyor

SYNTHIA SMITH 1158 NORTH 158 WEST LAYTON, UTAH 84041		SECTION NW 1/4 37	TOWNSHIP 7 No.	RANGE 3 E.	DATE 9-04-99	SCALE 1\"=60'
LOT 311	BLOCK	PLAT	SURVEY EVERGREEN PARK SUBDIVISION NO. 1			
			9740 So. Sitzmark Dr.		SANDY, UT. 84092	