


NARRATIVE

The purpose of this survey is to locate and verify the lot corners of lot 310. Control for the 1981 survey was a traverse through the 5 exterior section and quarter corners of the Evergreen Park Subdivision using as basis of bearing the NE subdivision section corner and the quarter corner to the west, N.89 11'07"W.

LEGAL DESCRIPTION

All of Lot 310, Evergreen Park Subdivision, according to the official plat thereof on file and of record with the Weber County Recorder's Office, Ogden, Utah.

SEPTEMBER 5, 1999

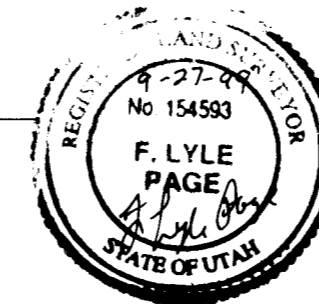

LEGEND

- Property corner—set 5/8" rebar and yellow cap at the four corners.
- ⊕ Power Pole

RECEIVED

FEB 02 2000

Weber County Surveyors

SURVEY FOR				SECTION	TOWNSHIP	RANGE	DATE	SCALE
Keith & Margie Kent 12780 Evergreen Park Drive Huntsville, Utah 84317				NW1/4 37	7 No.	3 E.	9-05-99	1"=60'
				S.L.B. & M.				
LOT	BLOCK	PLAT	SURVEY					
310			EVERGREEN PARK SUBDIVISION					

CONTRACT SURVEYORS
Registered Land Surveyors
9740 So. Sitzmark Dr. Sandy, Utah 84092