


o - Set 3/8" rebar 18 inches long with aluminum caps.

LEGEND

OR S
X X
S
S

BASIS OF BEARING:
S 00° 45' 37.4" W 1,175.04 FEET
BETWEEN THE WITNESS MONUMENT FOR THE
NORTHEAST CORNER, SECTION 13,
TOWNSHIP 6 NORTH, RANGE 2 WEST,
SALT LAKE BASE AND MERIDIAN
AND THE WEBER COUNTY MONUMENT
LOCATED AT THE INTERSECTION OF
200 SOUTH ST. & 1200 WEST ST.

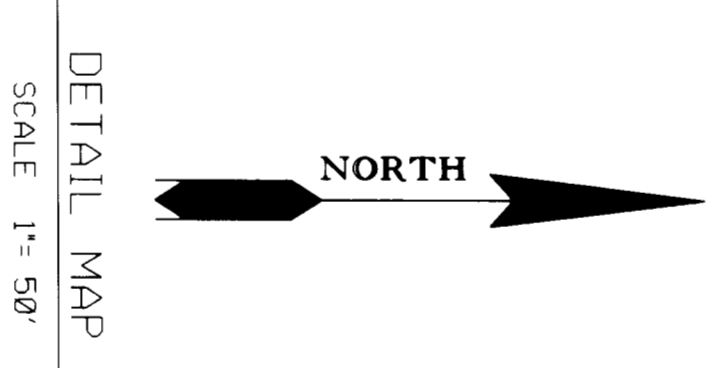

PROPERTY DESCRIPTION

A parcel of land located in the Northeast corner of Section 13, Township 6 North, Range 2 West, Salt Lake Base and Meridian, more particularly described as follows:
Beginning at a point 303.55 feet West and 18.35 feet South from a 1999 Weber County brass cap at the Northeast corner of said Section 13, thence N 85°10'01" E 70.00 feet, thence S 03°19'51" E 40.00 feet, thence S 86°10'01" W 70.00 feet, thence N 03°19'51" W 40.00 feet to the point of beginning.

ACCESS RIGHT-OF-WAY

Beginning at a point East 455.51 feet and South 23.23 feet from the Witness Corner to the Northeast corner of Section 13 (said Witness corner is located West 689.28 feet from said Northeast corner of Section 13, Township 6 North, Range 2 West, thence N 86°10'01" E 30.00 feet, thence S 3°19'51" E 40.00 feet, thence S 86°10'01" W 30.00 feet, thence N 03°19'51" W 40.00 feet to the point of beginning.

20 FT PIPELINE RIGHT-OF-WAY DESCRIPTION

A 20 foot right-of-way 10 feet each side of the following described centerline as follows to wit: Beginning at a point East 33.06 feet and South 58.80 feet from the Witness Corner to the Northeast corner of Section 13 (said Witness corner is located West 689.28 feet from said Northeast corner of Section 13, Township 6 North, Range 2 West, thence N 86°10'01" E 35.28 feet.

NARRATIVE

The purpose of this survey is to describe a parcel of ground located in the Northeast 1/4 of Section 13, 16N, 2W, Salt Lake Base and Meridian, to be used for natural gas facilities.

SURVEYOR'S CERTIFICATE

I, F. Lyle Page, do hereby certify that I am a registered Land Surveyor licensed under the laws of the State of Utah, and holding certificate #4614, do hereby certify that I have made a survey of the above described property, and that the plat herein is a true and correct representation of said survey.

DATE Feb 9, 2000 F. Lyle Page
F. Lyle Page
No. 4614

SURVEY LOCATION

NORTHEAST 1/4 SECTION 13
TOWNSHIP 6 NORTH, RANGE 2 WEST,
SALT LAKE BASE AND MERIDIAN
SURVEY DATE: JANUARY 20, 2000
BY: FLP & CSM
DRAWN: FEBRUARY 3, 2000
BY: M. HART



DRAWING SHOWING LAND SURVEY OF:
DISTRICT REGULATOR STATION WA1510
300 NORTH 1200 WEST
WEBER COUNTY, UTAH

RECEIVED
FEB 0 2000
Weber County Surveyor

PREPARED BY QUESTAR
REGULATED SERVICES COMPANY

QUESTAR
Gas
1140 WEST 200 SOUTH
SALT LAKE CITY, UTAH