

REVISIONS

1		4
2		5
3		6



PROJECT NO. 3615-010 SURVEYOR: A. GUNN
 DATE: 7-2-99 DRAWN: A. GUNN
 SCALE: 1"=100' CHECKED:

REEVE & ASSOCIATES, INC.
 ENGINEERING & SURVEYING
 3670 QUINCY AVE. SUITE 200

RECORD OF SURVEY

CLARKE PROPERTY

SHEET	1
SHEETS	1

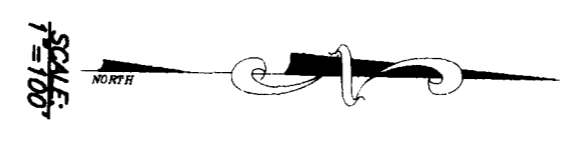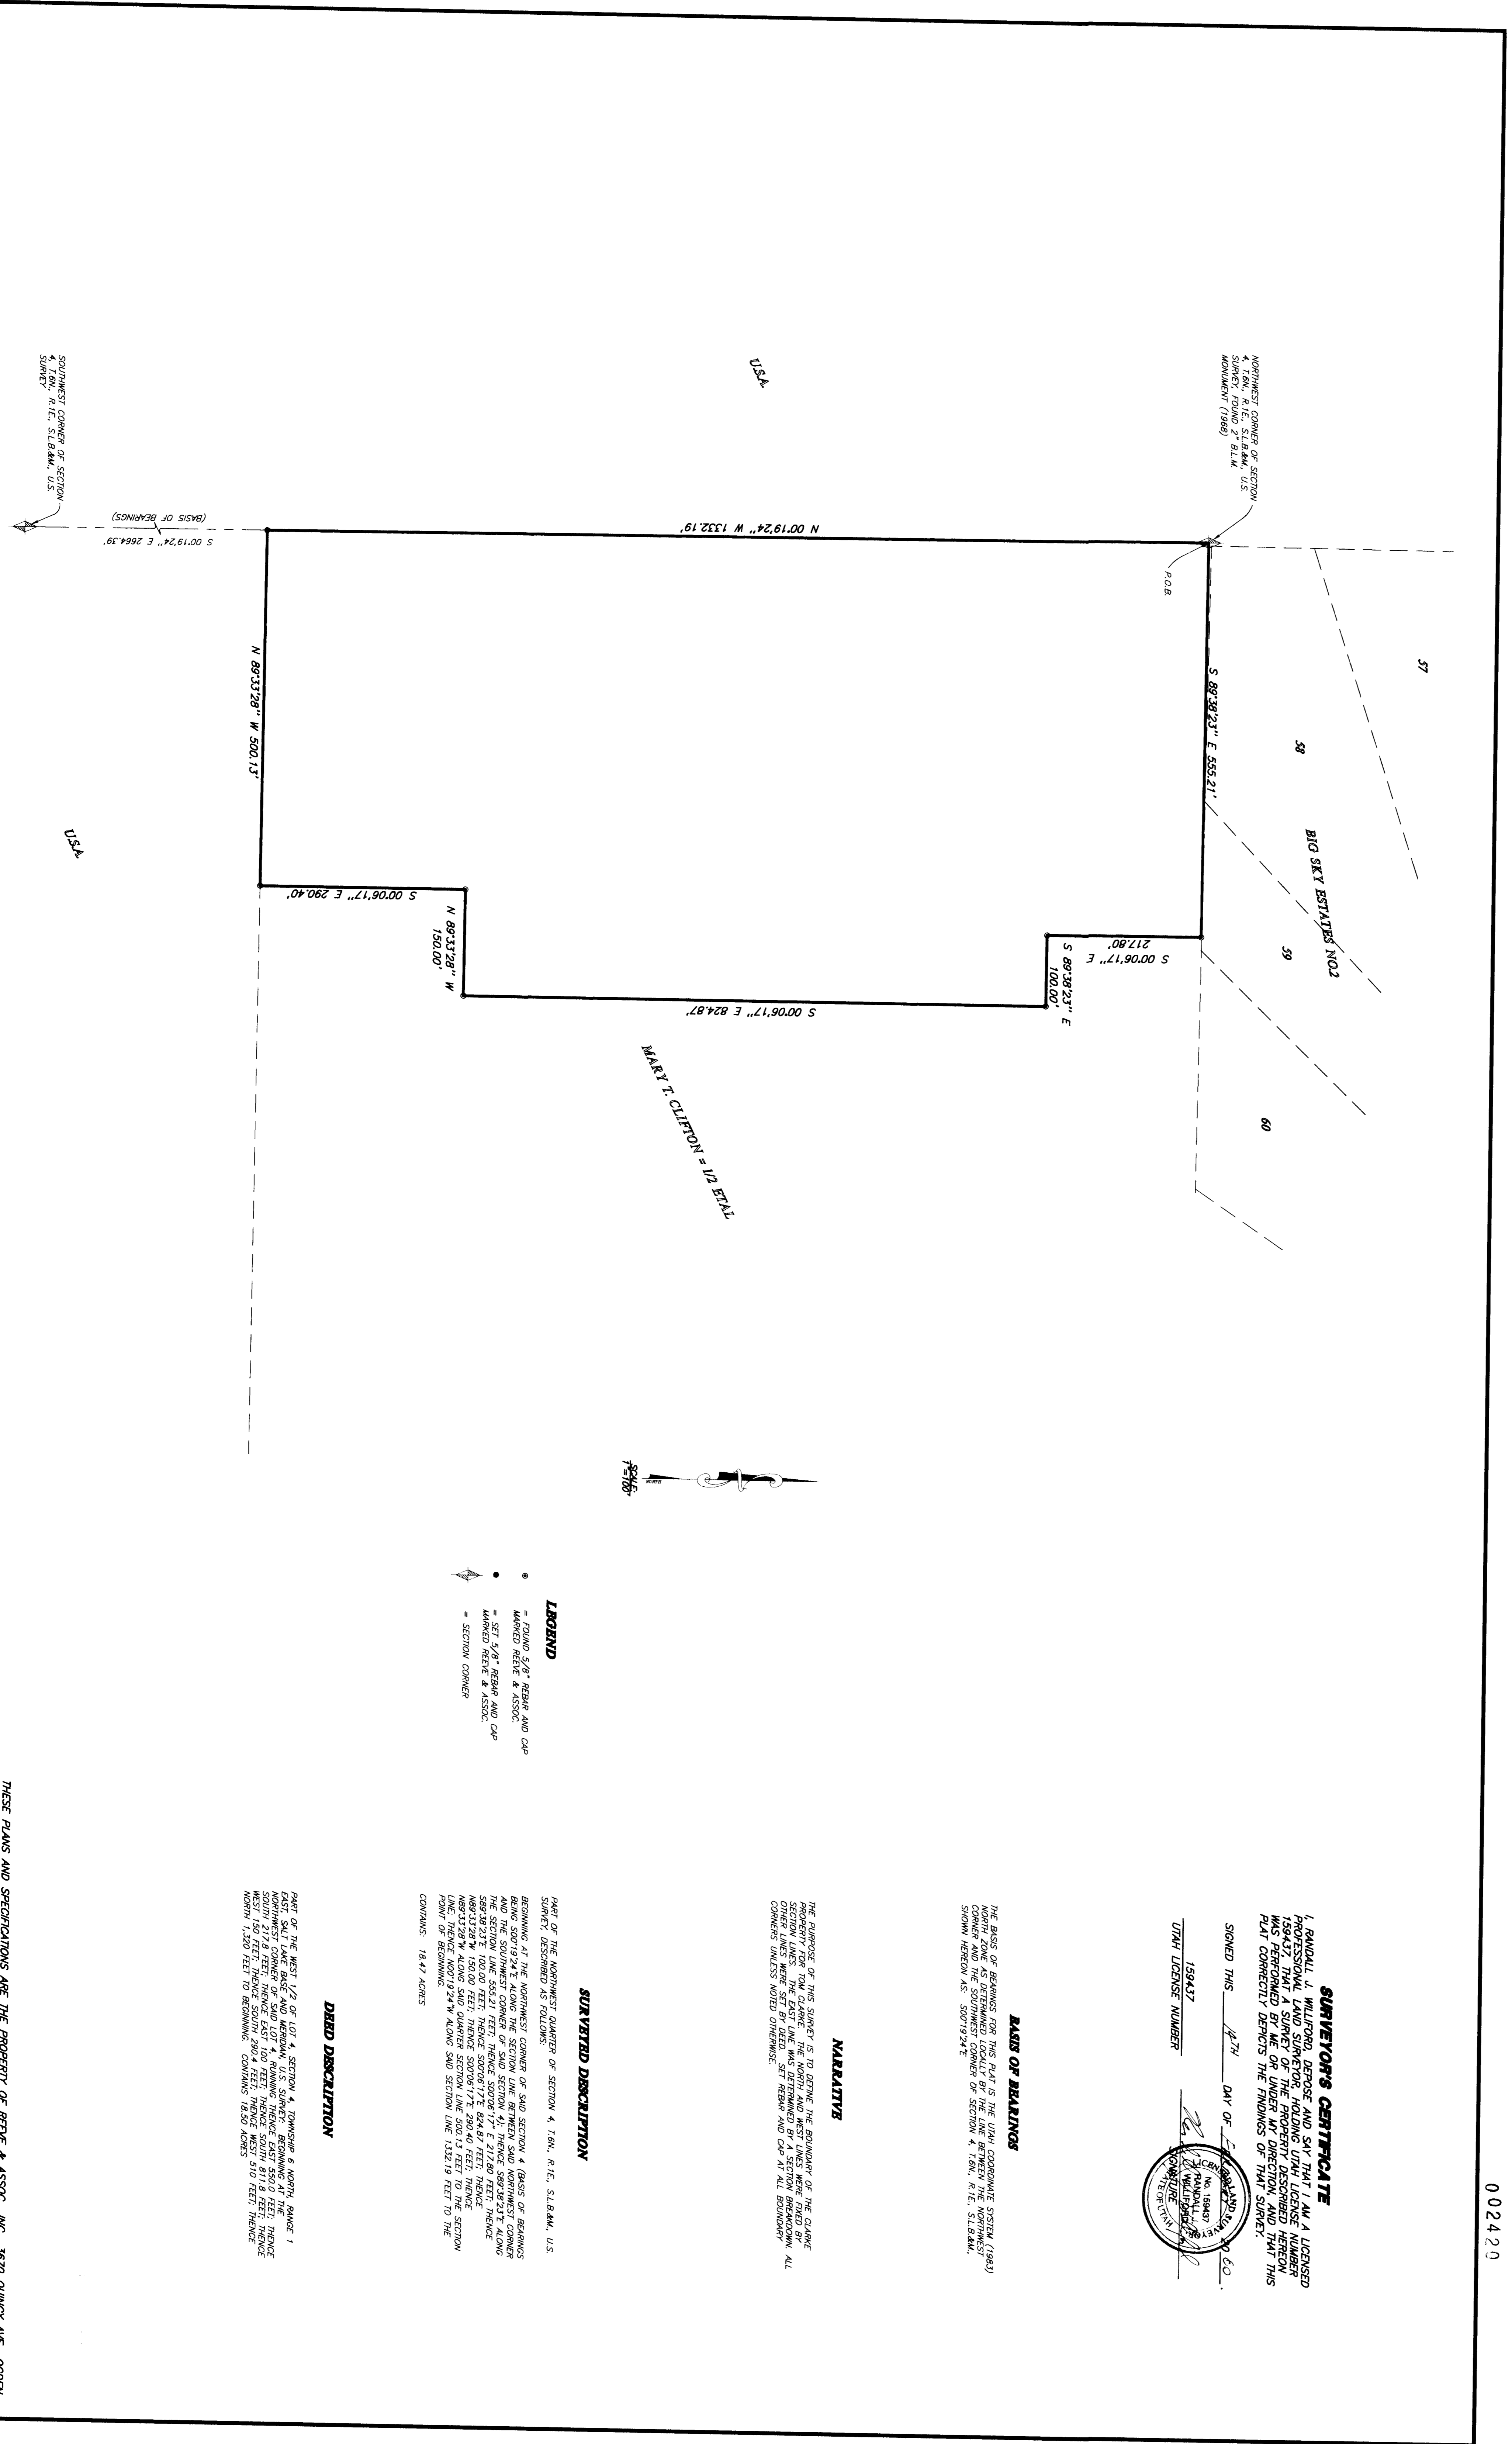

- LEGEND**
 - SECTION CORNER





CONTAINS: 18.47 ACRES

DEED DESCRIPTION


NARRATIVE


SURVEYOR'S CERTIFICATE



 UTAH LICENSE NUMBER