

REVISIONS

| | | |
|----|--|----|
| 1. | | 4. |
| 2. | | 5. |
| 3. | | 6. |




RECORD OF SURVEY

GABEL PROPERTY
 PART OF THE NORTHWEST QUARTER OF SECTION 17, T.5N., R.1W., S.L.B.M., U.S. SURVEY
 DECEMBER 1992

SHEET 1 OF 1 SHEETS

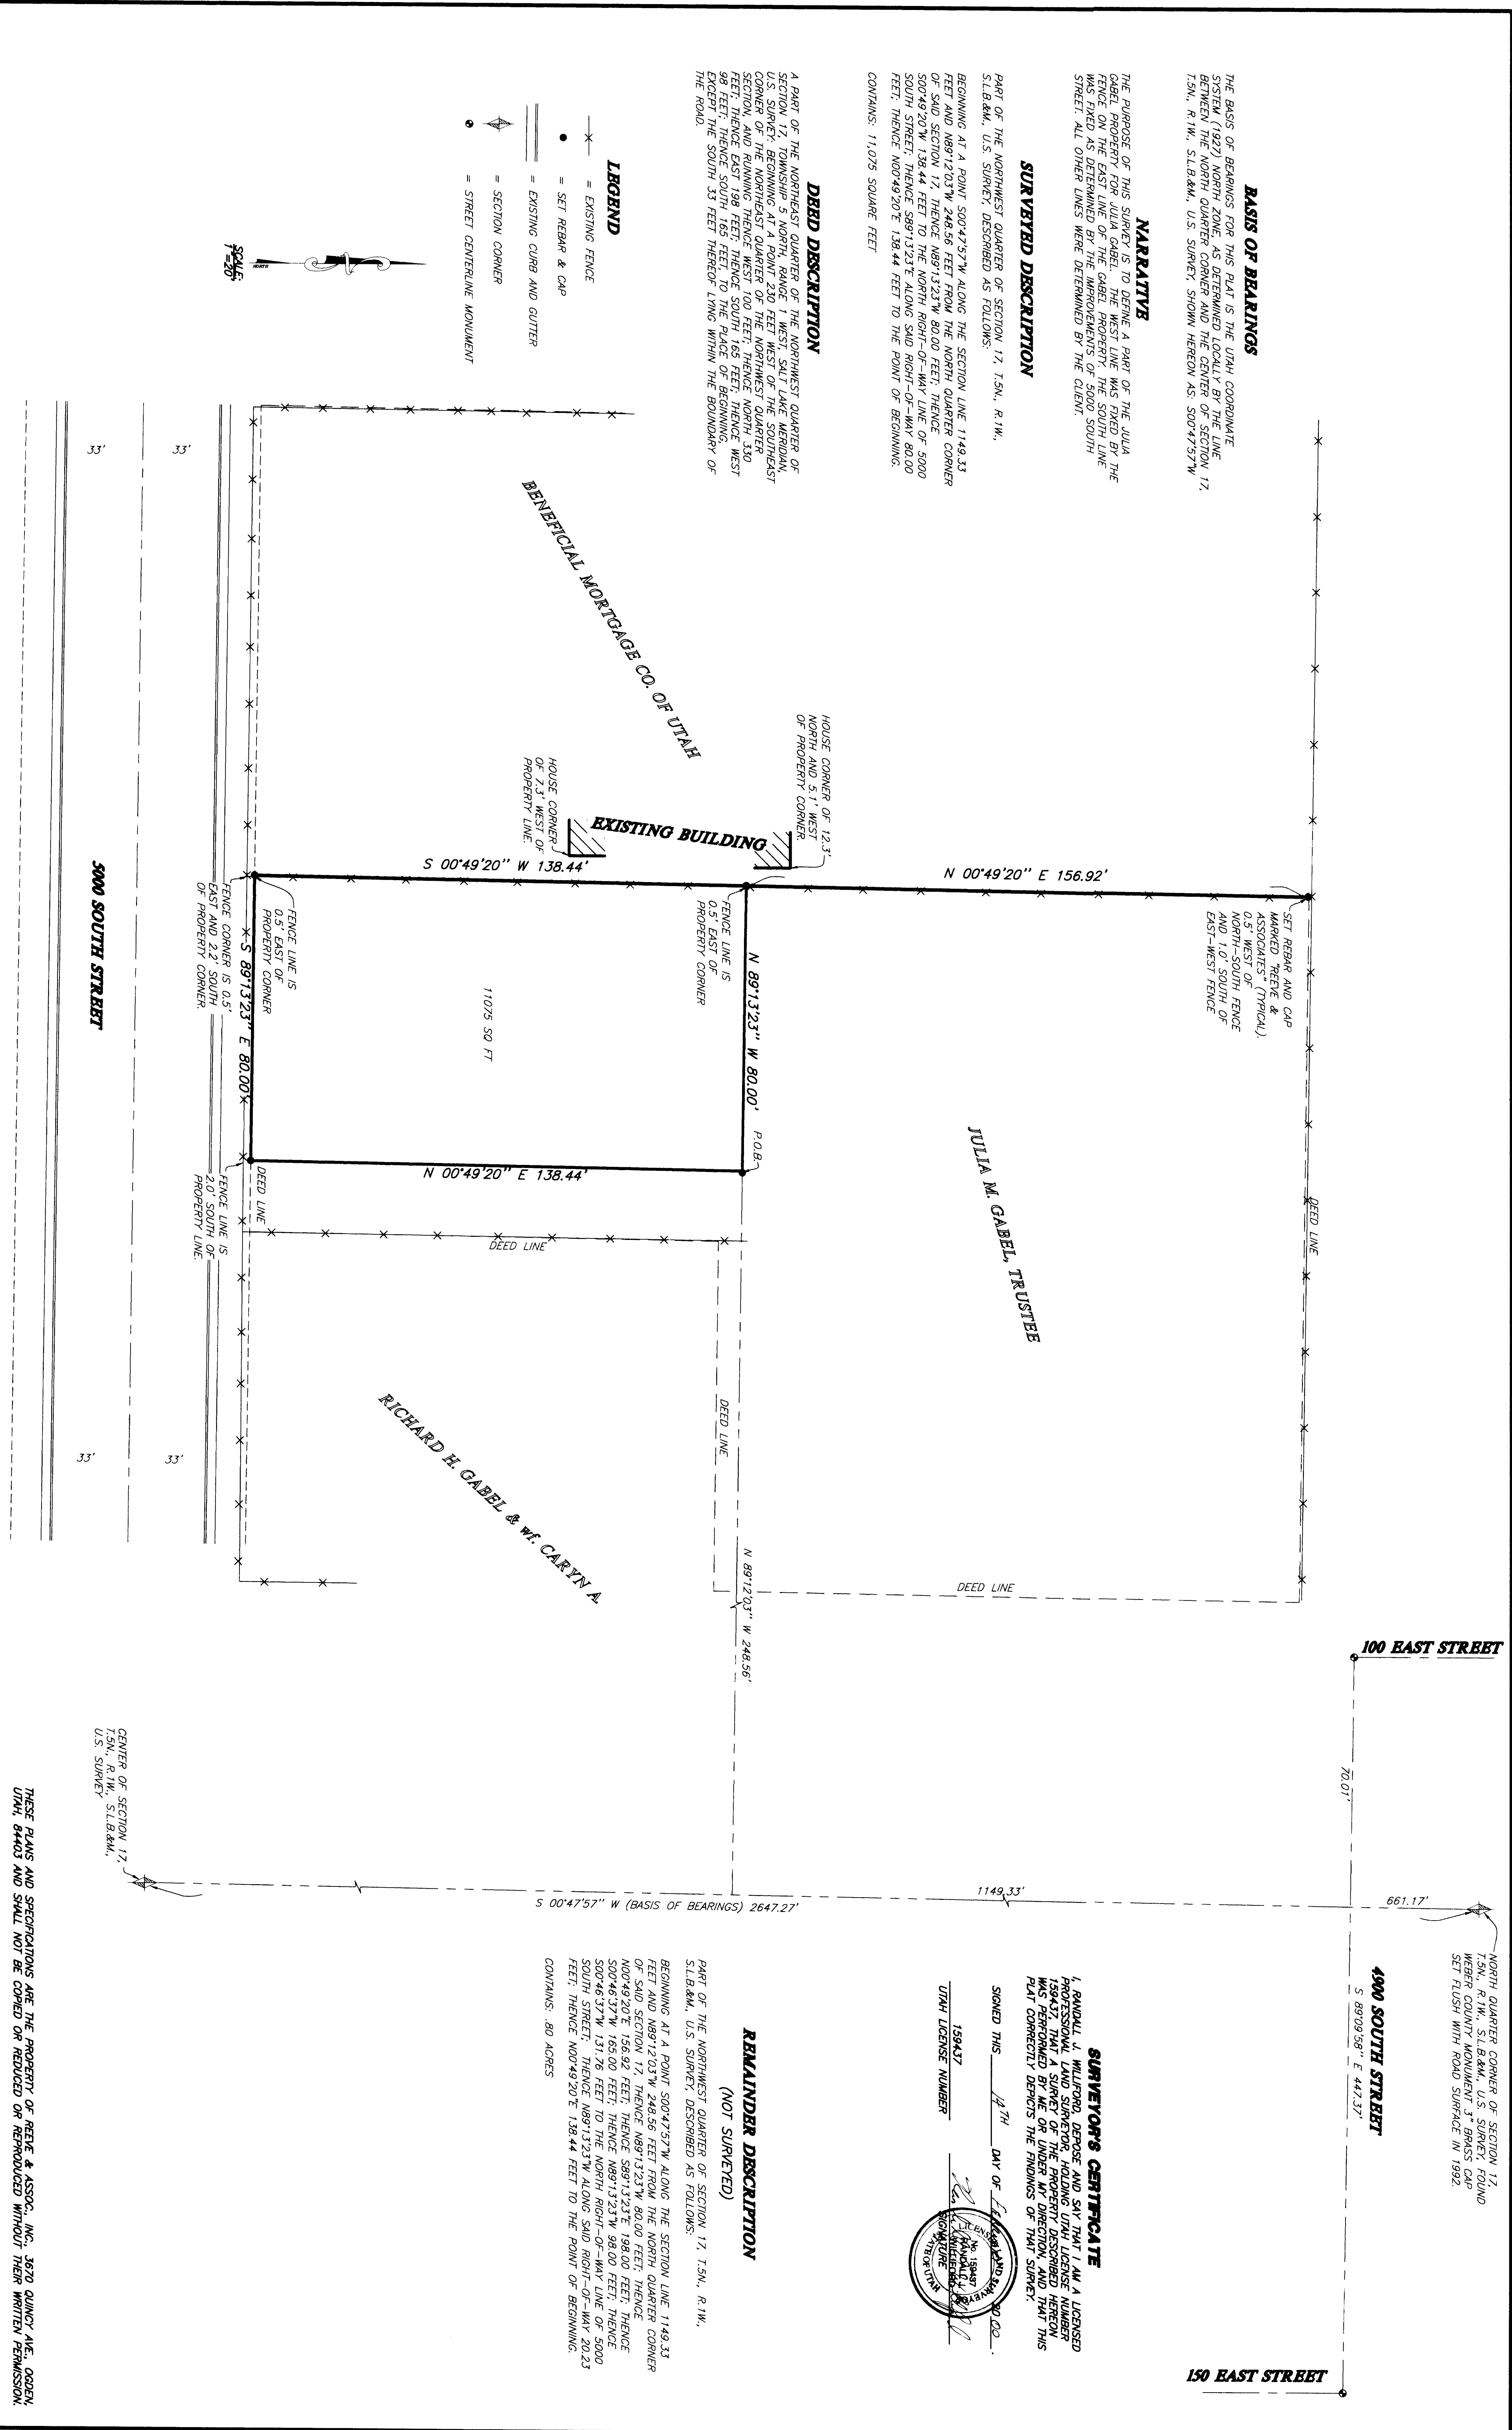

0 0 1 4 2 6