



- LEGEND**
- ▾ FOUND WEBER COUNTY SURVEY SECTION CORNER MONUMENT
  - SET 5/8" REBAR & CAP MARKED "CRS ENG" (TYPICAL UNLESS MARKED OTHERWISE)
  - FOUND MARKER AS NOTED

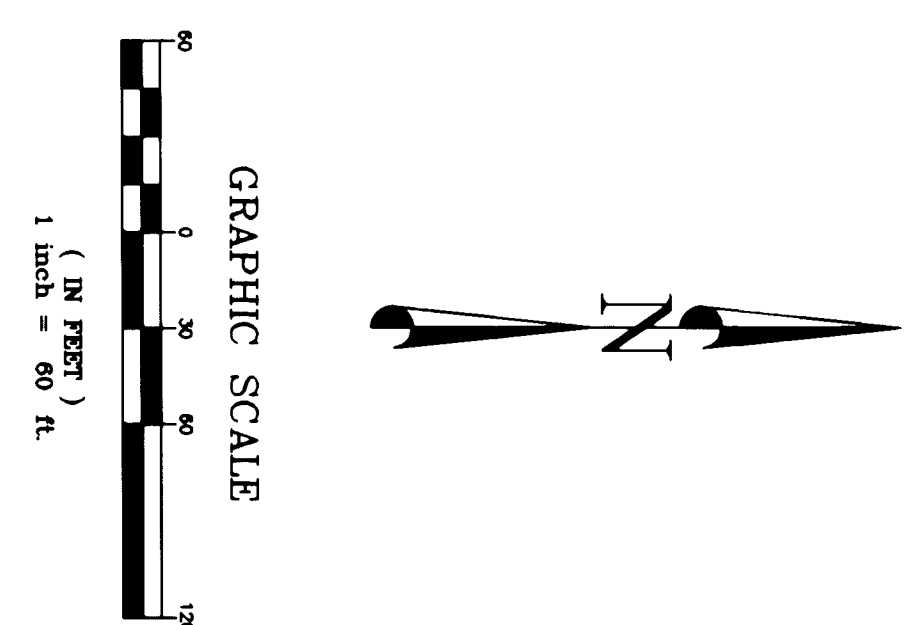

**SURVEYOR'S CERTIFICATE**


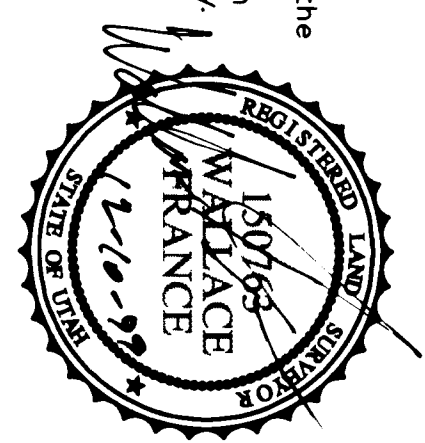

**SURVEY BOUNDARY DESCRIPTION**

Beginning at a point located 2558.49 feet North and 3545.32 feet East from the Weber County Survey witness corner monument located at the intersection of 1200 West Street and 200 North Street, said witness corner is 1175.04 feet N 00°45'37" E from a Weber County Survey monument at the intersection of 1200 West Street and 200 South Street, said witness corner was set by the Surveyor on the 12th day of November, 1999, and running thence N 86°39'10" E 679.69 feet; thence S 86°28'33" W 679.19 feet; thence N 03°35'19" W 738.95 feet to the point of Beginning. Containing 11.51 Acres

**NARRATIVE**

1. A boundary survey was required to prepare a legal description for the Ogden Defense Depot.
2. Basis of bearing is as shown on plot.

**1200 WEST STREET**

S 01°54'06" W 5461.11'

S 00°45'37" W 1175.04'

NORTH 2558.49'

EAST 3545.32'

FOUND WEBER COUNTY MONUMENT AT THE INTERSECTION OF 12TH STREET AND 1200 WEST

FOUND WEBER COUNTY MONUMENT AT THE INTERSECTION OF 12TH STREET AND 200 SOUTH

FOUND WEBER COUNTY MONUMENT AT THE INTERSECTION OF 12TH STREET AND 781 WEST

**127TH STREET**

S 88°41'21" E 3664.95' (M)

FOUND BENT NAIL AND WASHER AT THE INTERSECTION OF 12TH STREET AND 781 WEST

FOUND WEBER COUNTY MONUMENT AT THE INTERSECTION OF 12TH STREET AND 781 WEST

REV	BY	DATE	DESCRIPTION	REV	BY	DATE	DESCRIPTION

PERSON	SCALE
DRAWN D. CARDWELL	1" = 60'-0"
CHECKED T. LEAK	NOVEMBER 5, 1999

PREPARED BY: **CDPS**  
 CONSULTING ENGINEERS, INC.  
 265 EAST 100 SOUTH, SUITE 240  
 SALT LAKE CITY, UTAH 84111  
 PHONE 801/559-5585  
 FAX 801/559-4272

RECORD OF SURVEY  
**OGDEN**  
 DEFENSE DEPOT OGDEN  
 MILITARY RETENTION PARCEL "B"  
 BUILDING 269

UTAH  
 SHEET 1 OF 8  
 DRAWING NO. 14505

RECEIVED  
 NOV 2000  
 Weber County Survey