


LEGEND

- FOUND MONUMENT AS NOTED
- SET 4.0\"/>

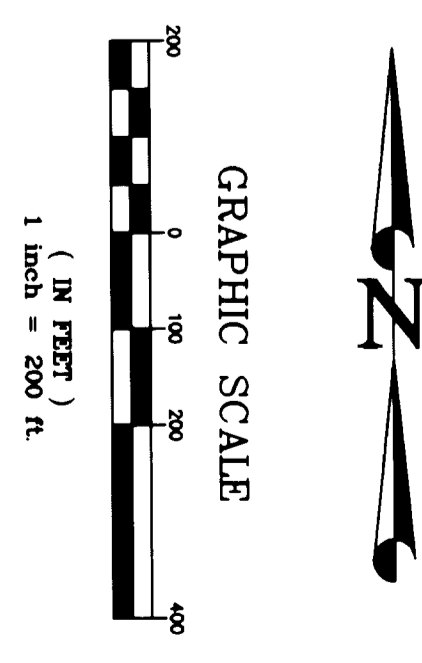

SURVEYORS CERTIFICATE

I, Wallace France, a Registered Professional Land Surveyor as prescribed by the laws of the State of Utah, do hereby certify that the foregoing is a true and correct representation of said survey and that the plat hereon is a true and correct representation of said survey.



SURVEY BOUNDARY DESCRIPTION

Beginning at a point located 1418.16 feet North and 738.85 feet East from the Weber County Survey witness corner monument located at the intersection of 1200 West Street and 200 South Street, thence N 03°37'20\"/>

NARRATIVE

- A boundary survey was required to prepare a legal description for Defense Depot Ogden.
- Basis of bearing is as shown on plat.

REV	BY	DATE	DESCRIPTION	REV	BY	DATE	DESCRIPTION	REVISION	SCALE	PREPARED BY	CONSULTING ENGINEERS, INC.	265 EAST 100 SOUTH, SUITE 240 PHOENIX, UT 84301 PHONE 801/559-5565 FAX 801/559-4272	RECORD OF SURVEY DEFENSE DEPOT OGDEN F.O.S.T. 2 - PARCEL 3	SHEET 3 DRAWG. NO. 14483
								DRAWN BY D. CARONIEL CHECKED BY W. FRANCE DATE NOVEMBER 5, 1998	1" = 200'-0"	PREPARED BY CONSULTING ENGINEERS, INC. CLAYTON RICHARDS, SURVEYOR			RECEIVED MAY 2 2000 Weber County Surveyor	