


LEGEND

- ◆ FOUND MONUMENT AS NOTED
- SET 5/8\"/>
- (TYPICAL UNLESS MARKED OTHERWISE)
- ⊙ FOUND MARKER AS NOTED

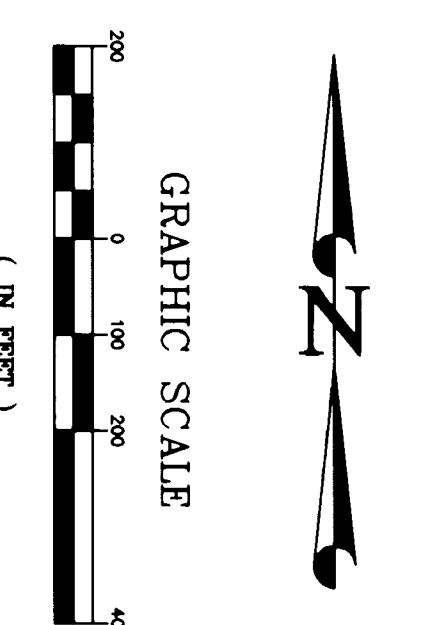

SURVEYORS CERTIFICATE

I, Wallace France, a Registered Professional Land Surveyor as prescribed by the laws of the State of Utah, and holding License Number 150763, do hereby certify that a survey of the described property was made under my direction and that the plat thereon is a true and correct representation of said survey.

SURVEY BOUNDARY DESCRIPTION

Beginning at a point located 4842.82 feet North and 2106.66 feet East from the Weber County Survey witness corner is 1175.04 feet N 00°45'37\"/>

NARRATIVE

1. A boundary survey was required to prepare a legal description for Defense Depot Ogden.
2. Bearings and Distances shown in parentheses are as recorded by Sunrise Engineering Inc.
3. Bearings and Distances shown in parentheses are as recorded by Sunrise Engineering Inc.

1200 WEST STREET

BASIS OF BEARING
S 88°41'21\"/>

12TH STREET

REV	BY	DATE	DESCRIPTION

REVISION	SCALE	DATE					
CHECKED BY: W. FRANCE	14-1-1483	14-83-08					
CHECKED BY: M. KELLEY	DATE: NOVEMBER 5, 1999						

PREPARED BY: **CPES** CONSULTING ENGINEERS, INC.
265 EAST 100 SOUTH, SUITE 240
SALT LAKE CITY, UTAH 84111
PHONE: 801/459-4272
FAX: 801/459-4272

RECORD OF SURVEY
DEFENSE DEPOT OGDEN
F.O.S.T. 2 - PARCEL 6

UTAH
SHEET 6
OF 8
DIMS. NO. 14483