002440

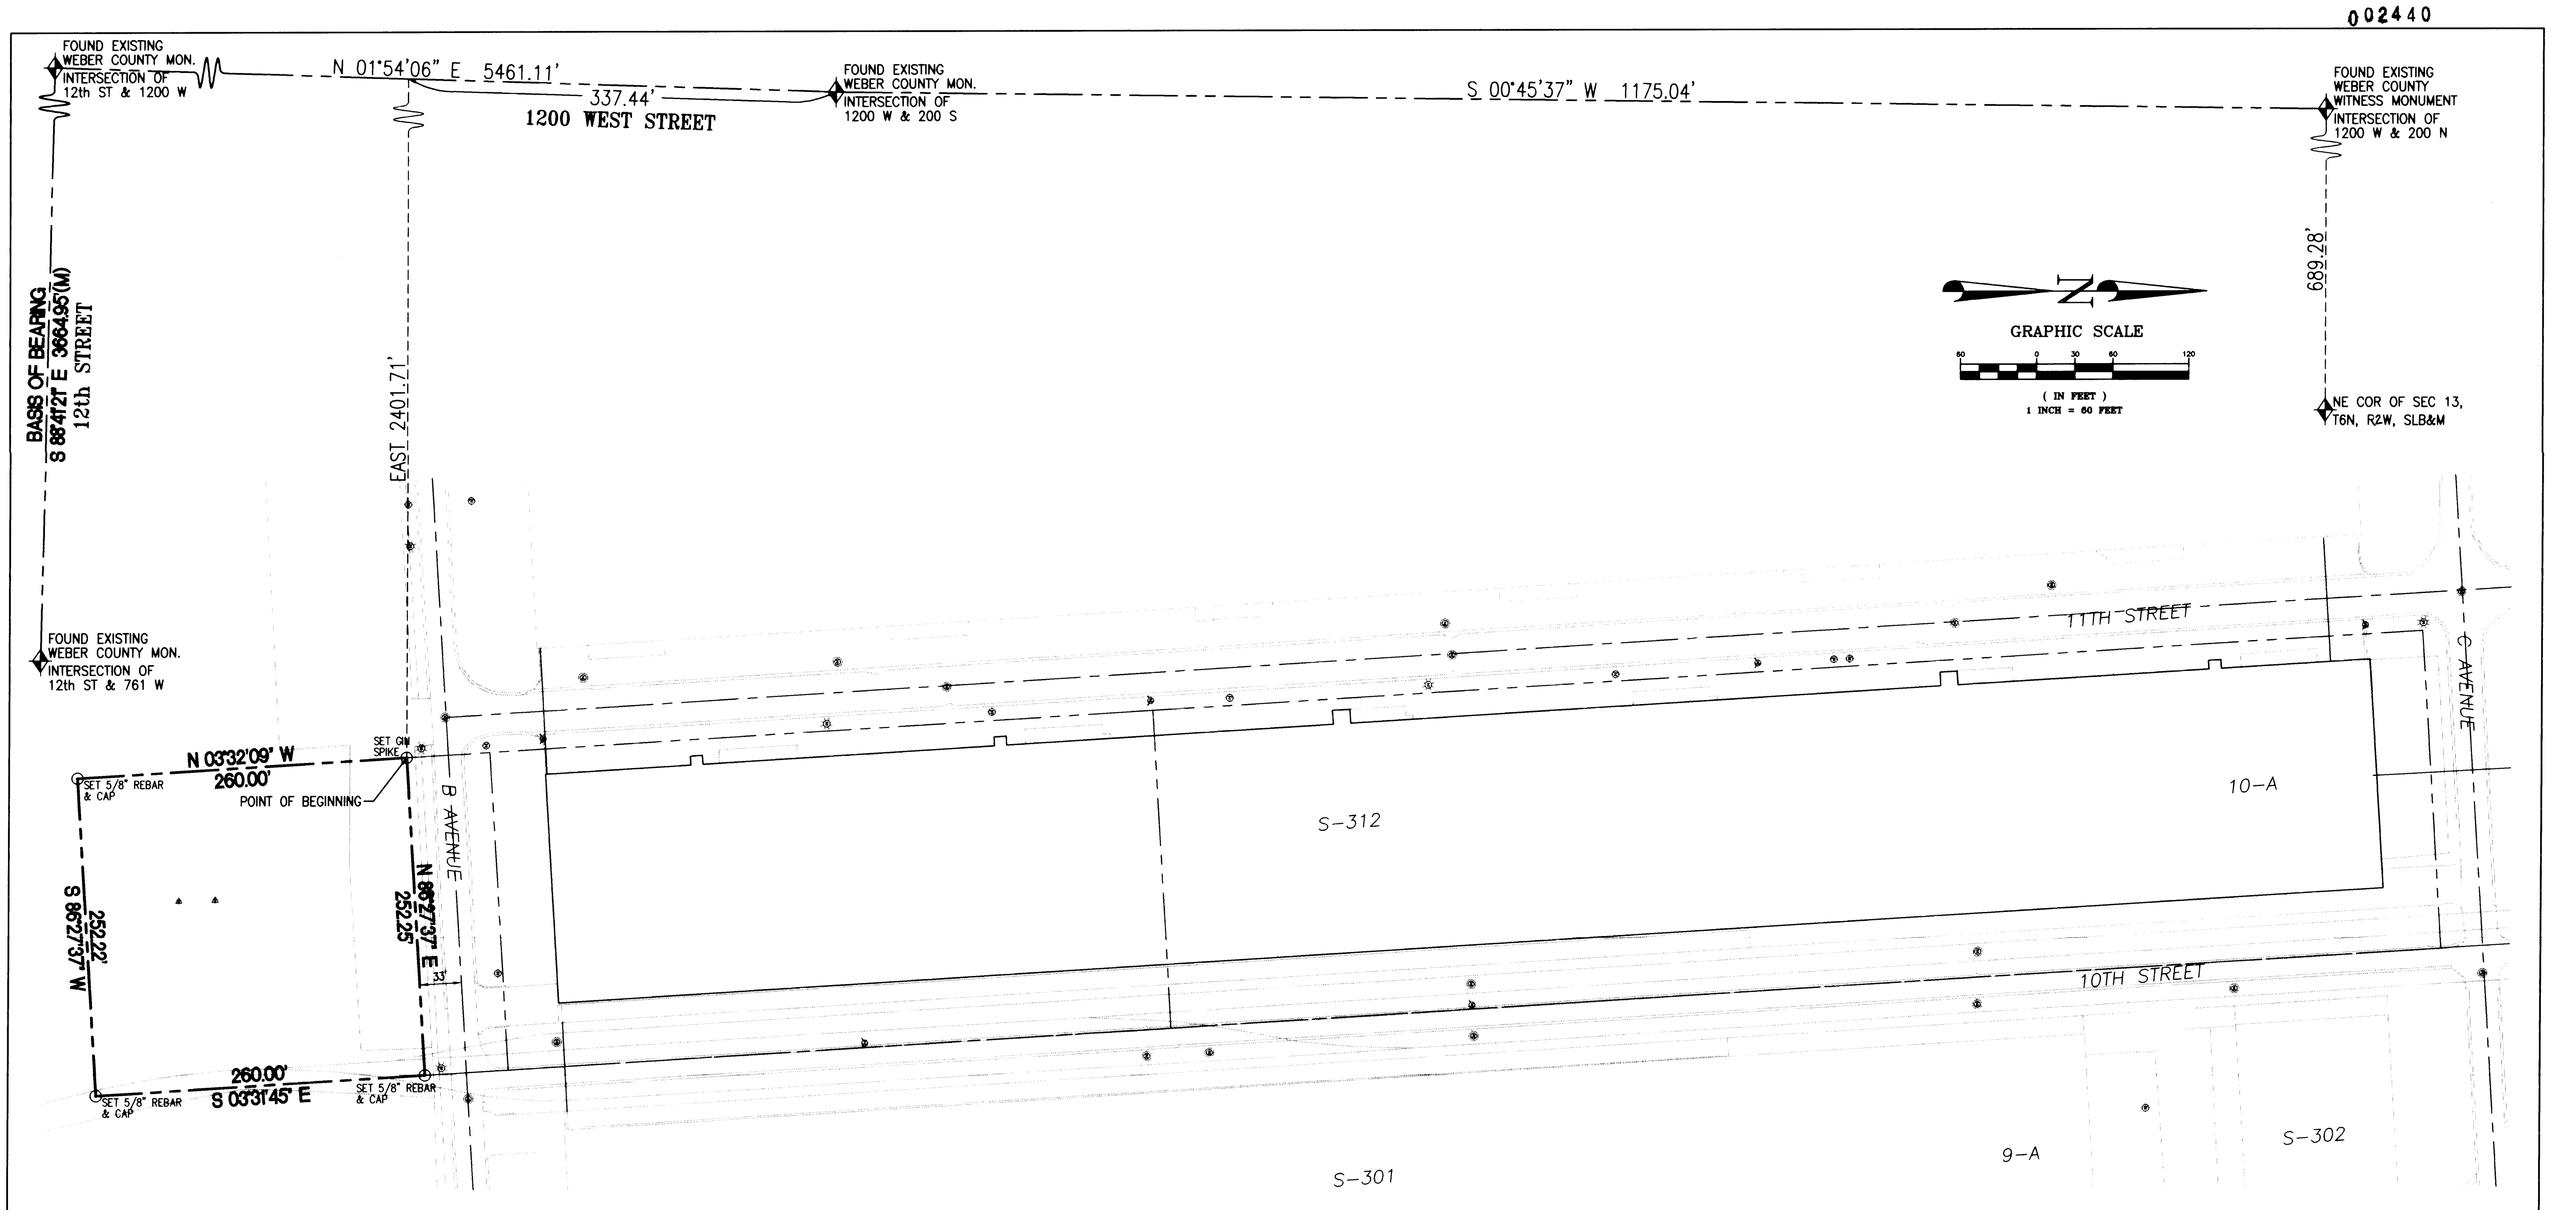

SURVEYOR'S CERTIFICATE

I, Wallace France, a Registered Professional Land Surveyor as prescribed by the laws of the State of Utah, and holding License Number 150763, do hereby certify that a survey of the described property was made under my direction and that the plat hereon is a true and correct representation of said survey.

REGISTERED LAND SURVEYOR 150763 WALLACE FRANCE 11-4-99 STATE OF UTAH

BOUNDARY DESCRIPTION

Beginning at a point located 337.44 feet S 01°54'06" W along the monument line of 1200 West Street and 2401.71 feet from the Weber County Monument at the intersection of 1200 West Street and 200 South Street said point being located 1175.04 feet S 00°45'37" W from a Weber County Survey Witness Monument (said Witness Monument being located 689.28 feet westerly from the Northeast Corner of Section 13, Township 6 North, Range 2 West, Salt Lake Base and Meridian) and running thence N 86°27'37" E 252.25 feet; thence S 03°31'45" E 260.00 feet; thence S 86°27'37" W 252.22 feet; thence N 03°32'09" W 260.00 feet to the point of beginning.

Contains 1.51 Acres

NARRATIVE

1. A boundary survey was required to prepare a legal description for the Ogden/Weber area Technical Center.
2. Basis of Bearing is as shown on plat.

REV	BY	DATE	DESCRIPTION		
				DESIGN	SCALE 1"=60'-0"
				DRAWN C. PASKETT	ACCT. NO. 40-14703
				CHECKED W. FRANCE	F.B. NO.
				CHECKED M. KELLEY	DATE 5 NOV 99

CRS CONSULTING ENGINEERS, INC. CALDWELL RICHARDS SORENSEN

2404 WASHINGTON BLVD, SUITE 717 • OGDEN, UTAH 84401
PHONE 801/394-8446 • FAX 801/399-0728
CIVIL ENGINEERING • SURVEYING

RECORD OF SURVEY
DEFENSE DEPOT OGDEN - BUILDING 10A
OGDEN/WEBER TECHNICAL CENTER-PARKING LOT PARCEL
OGDEN UTAH

SHEET NO. 1 OF 1
DRAWING NO. 14703

P:\Projects\14\14-14483\ddo-10ac.dwg Thu Nov 04 14:47:59 1999 DDC

002440