002441

GRAPHIC SCALE

200 0 100 200 400

(IN FEET)
1 inch = 200 feet

SURVEY BOUNDARY DESCRIPTION

Beginning at a point located 3214.13 feet North and 251.36 feet East from the Weber County Survey witness corner monument located at the intersection of 1200 West Street and 200 North Street, said witness corner is 1175.04 feet N.00°45'37"E. from a Weber County Survey monument at the intersection of 1200 West Street and 200 South Street, said witness corner is also 689.28 feet Westerly from the Northeast Corner of Section 13, Township 6 North, Range 2 West, Salt Lake Base and Meridian and running thence N.86°21'05"E. 1260.00 feet; thence S.03°29'53"E. 1599.59 feet; thence S.86°28'41"W. 608.45 feet; thence S.03°37'20"E. 223.82 feet; thence S.86°05'02"W. 275.04 feet; thence S.03°31'30"E. 1423.00 feet; thence N.86°30'44"E. 848.76 feet; thence S.03°29'37"E. 1594.18 feet; thence S.86°28'26"W. 1226.14 feet; thence N03°30'00"W. 4840.29 feet to the Point of Beginning.

Containing 106.81 Acres.

NARRATIVE

1. A boundary survey was required to prepare a legal description for Defense Depot Ogden.
2. Basis of bearing is as shown on plat.

SURVEYOR'S CERTIFICATE

I, Wallace France, a Registered Professional Land Surveyor as prescribed by the laws of the State of Utah, and holding License Number 150763, do hereby certify that a survey of the described property was made under my direction and that the plat hereon is a true and correct representation of said survey.

REGISTERED LAND SURVEYOR No. 150763 WALLACE LEFRANCE STATE OF UTAH

LEGEND

- FOUND MONUMENT AS NOTED
- SET 5/8" REBAR & CAP MARKED "CRS ENG" (TYPICAL UNLESS MARKED OTHERWISE)
- FOUND MARKER AS NOTED

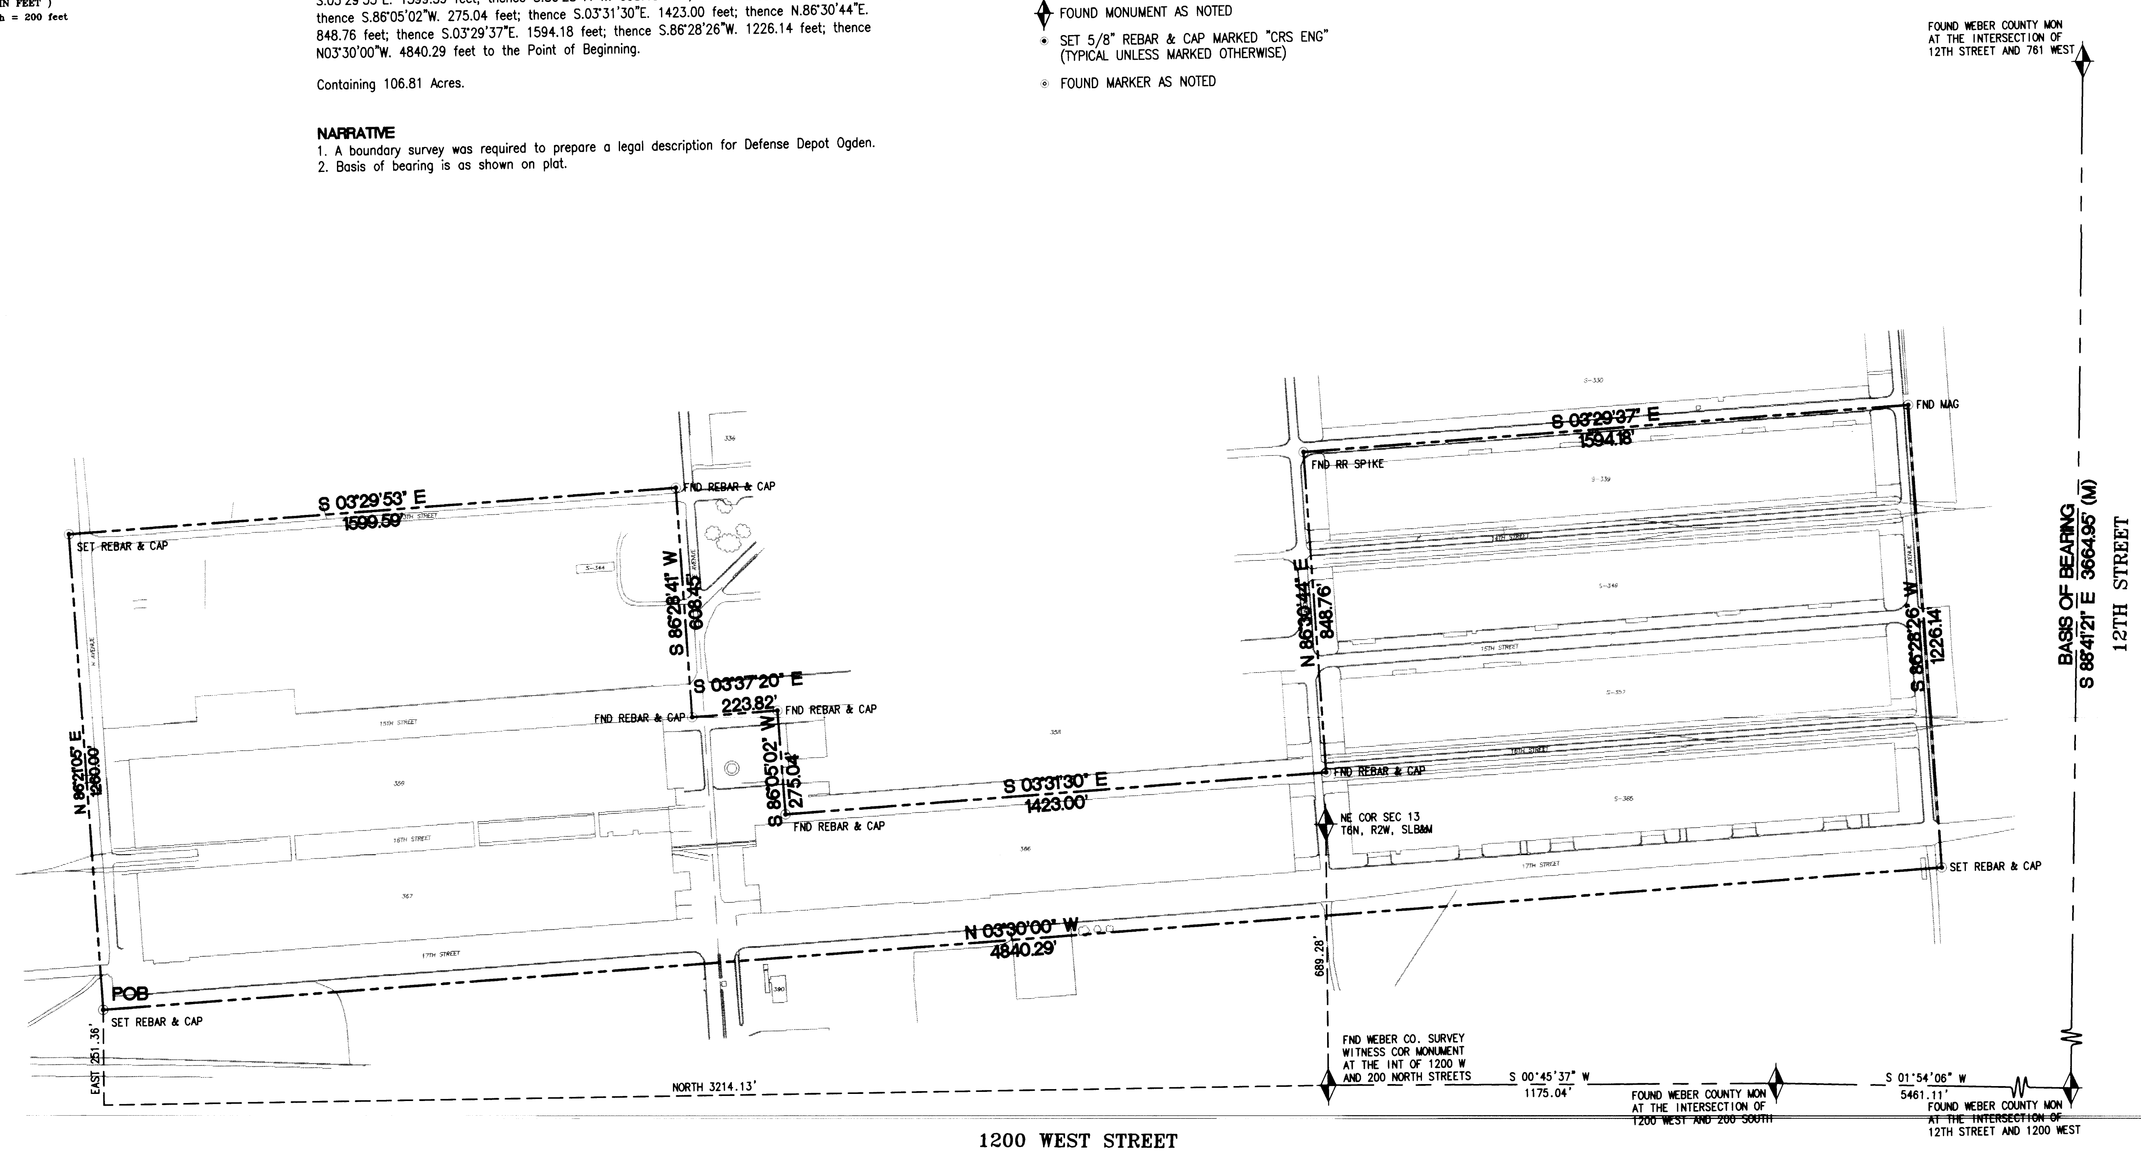

REV.	BY	DATE	DESCRIPTION	REV.	BY	DATE	DESCRIPTION

PRINCIPAL — DATE
PROJECT MANAGER — DATE
CHECKER — DATE
DRAWN BY: C. Paskett
SCALE: 1"=200'-0"
FILE
DATE ISSUED: 10 December 1999

CALDWELL RICHARDS SORENSEN
ANSWERS TO INFRASTRUCTURE™

RECORD OF SURVEY
DEFENSE DEPOT OGDEN PARCEL 9
OGDEN UTAH

SHEET 1 OF 5
DRAWING NO.

002441

G:\40-1474Z (DDO - F.O.S.T. 3 and 4)\dwg\fost3-1.dwg Thu Jan 06 16:15:25 2000 CKP CALDWELL-RICHARDS-SORENSEN