002445

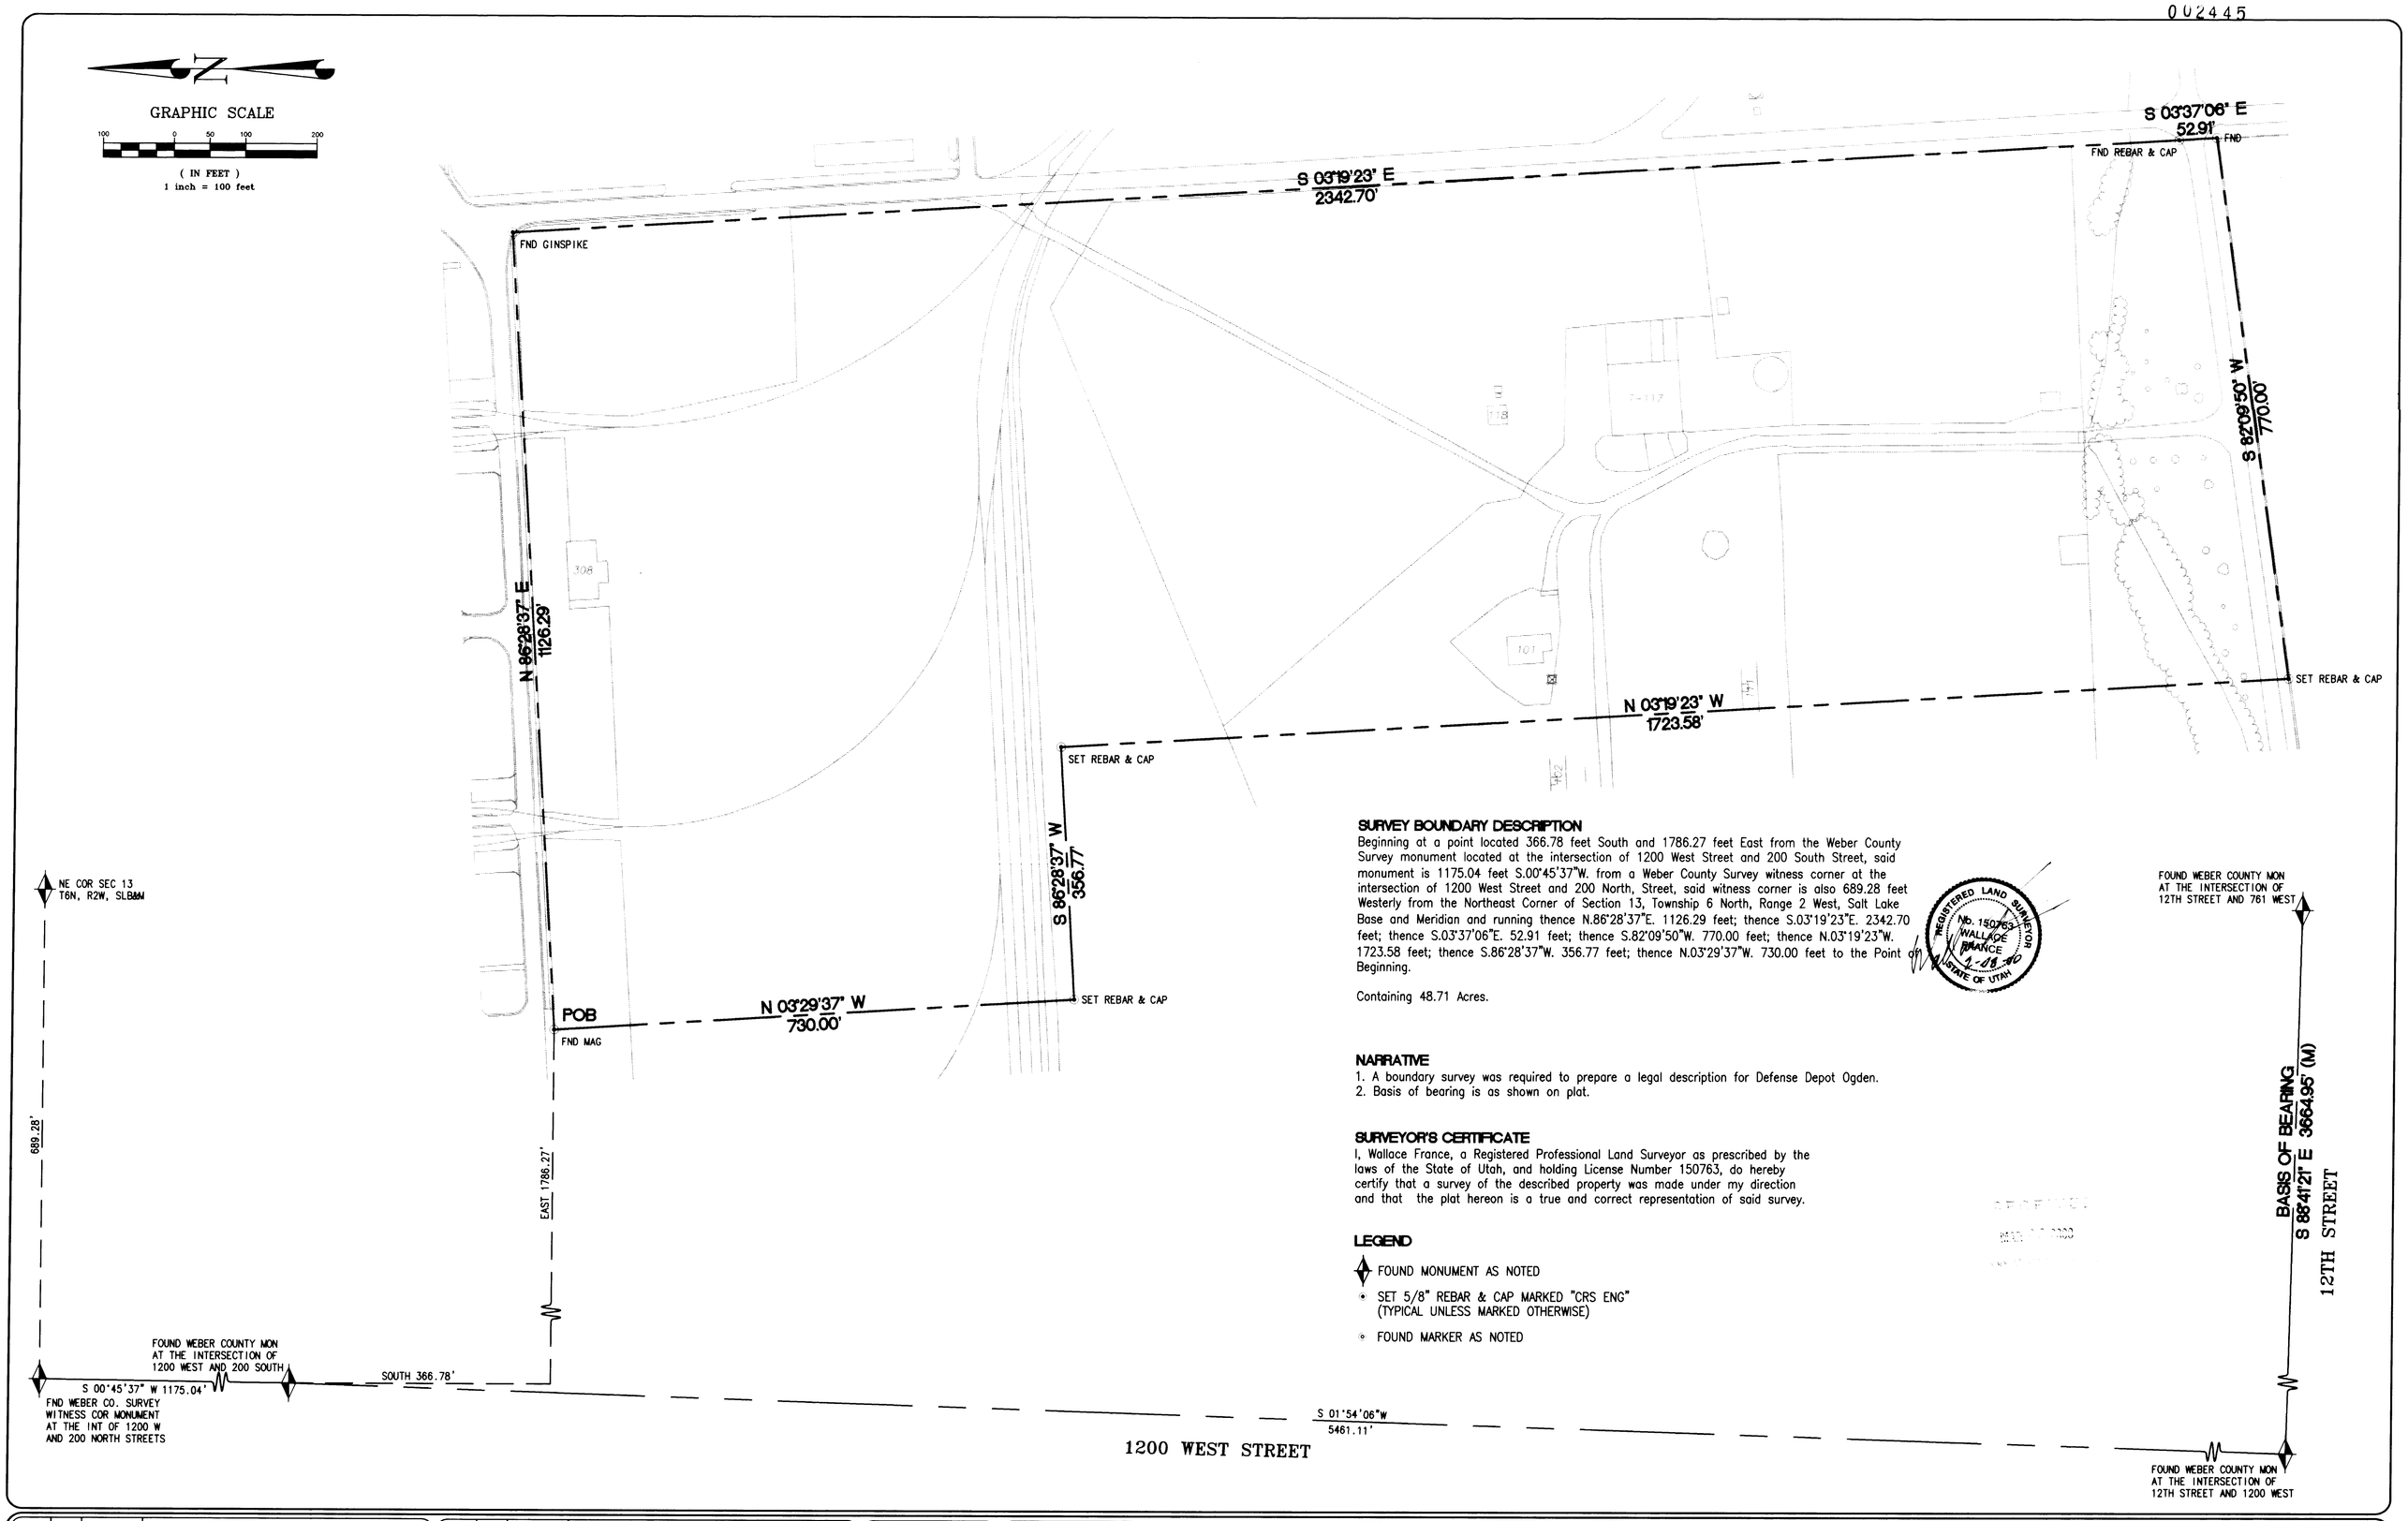

SURVEY BOUNDARY DESCRIPTION

Beginning at a point located 366.78 feet South and 1786.27 feet East from the Weber County Survey monument located at the intersection of 1200 West Street and 200 South Street, said monument is 1175.04 feet S.00°45'37"W. from a Weber County Survey witness corner at the intersection of 1200 West Street and 200 North, Street, said witness corner is also 689.28 feet Westerly from the Northeast Corner of Section 13, Township 6 North, Range 2 West, Salt Lake Base and Meridian and running thence N.86°28'37"E. 1126.29 feet; thence S.03°19'23"E. 2342.70 feet; thence S.03°37'06"E. 52.91 feet; thence S.82°09'50"W. 770.00 feet; thence N.03°19'23"W. 1723.58 feet; thence S.86°28'37"W. 356.77 feet; thence N.03°29'37"W. 730.00 feet to the Point of Beginning.

Containing 48.71 Acres.

NARRATIVE

1. A boundary survey was required to prepare a legal description for Defense Depot Ogden.
2. Basis of bearing is as shown on plat.

SURVEYOR'S CERTIFICATE

I, Wallace France, a Registered Professional Land Surveyor as prescribed by the laws of the State of Utah, and holding License Number 150763, do hereby certify that a survey of the described property was made under my direction and that the plat hereon is a true and correct representation of said survey.

LEGEND

- FOUND MONUMENT AS NOTED
- SET 5/8" REBAR & CAP MARKED "CRS ENG" (TYPICAL UNLESS MARKED OTHERWISE)
- FOUND MARKER AS NOTED

REV.	BY	DATE	DESCRIPTION

REV.	BY	DATE	DESCRIPTION

PRINCIPAL — DATE
PROJECT MANAGER — DATE
CHECKER — DATE
DRAWN BY: C. Paskett — FILE
SCALE: 1"=100'-0" — DATE ISSUED

CALDWELL RICHARDS SORENSEN
ANSWERS TO INFRASTRUCTURE™

RECORD OF SURVEY
DEFENSE DEPOT OGDEN PARCEL 13
OGDEN UTAH

SHEET 5 OF 5
002445
DRAWING NO.

G:\40-14742 (DDO - F.O.S.T. 3 and 4)\dwg\fost3-5.dwg Fri Jan 07 08:16:47 2000 CKP CALDWELL-RICHARDS-SORENSEN