002446

GRAPHIC SCALE

300 0 150 300 600

(IN FEET)
1 inch = 300 feet

SURVEY BOUNDARY DESCRIPTION

Beginning at a point located 4723.60 feet North and 162.03 feet East from the Weber County Survey witness corner monument located at the intersection of 1200 West Street and 200 North Street, said witness corner is 1175.04 feet N.00°45'37"E. from a Weber County Survey monument at the intersection of 1200 West Street and 200 South Street, said witness corner is also 689.28 feet Westerly from the Northeast Corner of Section 13, Township 6 North, Range 2 West, Salt Lake Base and Meridian and running thence N.86°29'24"E. 1948.35 feet; thenceS.36°22'00"E. 467.45 feet; thence S.12°22'19"E. 373.74 feet; thence S.05°17'30"W. 383.24 feet; thence S.17°53'32"W. 385.34 feet; thence S.03°30'02"E. 73.61 feet; thence S.86°21'05"W. 803.48 feet; thence N.03°29'53"W. 66.00 feet; thence S.86°21'05"W. 1260.00 feet; thence S.03°30'00"E. 4840.29 feet ; thence N.86°28'26"E. 1226.14 feet; thence S.03°29'37"E. 730.00 feet; thence N.86°28'37"E. 356.77 feet; thence S.03°19'23"E. 1723.58 feet; thence S.82°09'50"W. 227.81 feet; thence S.89°54'46"W. 1264.92 feet; thence N.01°50'25"W. 1237.06 feet; thence S.88°20'47"W. 741.94 feet to the east line of 1200 West Street; thence six courses along said west line N.00°46'09"E. 1554.42 feet; N.00°38'09"E. 2794.92 feet; N.02°38'09"E. 1267.81 feet; N.02°22'39"E. 385.56 feet; N.01°16'39"E. 1021.70 feet; and N.01°36'39"E. 488.36 feet to the Point of Beginning.

REGISTERED LAND SURVEYOR No. 150763 WALLACE FRANCE STATE OF UTAH 1-08-00

Containing 211.70 Acres.

NARRATIVE

1. A boundary survey was required to prepare a legal description for Defense Depot Ogden.
2. Basis of bearing is as shown on plat.

SURVEYOR'S CERTIFICATE

I, Wallace France, a Registered Professional Land Surveyor as prescribed by the laws of the State of Utah, and holding License Number 150763, do hereby certify that a survey of the described property was made under my direction and that the plat hereon is a true and correct representation of said survey.

LEGEND

- FOUND MONUMENT AS NOTED
- SET 5/8" REBAR & CAP MARKED "CRS ENG" (TYPICAL UNLESS MARKED OTHERWISE)
- FOUND MARKER AS NOTED

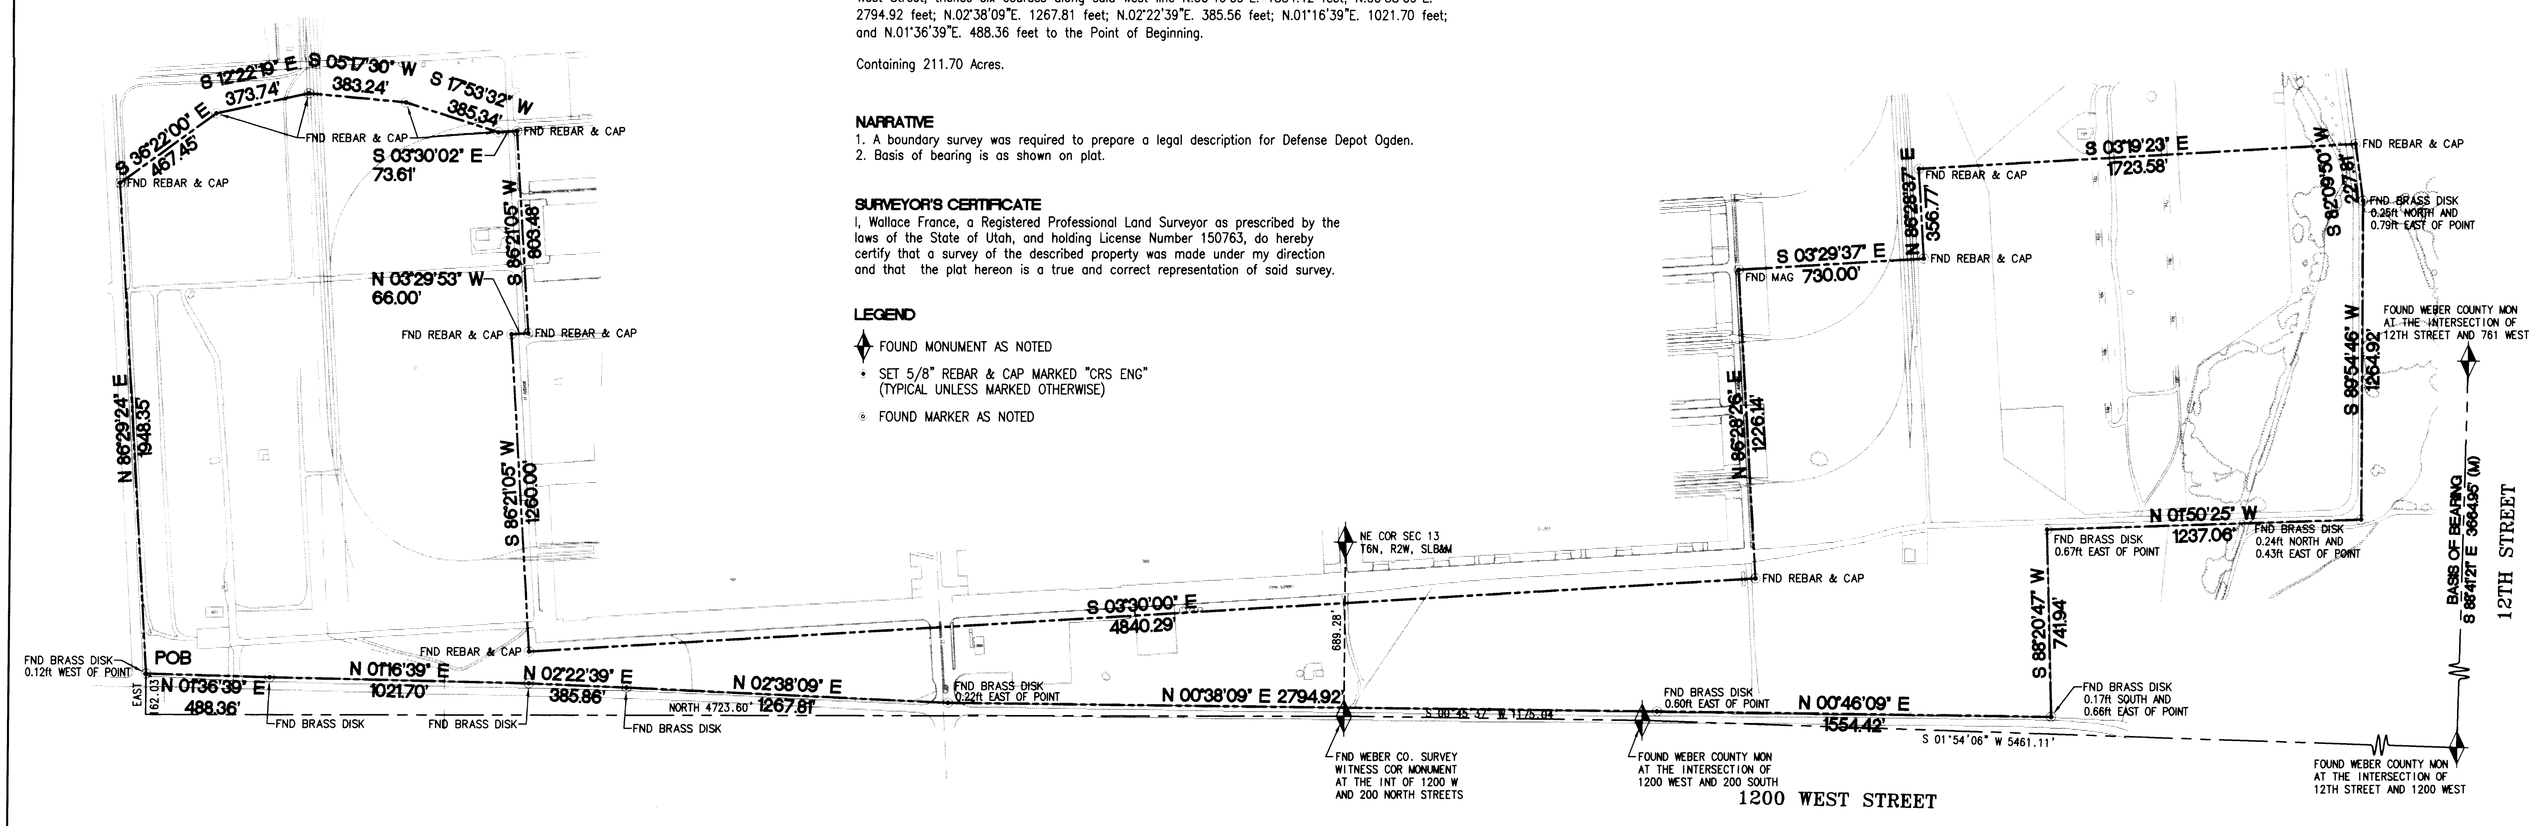

REV.	BY	DATE	DESCRIPTION	REV.	BY	DATE	DESCRIPTION

PRINCIPAL		DATE	
PROJECT MANAGER		DATE	
CHECKER		DATE	
DRAWN BY C. Paskett		FILE	
SCALE 1"=300'-0"		DATE ISSUED	

CALDWELL RICHARDS SORENSEN
ANSWERS TO INFRASTRUCTURE™

RECORD OF SURVEY

DEFENSE DEPOT OGDEN PARCEL 14

OGDEN UTAH

SHEET 1 OF 3

002446
DRAWING NO.

002446

G:\40-14742 (DOD - F.O.S.T. 3 and 4)\dwg\F0S14-1.DWG Fri Jan 07 08:34:26 2000 CXP CALDWELL RICHARDS-SORENSEN