

LEGEND


- FOUND MONUMENT AS NOTED
- SET 3/4\"/>
- ⊙ TYPICAL, UNLESS MARKED OTHERWISE
- ⊙ FOUND MARKER AS NOTED

SURVEYOR'S CERTIFICATE

I, Wallace France, a Registered Professional Land Surveyor as prescribed by the laws of the State of Utah, and holding License Number 501, do hereby certify that I have personally supervised and performed the survey described herein, and that the plat hereon is a true and correct representation of said survey.

SURVEY BOUNDARY DESCRIPTION

Beginning at a point located 178.27 feet East from a Weber County Survey monument located at the intersection of 1200 West Street and 200 South Street, said monument being 1175.04 feet S 0°45'37\"/>

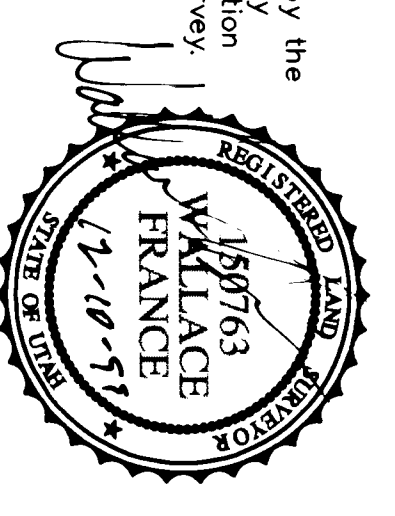

Excepting therefrom the following parcel:

Containing 54.40 Acres

NARRATIVE

1. A boundary survey was required to prepare a legal description for Defense Depot Ogdem.

2. Basis of Bearing is as shown on plat.

REVISION	DATE	BY	DESCRIPTION

REVISION	DATE	BY	DESCRIPTION

DESIGN	SCALE	PREPARED BY
DRAWN BY D. CARROLL	1" = 200'-0"	CONSULTING ENGINEERS, INC.
CHECKED BY W. FRANCE	ACCT. NO. 14-14483	265 EAST 100 SOUTH, SUITE 240
CHECKED BY M. KELLEY	FILE 14483-07	SALT LAKE CITY, UTAH 84111
	DATE NOVEMBER 5, 1999	PHONE 801/464-4272
		FAX 801/459-4272

RECORD OF SURVEY	OGDEN	DEFENSE DEPOT OGDEN	F.O.S.T. 2 - PARCEL 7

SHEET 7	OF 8
DRAWG. NO. 14483	
UTAH	