


LEGEND
Scale: 1" = 60'
Set Nail in Curve
Witness Corner
Right-of-way Monument

NARRATIVE:
This Survey was requested by Mr. Dave Heath of Jack B. Parson Companies for the purpose of establishing the boundaries of this Section 19, 20, and the South 1/4 corner of the Northeast corner of Section 20, 15th, R1W, 518M, U.S. Survey.

SURVEYED DESCRIPTION
A part of the East Half of Section 19, Township 5 North, Range 1 West, the Base and Meridian, U.S. Survey.

BOUNDARY DESCRIPTION
A part of the East One-Half of Section 19, Township 5 North, Range 1 West, Soil Lake Meridian;

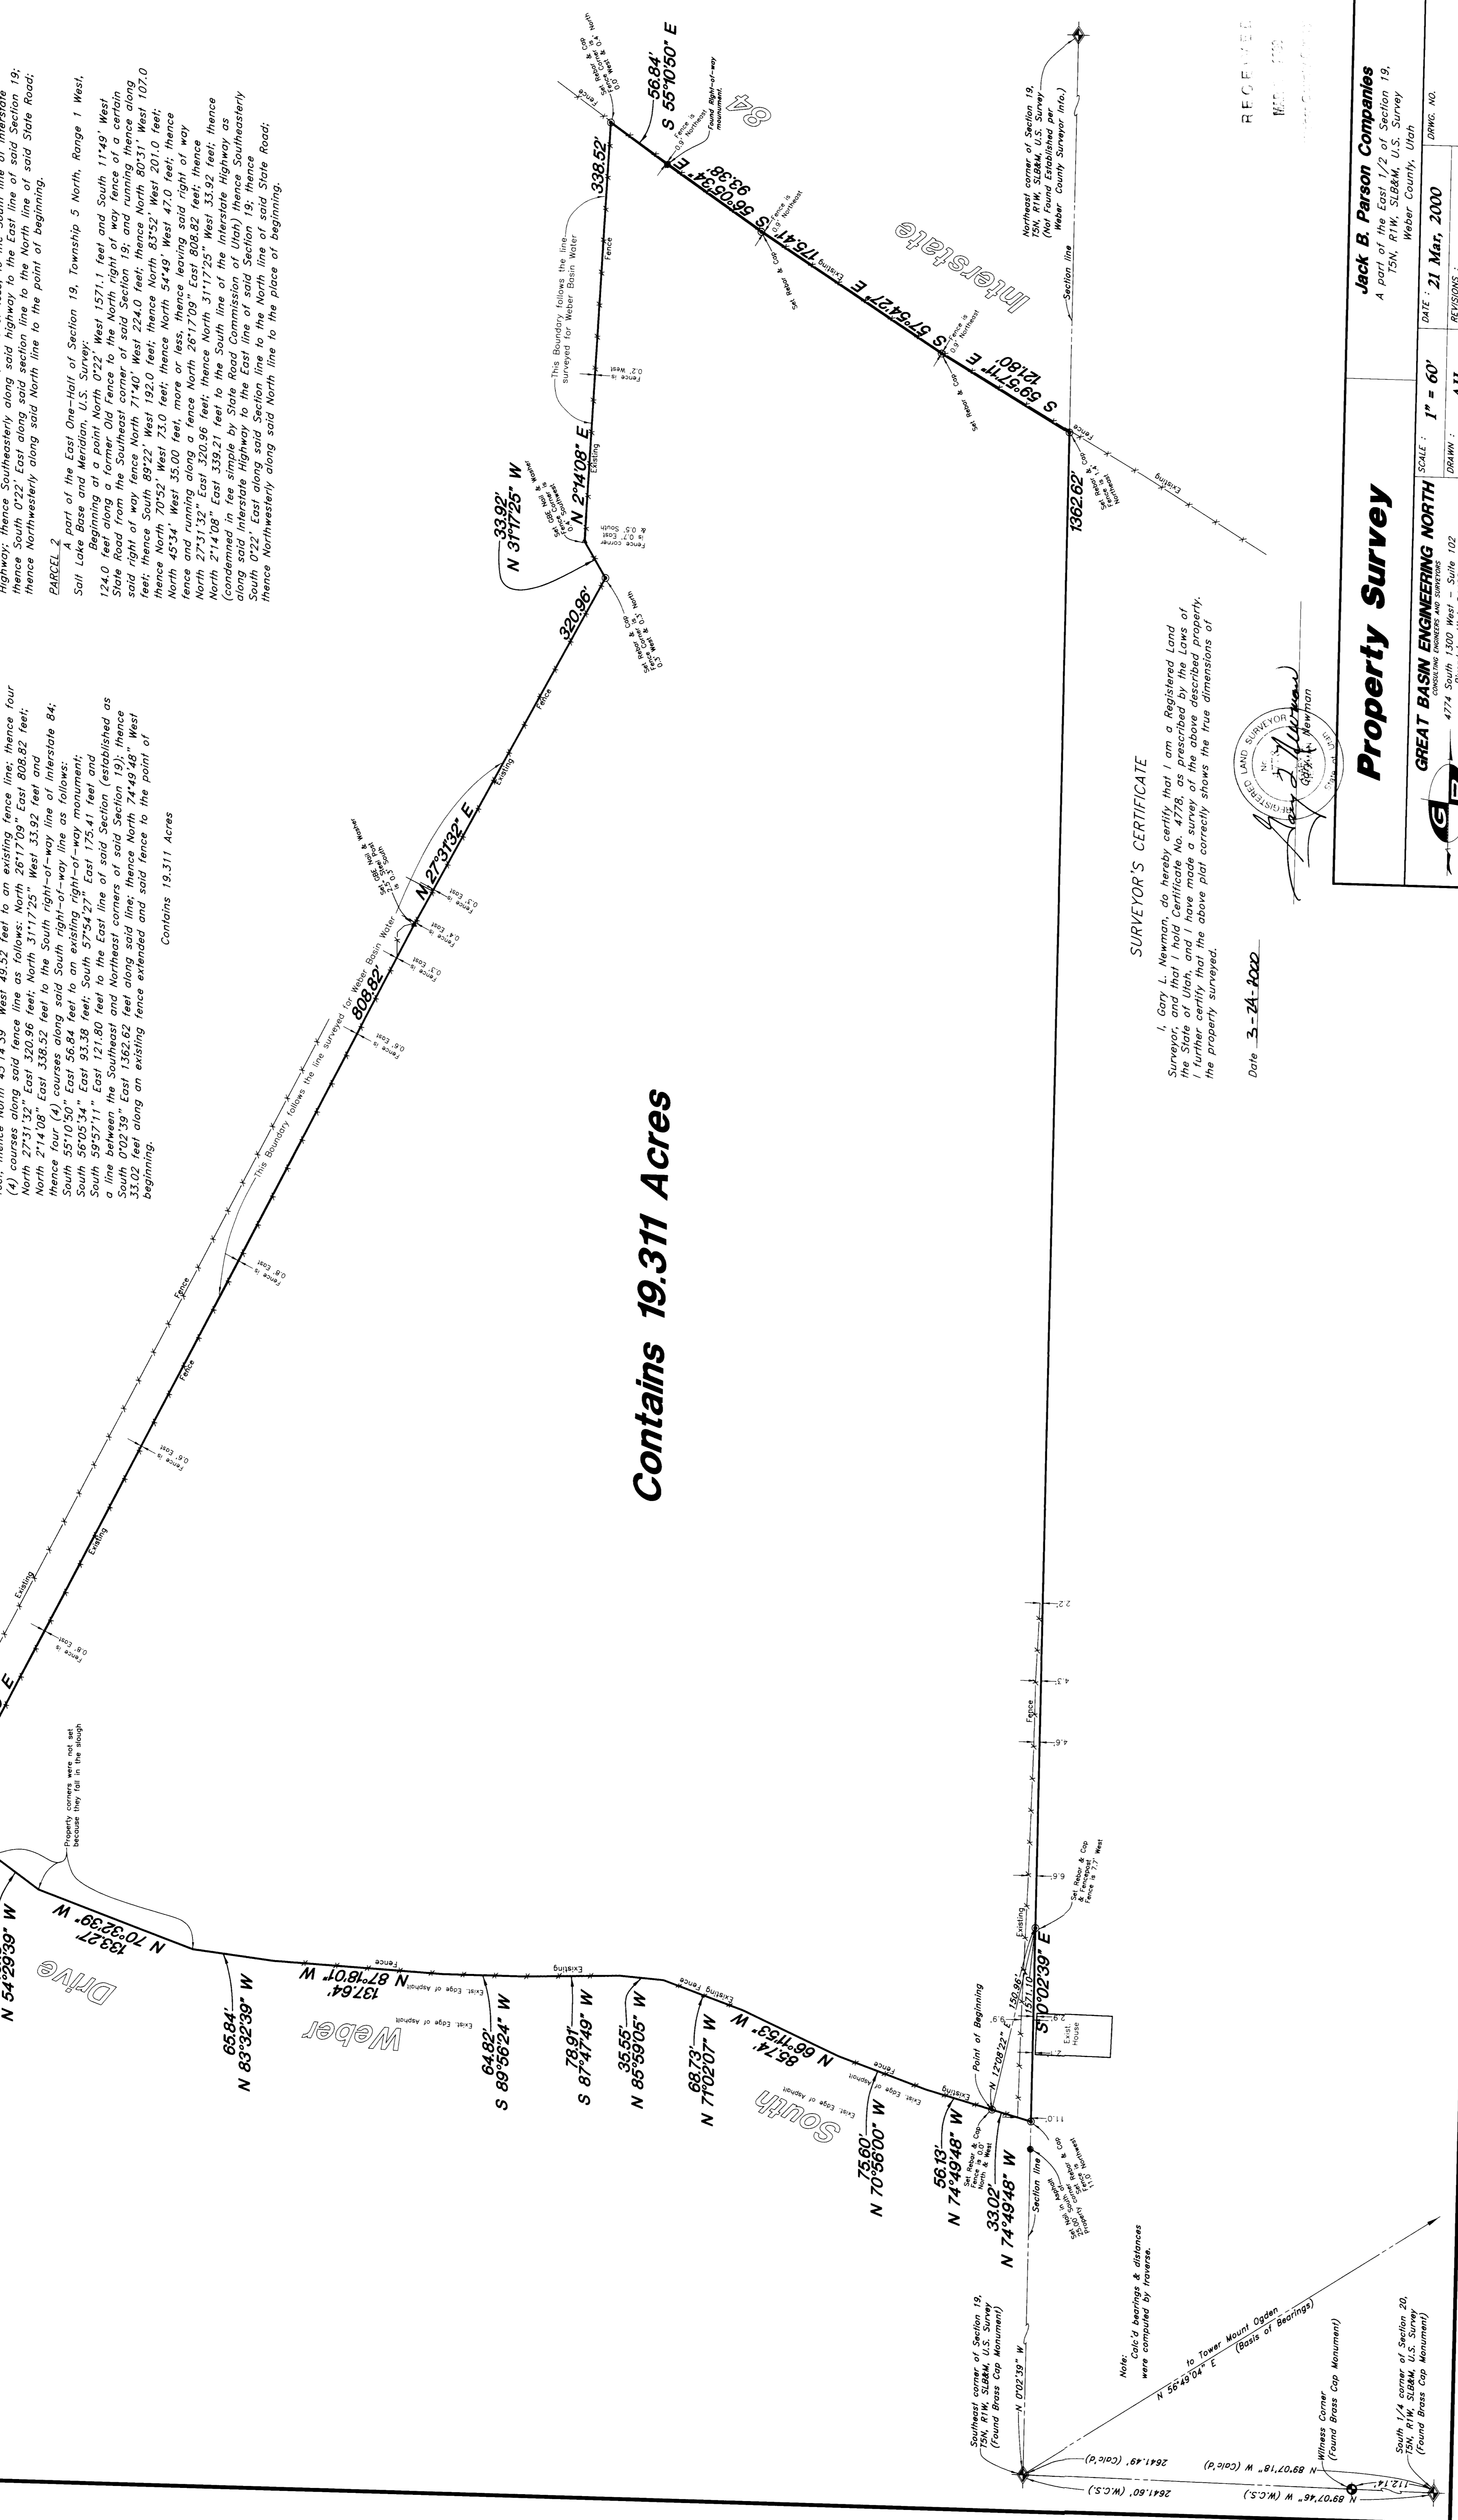

Contains 19.311 Acres

SURVEYOR'S CERTIFICATE
I, Gary L. Newman, do hereby certify that I am a Registered Land Surveyor of the State of Utah, License No. 4778, as prescribed by the Laws of the State of Utah.

Signature of Gary L. Newman, Registered Land Surveyor

Property Survey
Jack B. Parson Companies
GREAT BASIN ENGINEERING NORTH
Scale: 1" = 60'
Revision: AH
PARNKAP
002466