

Washington Boulevard

LEGEND


NARRATIVE

This survey was requested by Mr. Joe Peterson to determine the location of a monument and their relationship to the monument and an iron spike were found along the centerline of Washington Boulevard. A line bearing $N 0^{\circ}50'15'' E$ between these two points was used as the basis of bearings. No property corners were set.

SURVEYOR CERTIFICATE


I, Gary L. Newman do hereby certify that I am a Registered Land Surveyor, and I hold Certificate No. 4778, as prescribed by the Laws of the State of Utah, and I have made a survey of the following described property:

(OCCUPATION DESCRIPTION PREPARED BY GREAT BASIN ENGINEERING 3-7-2000)

A part of the Southwest Quarter of Section 32, Township 7 North, Range 1 West, Salt Lake Base and Meridian, U.S. West right-of-way line of Washington Boulevard, said point being 617.86 feet North 89°09'45" West 443.13 feet North 0°50'15" East and 66.00 feet North 89°58'24" West from the Southeast corner of said Section 32, ranging thence North 89°58'24" West 139.93 feet along an existing fence to an existing fence corner; thence extended to an existing fence extending fence to an existing fence corner; thence South 89°58'51" East 139.55 feet along an existing fence and said fence extended to the West right-of-way line of Washington Boulevard; thence South 0°50'15" West 157.41 feet along said right-of-way to the point contains 0.263 Acre

I further certify that the above plat correctly shows the dimensions of the property surveyed and of the improvements, fences, gates, and other appurtenances on the property, and that the same are in accordance with the original survey of the property.

Date: 4-11-2000

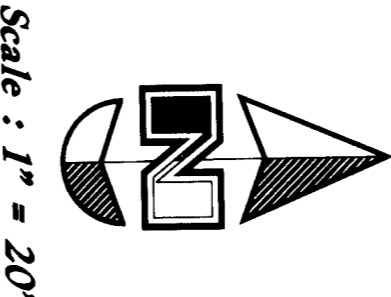

RECEIVED
APR 2 2000
Weber County Survey

As-Built Survey

GREAT BASIN ENGINEERING NORTH

4778
P.O. Box 5307 Ogden, Utah 84208
99N313AV

SCALE: 1" = 20'

DATE: 11 APR 2000

REVISIONS: 002475

Colosimo Titensor Property

A part of the Southwest 1/4 of Section 32, North Ogden City, Weber County, Utah

99N313