

002508







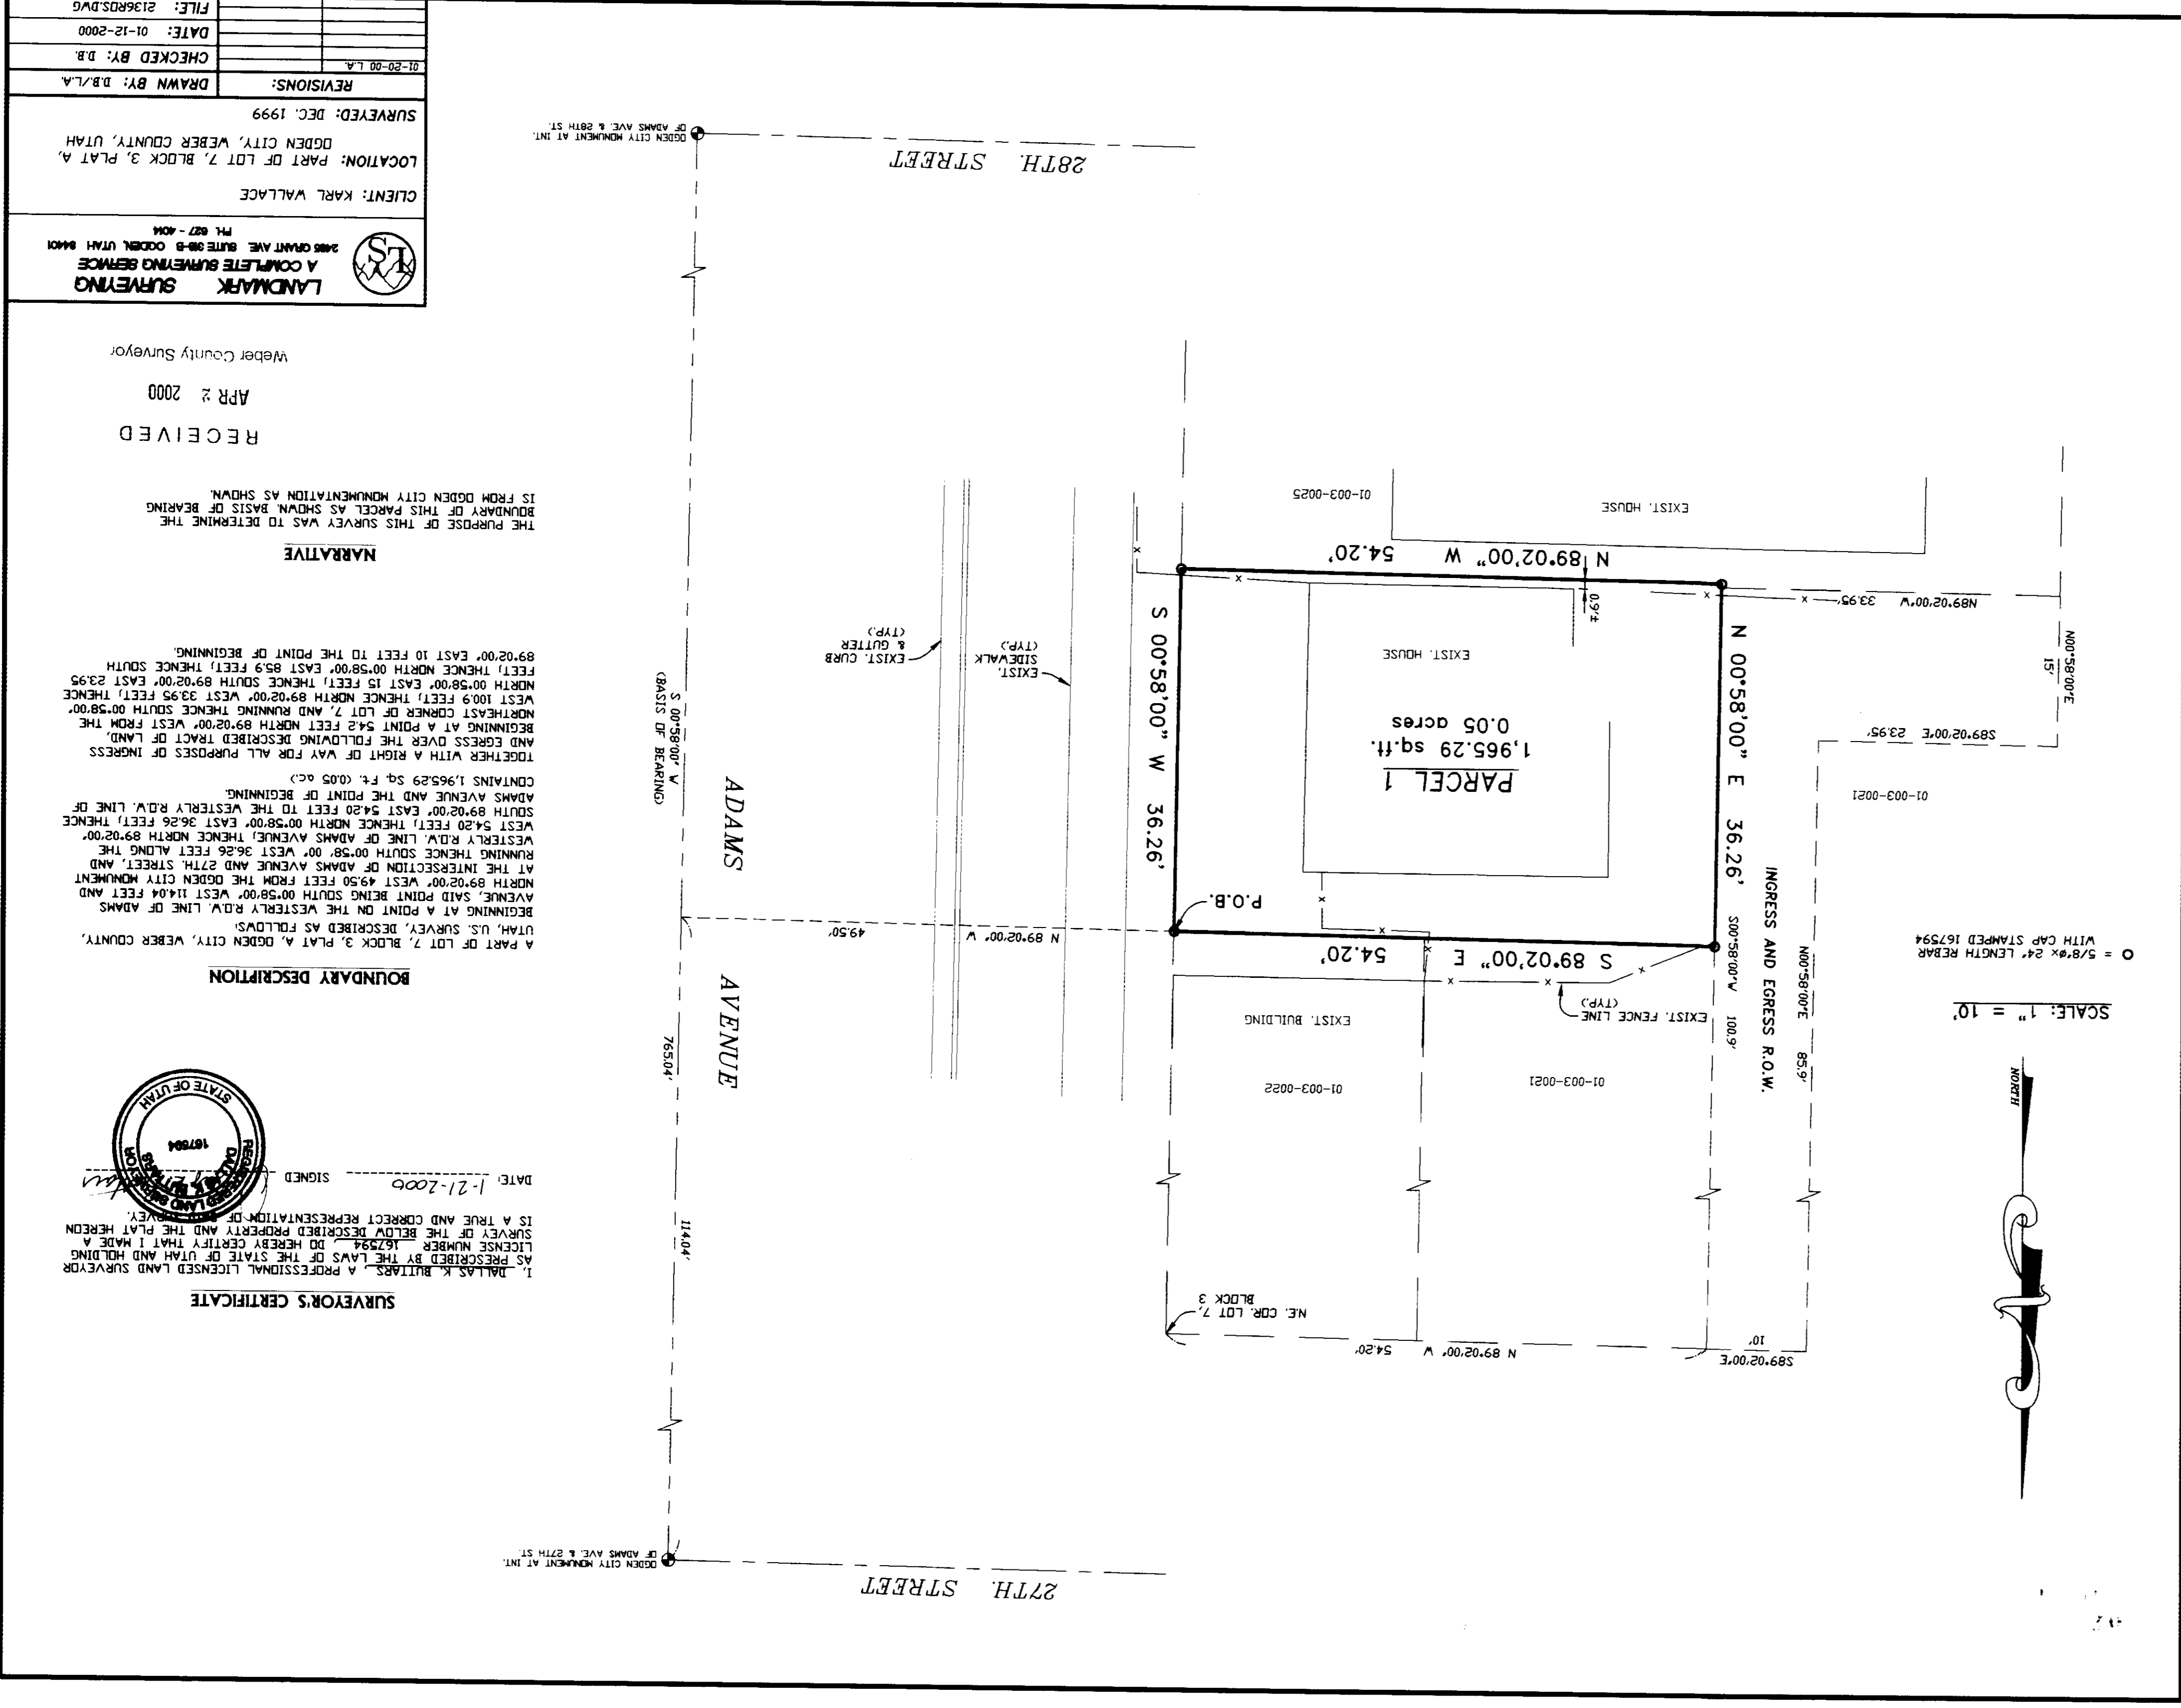

SCALE: 1" = 10'
 O = 5/8" x 24' LENGTH REBAR WITH CAP STAMPED 167594



SURVEYOR'S CERTIFICATE
 DATE: 1-21-2000 SIGNED: [Signature]



BOUNDARY DESCRIPTION

A PART OF LOT 7, BLOCK 3, PLAT A, DODGEN CITY, WEBER COUNTY, UTAH, U.S. SURVEY, DESCRIBED AS FOLLOWS:
 BEGINNING AT A POINT ON THE WESTERLY R.O.W. LINE OF ADAMS AVENUE, SAID POINT BEING SOUTH 00°58'00" WEST 114.04 FEET AND NORTH 99°02'00" WEST 49.50 FEET FROM THE DODGEN CITY MONUMENT AT THE INTERSECTION OF ADAMS AVENUE AND 27TH STREET, AND RUNNING THENCE SOUTH 00°58'00" WEST 36.
 TOGETHER WITH A RIGHT OF WAY FOR ALL PURPOSES OF INGRESS AND EGRESS OVER THE FOLLOWING DESCRIBED TRACT OF LAND, BEGINNING AT A POINT 54.2 FEET NORTH 89°02'00" WEST FROM THE NORTHEAST CORNER OF LOT 7, AND RUNNING THENCE SOUTH 00°58'00" WEST 100.
 CONTAINS 1,965.29 sq. ft. (0.05 ac.)

NARRATIVE

THE PURPOSE OF THIS SURVEY WAS TO DETERMINE THE BOUNDARY OF THIS PARCEL, AS SHOWN BASIS OF BEARING IS FROM DODGEN CITY MONUMENTATION AS SHOWN.

RECEIVED
 APR 2 2000
 Weber County Surveyor

LANDMARK SURVEYING
 A COMPLETE SURVEYING SERVICE

CLIENT: KARL WALLACE
 LOCATION: PART OF LOT 7, BLOCK 3, PLAT A, DODGEN CITY, WEBER COUNTY, UTAH
 SURVEYED: DEC. 1999

REVISIONS:	DRAWN BY: D.B./L.A.
CHECKED BY: D.B.	DATE: 01-12-2000
FILE: 2136R05.DWG	