


SCALE - 1" = 20'  
W/CAP STAMPED 1/23/97  
5/8" X 24" LENGTH REBAR

02509

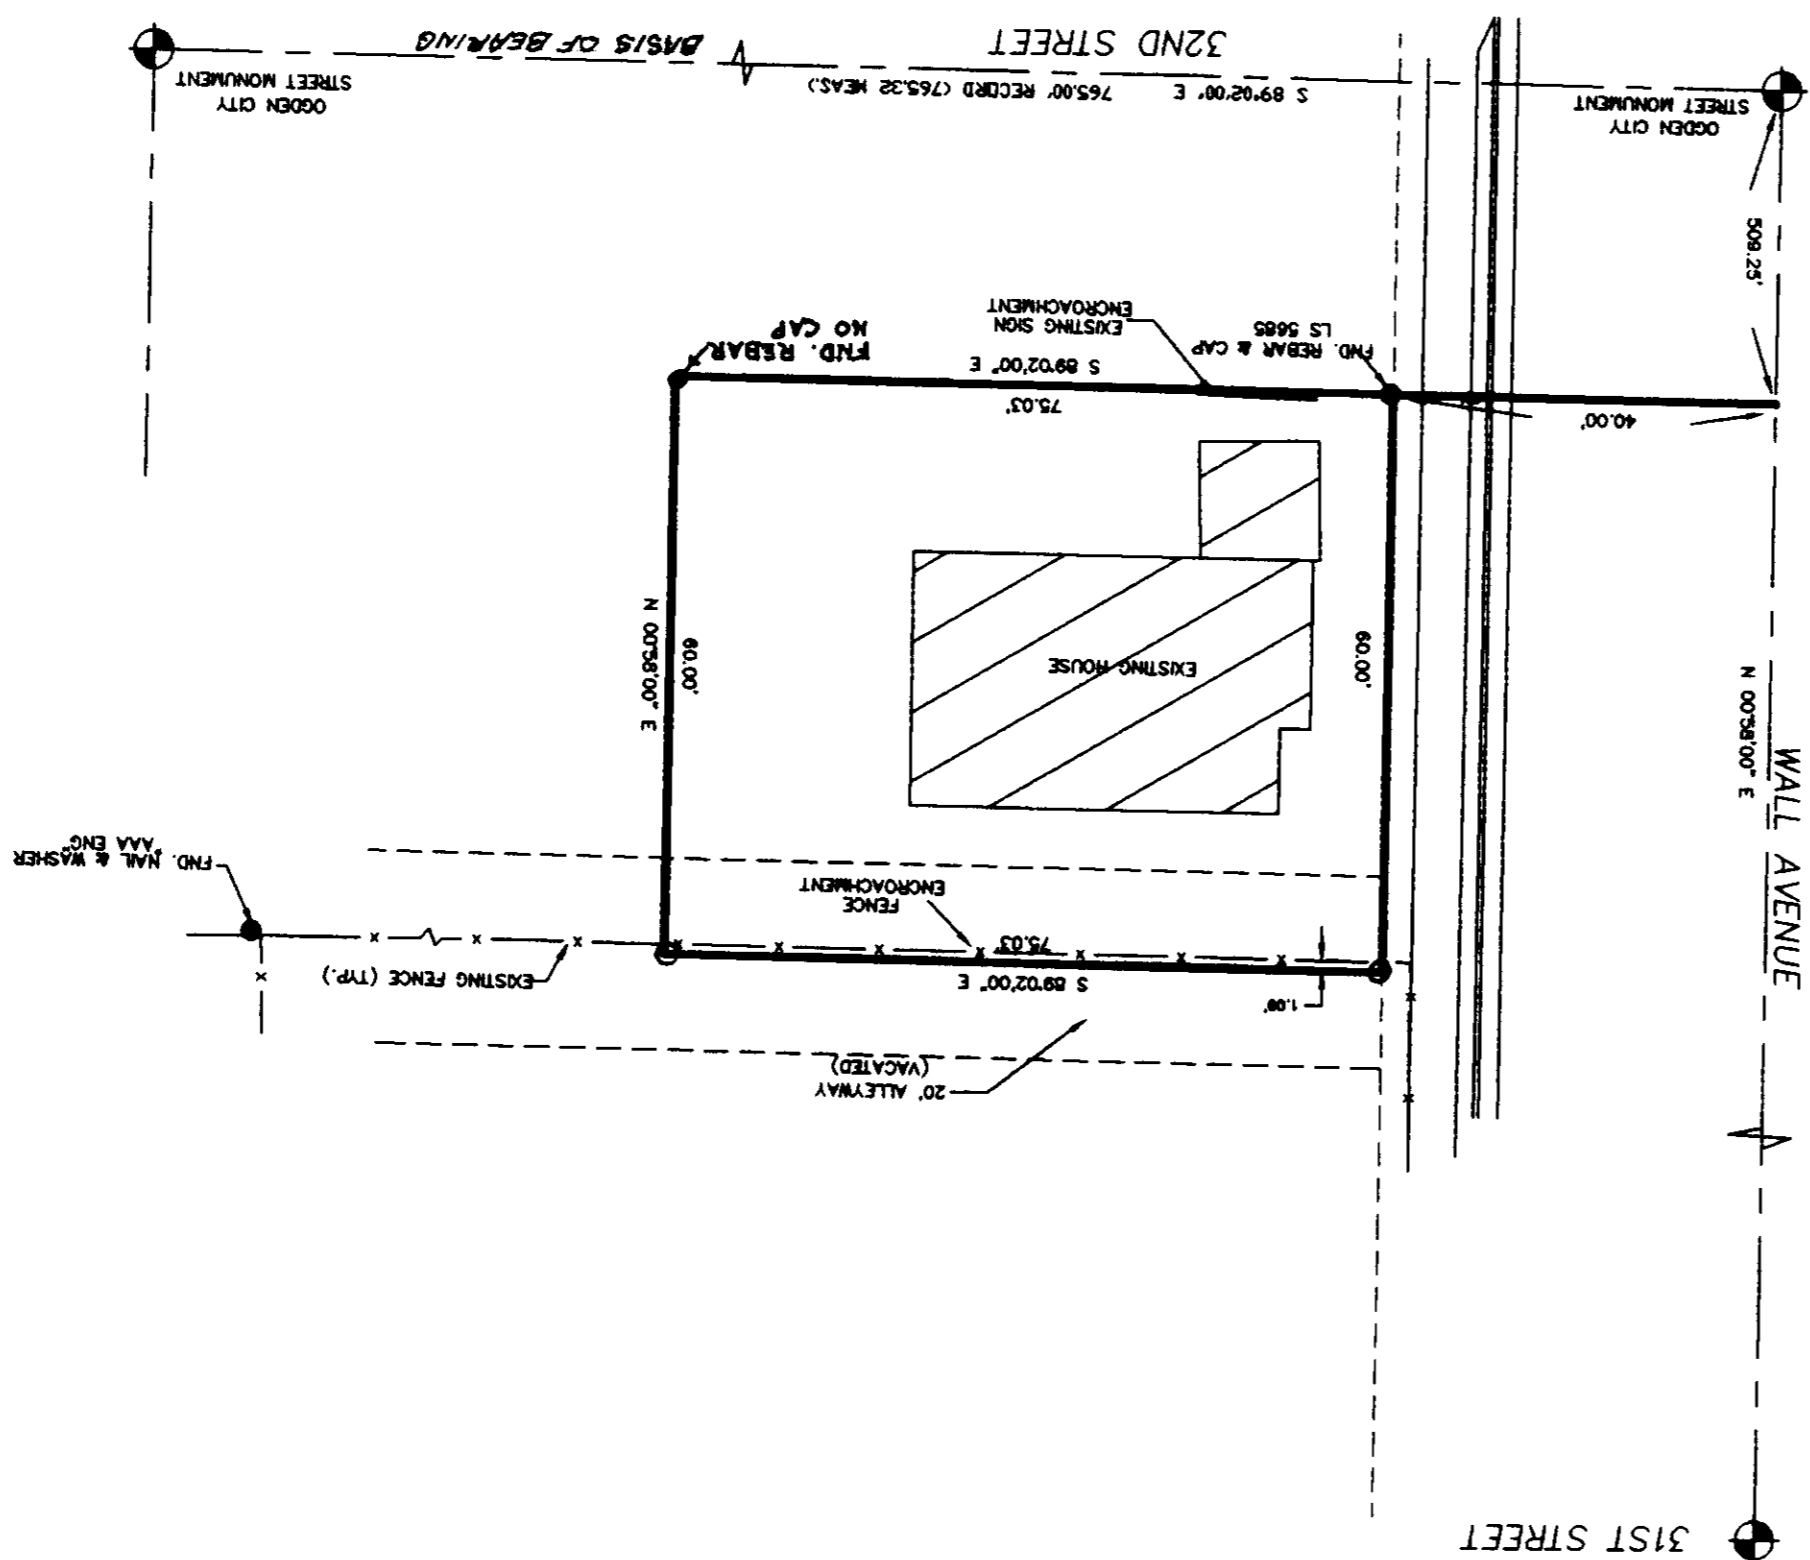

31ST STREET

WALL AVENUE

32ND STREET

BASIS OF BEARING

•SURVEYOR'S CERTIFICATE•

I, DOUG L. GRAHAM A PROFESSIONAL LICENSED LAND SURVEYOR AS PRESCRIBED BY THE LAWS OF THE STATE OF UTAH AND HOLDING LICENSE NUMBER 172757 DO HEREBY CERTIFY THAT A SURVEY OF THE BELIEVED PROPERTY WAS MADE UNDER MY DIRECTION AND THAT HEREON IS A TRUE AND CORRECT REPRESENTATION OF SAID SURVEY TO THE BEST OF MY KNOWLEDGE AND BELIEF.

DATE: 7-22-98 SIGN: *[Signature]*

•BOUNDARY DESCRIPTION•

A PART OF LOTS 1, 2, 1000.

•NARRATIVE•



RECEIVED  
APR 2, 2000  
Weber County Surveyor

REVISIONS:	
DRAWN BY: D.L.G.	
CHECKED BY:	
DATE: 4-21-98	
FILE: 1973	

SURVEYED: APRIL 1998  
PH 807-404  
LANDMARK SURVEYING  
A COMPLETE SURVEYING SERVICE

02509




