

**SURVEYOR'S CERTIFICATE**  




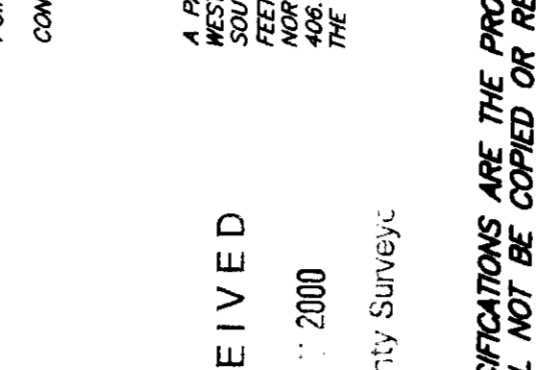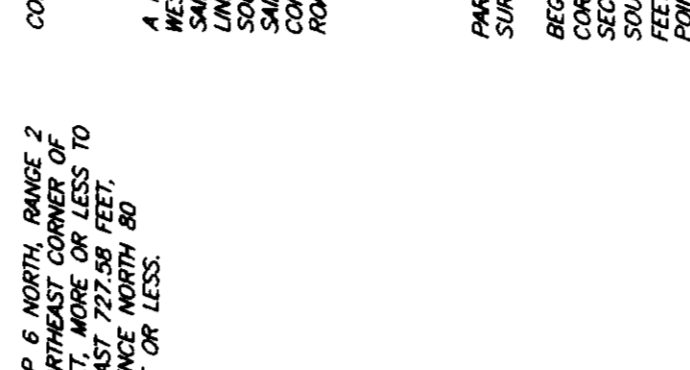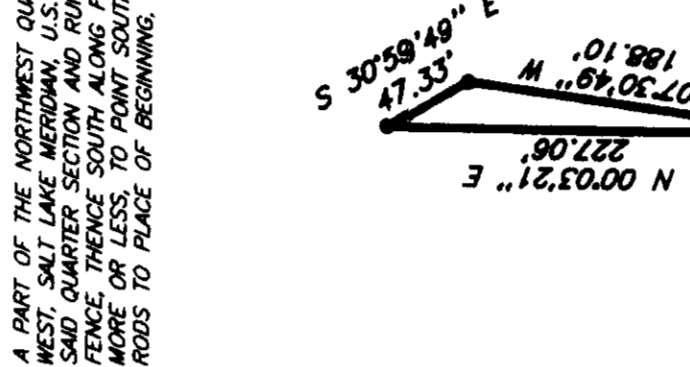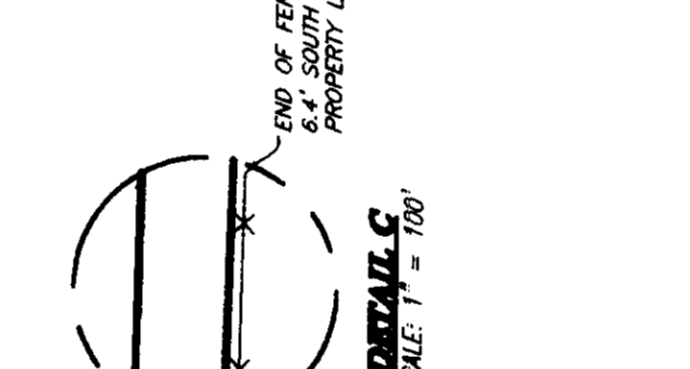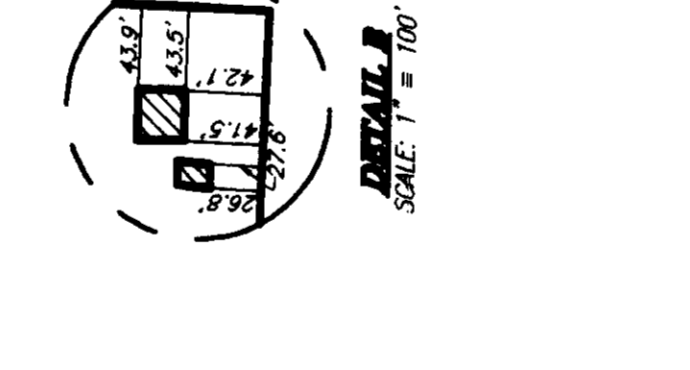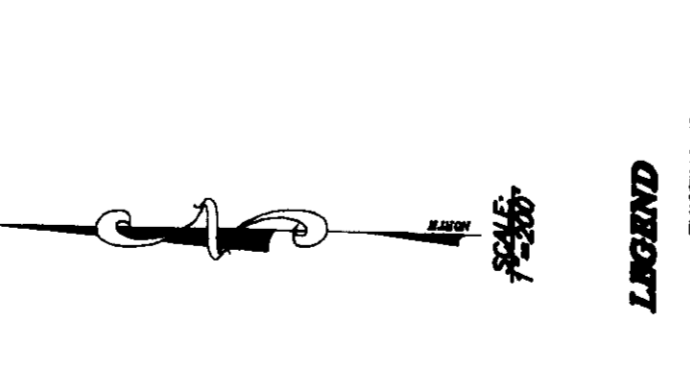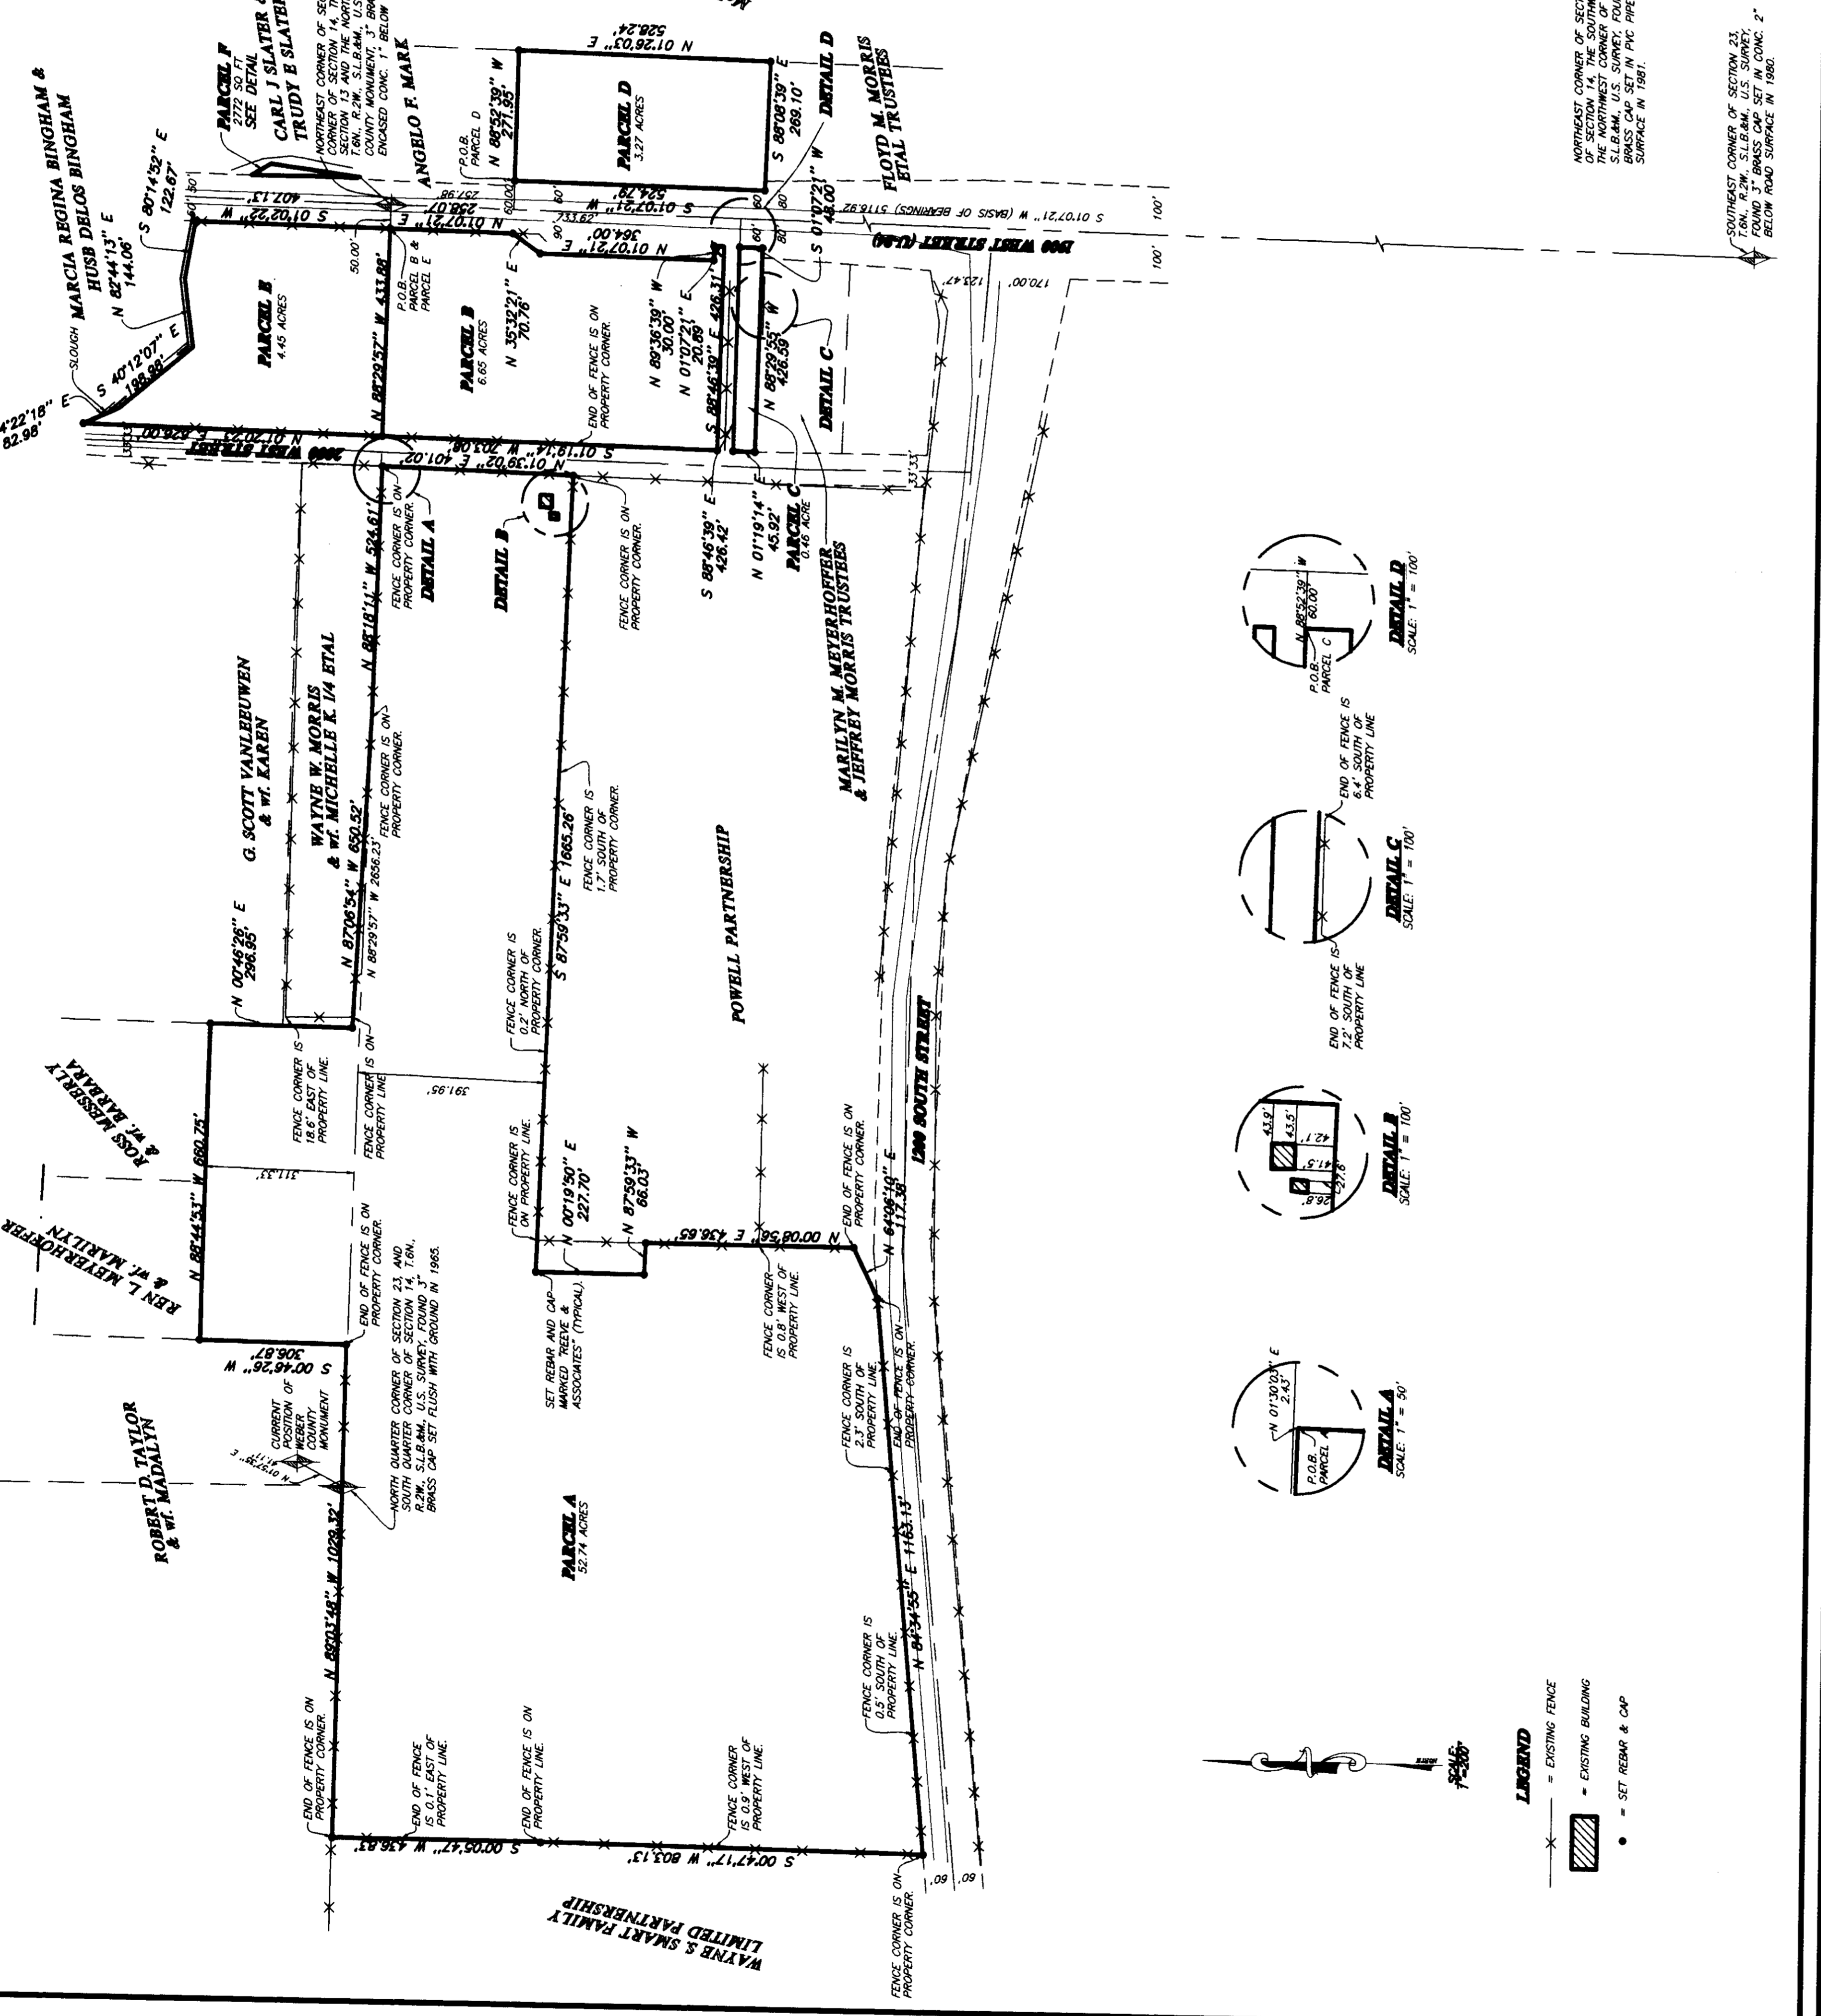










**RECORD OF SURVEY**

**MORRIS PROPERTY**  
PART OF THE NORTH QUARTER OF SECTION 23, T.6N., R.2W., S.18&M., U.S. SURVEY, BEING MAY, 1989

Civil Engineering & Surveying  
Surveying & Land Planning - Landscape Architecture  
3870 QUINCY AVE. STE. F1  
LOMA, UTAH 84337  
(801) 821-3100 FAX (801) 821-2866 (435) 722-3200 FAX (435) 722-2266

REVISIONS  
1. \_\_\_\_\_  
2. \_\_\_\_\_  
3. \_\_\_\_\_  
4. \_\_\_\_\_  
5. \_\_\_\_\_  
6. \_\_\_\_\_

PROJECT NO. \_\_\_\_\_  
DATE: OCTOBER 28, 1999  
SCALE: 1"=100'

SURVEYOR: R. WILFORD  
DRAWN: J. BROWN  
CHECKED: \_\_\_\_\_

RECEIVED  
JUL 11 2000  
Weber County Surveyor

THESE PLANS AND SPECIFICATIONS ARE THE PROPERTY OF REVEE & ASSOC., INC., 3870 QUINCY AVE., OGDEN, UTAH. CHANGES AND SPECIFICATIONS WILL NOT BE MADE OR REPRODUCED WITHOUT THEIR WRITTEN PERMISSION.

002537