
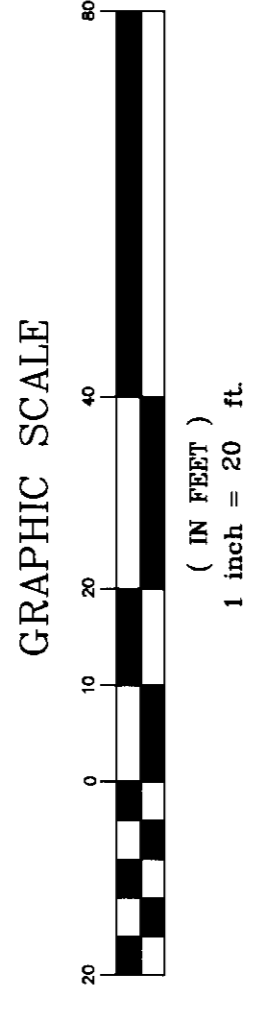
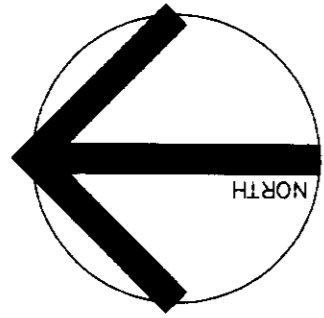


NORTHWEST CORNER
 SEC. 22, T.1N., E.21W., S.86M
 1900 WEST & 5600 SOUTH
 B.M. ELEV. = 5092.43

SOUTH 1/4 CORNER
 SEC. 18, T.1N., E.21W., S.86M
 1900 WEST & 6000 SOUTH
 B.M. ELEV. = 5096.78

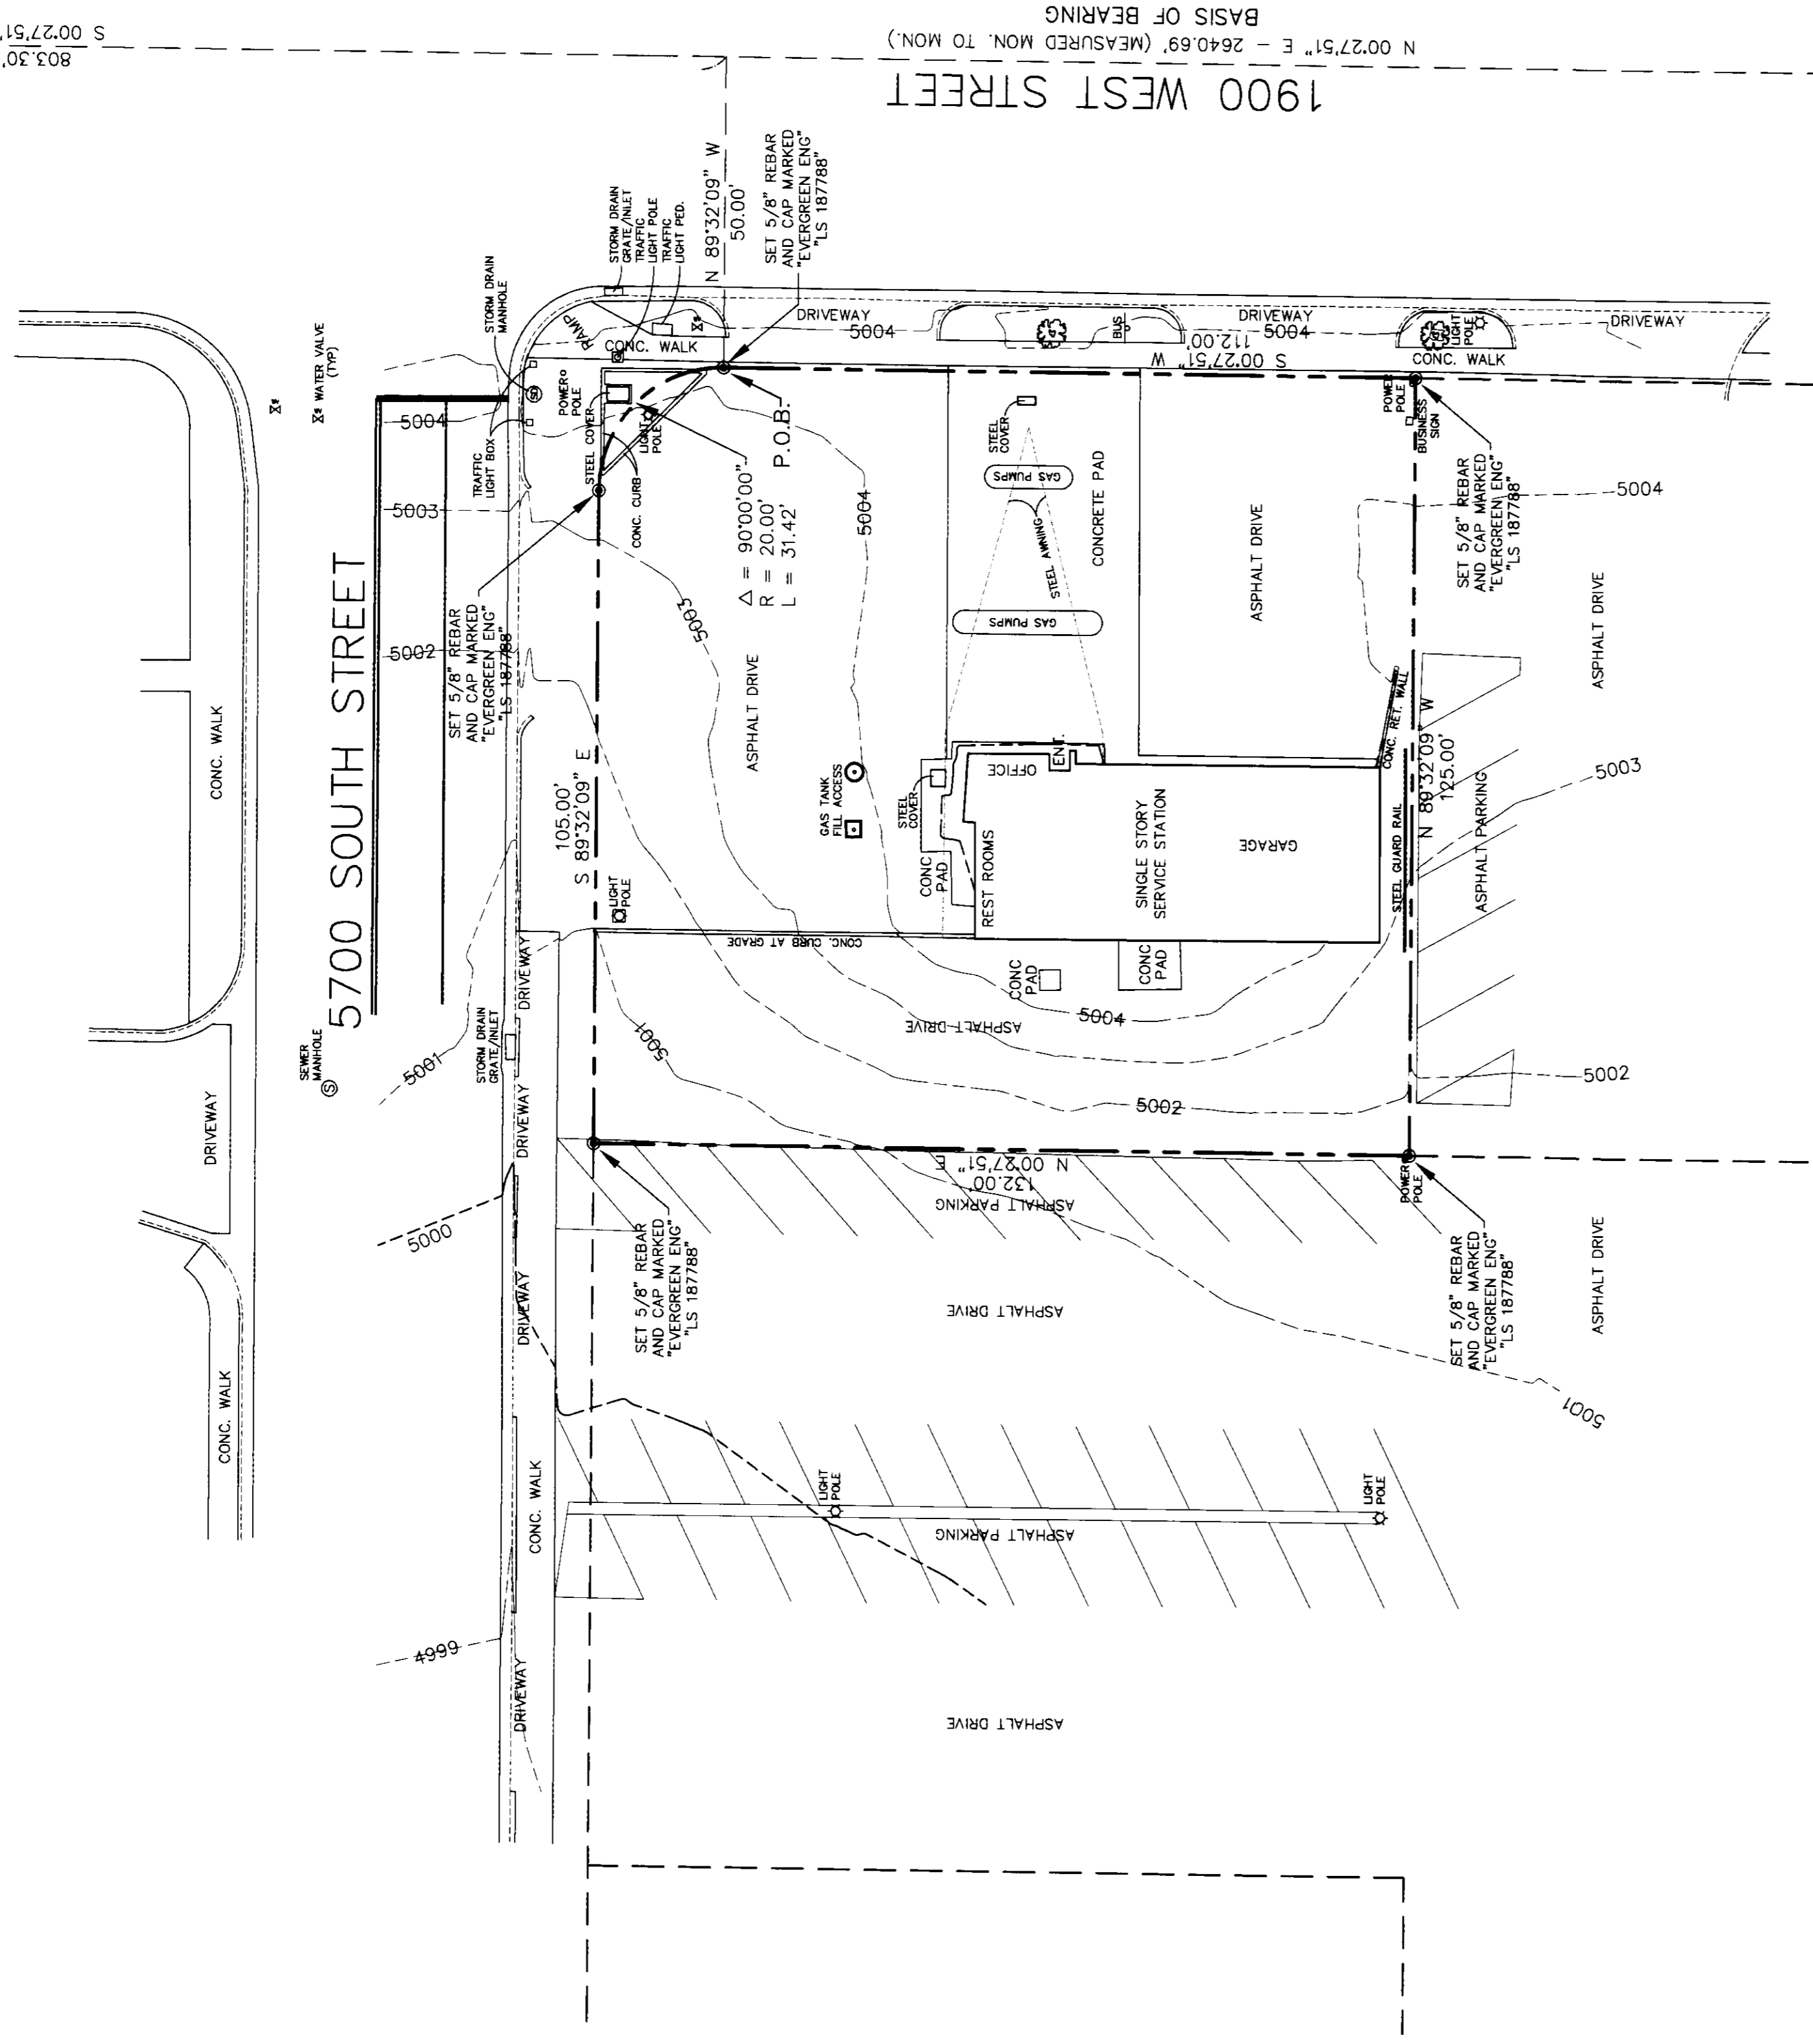

SURVEYOR'S CERTIFICATE

I, GREGORY R. WERBACH, of PARK CITY, UTAH, CERTIFY THAT I AM A LICENSED SURVEYOR AND LAND SURVEYOR IN THE STATE OF UTAH, AND THAT I HAVE PERFORMED A SURVEY OF THE PROPERTY SHOWN HEREON, AND THAT THE DATA AND RESULTS THEREON ARE A CORRECT REPRESENTATION OF THE LAND SURVEYED AND HAS BEEN PREPARED IN CONFORMANCE WITH THE UTAH STATUTES AND REGULATIONS OF THE UTAH SURVEYORS.

DATE: 6/12/2006

GREGORY R. WERBACH

LEGAL DESCRIPTION



ABBREVIATIONS

1. BEARSURD MONUMENTS AS SHOWN HEREON.
2. PROPERTY CORNERS SET AS SHOWN HEREON.
4. DATE OF SURVEY, JUNE 9, 2006.
5. SURVEY REQUESTED BY, DEBBIE FERRY.
6. SURVEY REQUESTED FOR, DEBBIE FERRY.
7. SURVEY FOR, DEBBIE FERRY.
8. CONTOURS ARE SHOWN AT 1 FOOT INTERVALS.
9. CONTOUR ELEVATIONS ARE NOT SEA LEVEL.

THE OWNERS OF THIS PROPERTY SHOULD BE AWARE OF ANY ITEMS AFFECTING THE PROPERTY AND THE SURVEY, SUCH AS EASEMENTS, ENCROACHMENTS, OR ENCUMBRANCES FOUND IN THE PUBLIC RECORDS. ANY ITEMS NOT SHOWN ON THIS SURVEY BUT FOUND IN THE PUBLIC RECORDS SHOULD BE NOTED AND ADEQUATELY MARKED. 

RECEIVED
 JUN 12, 2006

WIPAC County Surveyor