002541 002541 002541 002541

F:\Project\L1098\dwg\BOUNDARY.dwg, 06/26/00 01:20:49 PM, Ensign Engineering / JTF

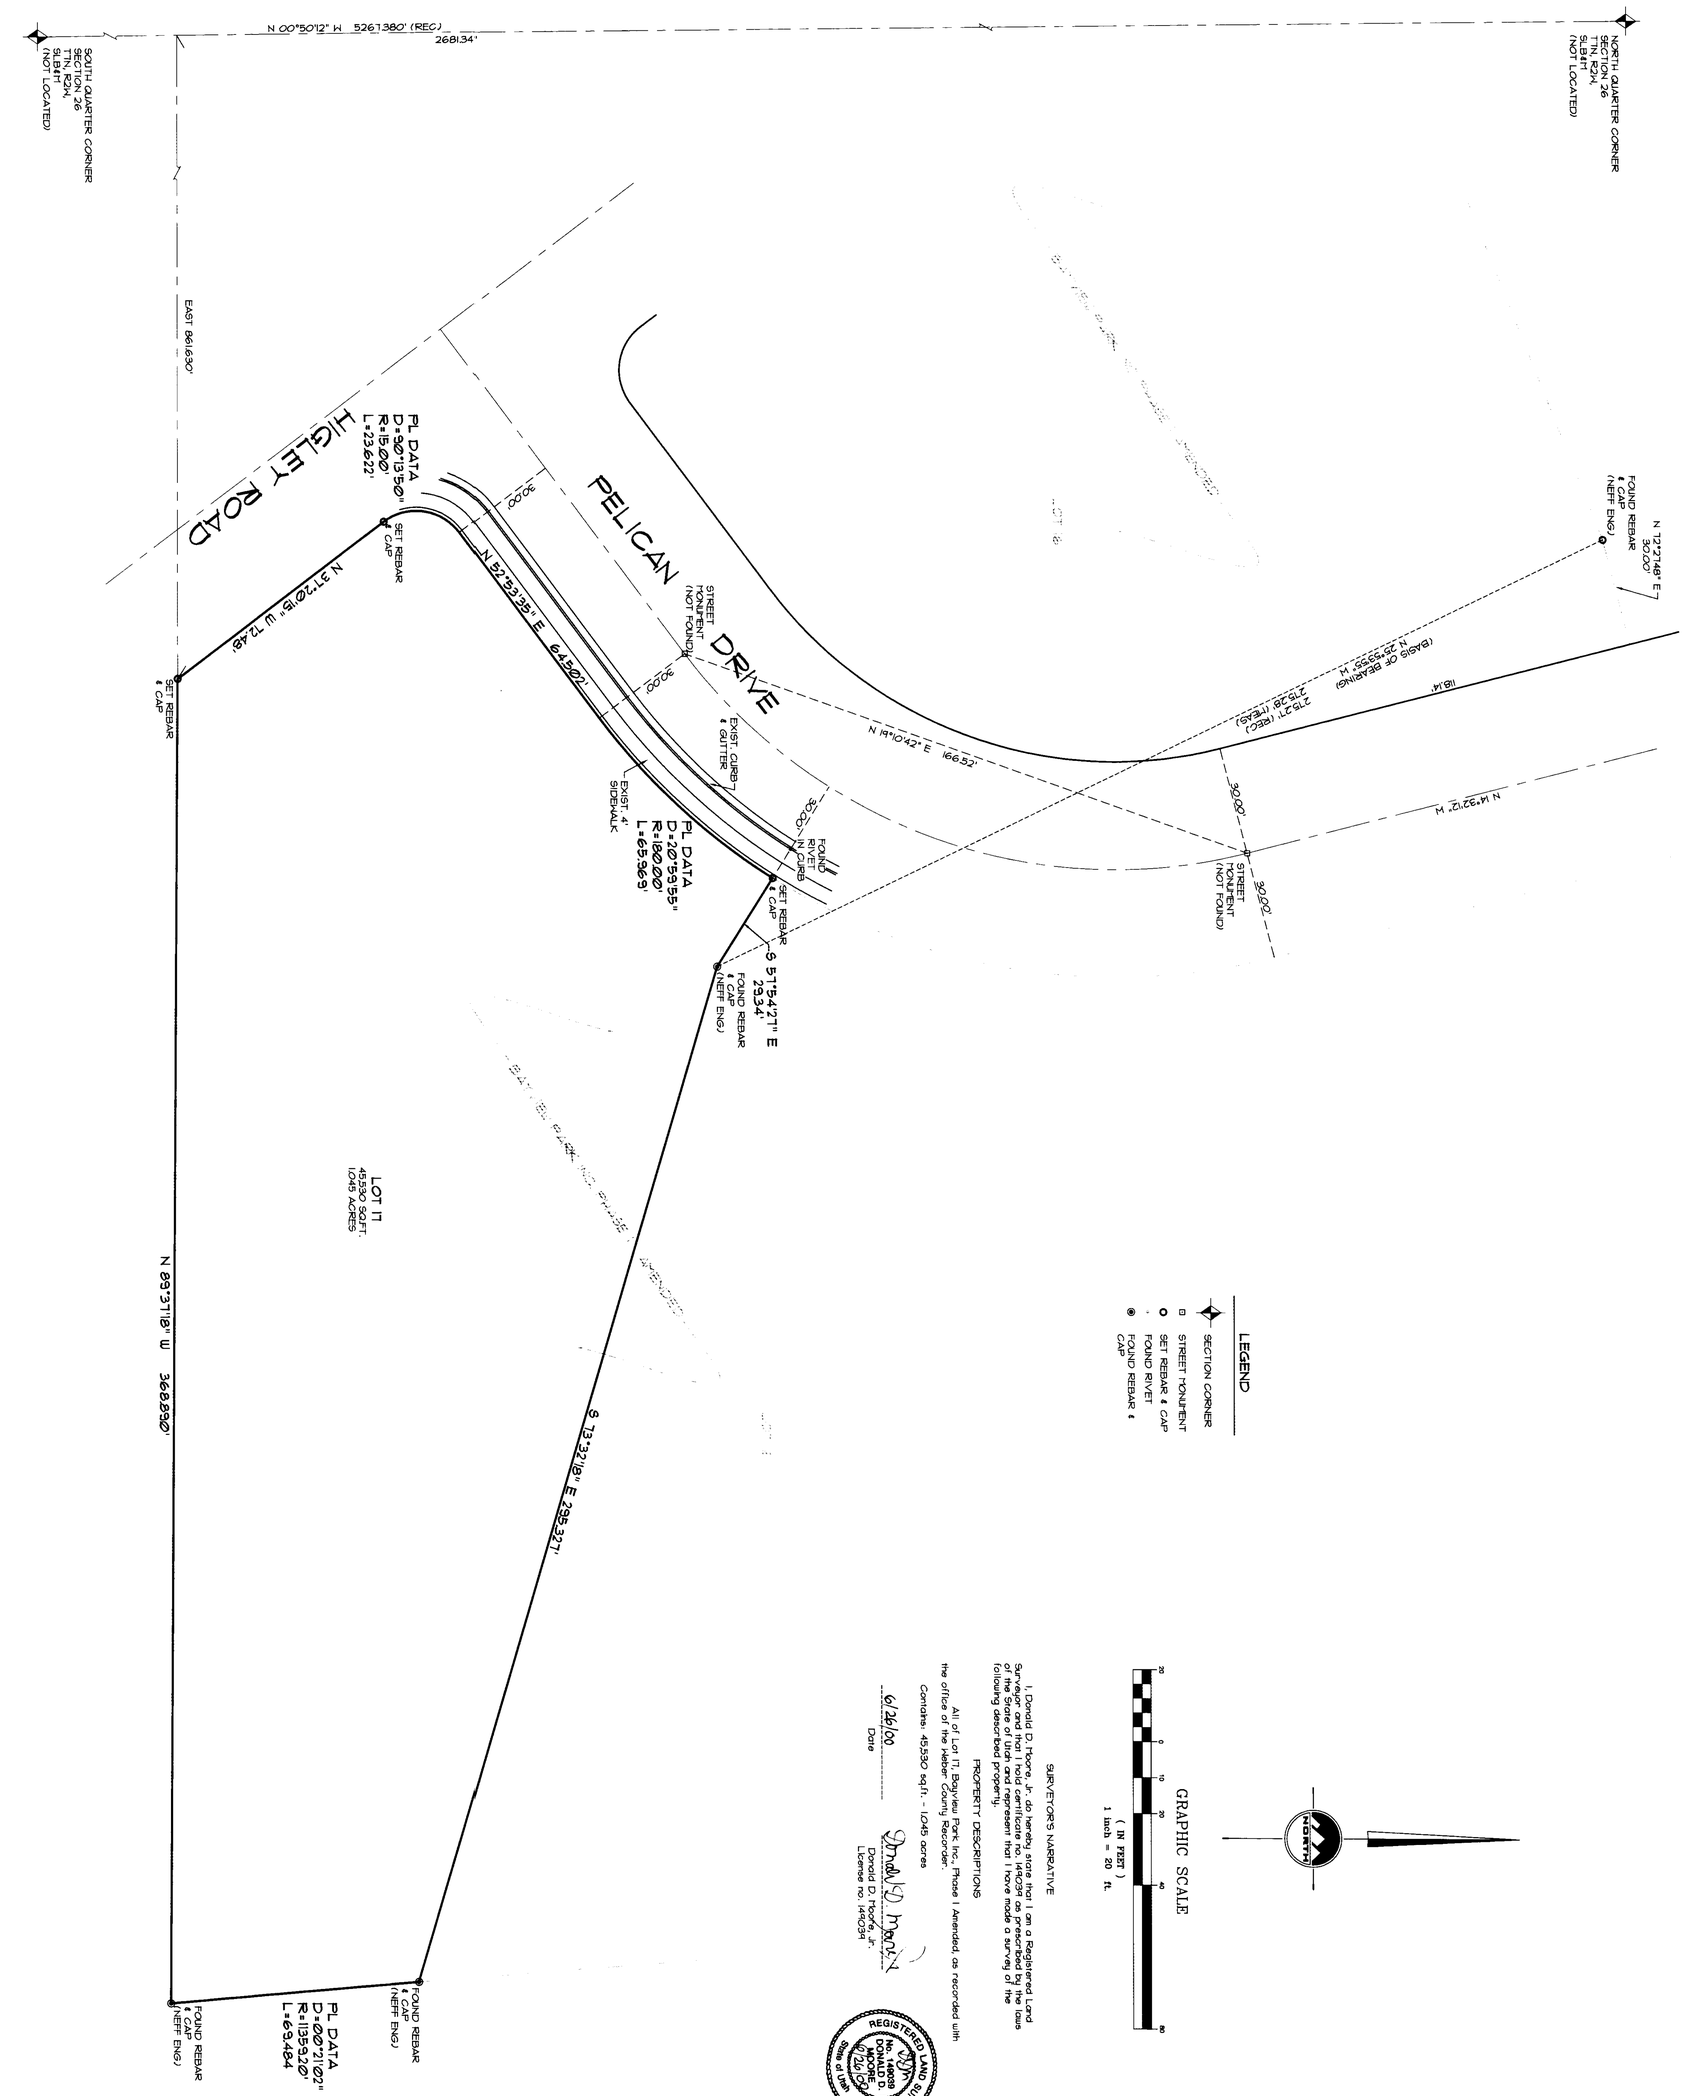

LEGEND

- SECTION CORNER
- STREET MONUMENT
- SET REBAR & CAP
- FOUND RIVET
- FOUND REBAR & CAP

GRAPHIC SCALE

(IN FEET)
1 inch = 20 ft.

NORTH

SURVEYOR'S NARRATIVE

I, Donald D. Moore, Jr. do hereby state that I am a Registered Land Surveyor and that I hold certificate no. 149039 as prescribed by the laws of the State of Utah and represent that I have made a survey of the following described property.

PROPERTY DESCRIPTIONS

All of Lot 17, Bayview Park Inc., Phase I Amended, as recorded with the office of the Weber County Recorder.

Contains: 45,590 sq.ft. - 1.045 acres

6/26/00
Date

Donald D. Moore, Jr.
License no. 149039

REGISTERED LAND SURVEYOR
DONALD D. MOORE
149039
6/26/00
State of Utah

RECEIVED
JUN 28 2000
Weber County Surveyor

002541

file: f:\project\l1098.dwg project no.: L-1098 sheet: 1 of 1	project name: LOT 17, BAYVIEW PARK INC., PH.1 FARR WEST CITY, UTAH sheet title: BOUNDARY SURVEY		9 8 7 6 5 4 3 2 1 No. revision / date / by	ENSIGN engineering • planning • surveying 90 East Fort Union Blvd., Suite 100 Midvale, Utah 84047 (801) 255-0529 fax (801)-255-4449 project manager: STEPHEN FACKRELL drawn by: J. FELT date: 6/20/99

002541