


0.02553

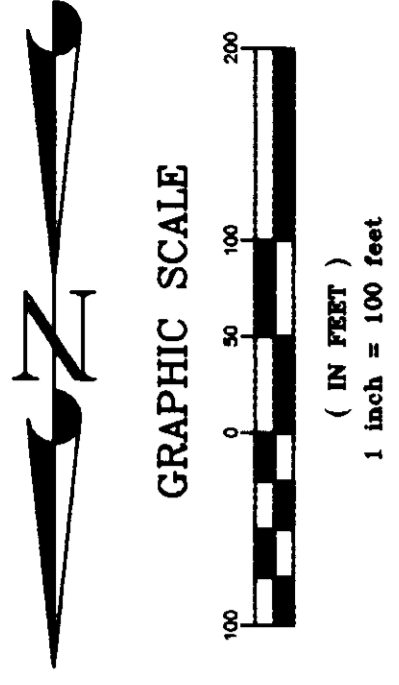


SURVEY BOUNDARY DESCRIPTION
 Beginning at a point which bears North 3713.85 feet and West 204.39 feet from the Ogden City Survey Monument at the intersection of the monument line on 12th Street and the West line of the Northeast Quarter of Section 19 Township 6 North, Range 1 West, Salt Lake Base and Meridian per Ogden City datum and previous survey by Sunrise Engineers and Land Surveyors titled "Perimeter Boundary Survey Defense Depot Ogden, Utah", 1987 and running thence N.03°46'45"W. 887.08 feet; thence N.86°22'23"E. 342.38 feet; thence N.03°27'04"W. 575.72 feet; thence N.03°26'58"W. 170.22 feet; thence N.86°23'02"E. 527.60 feet; thence S.03°31'15"E. 689.19 feet; thence N.46°22'38"E. 111.64 feet; thence S.42°14'08"E. 508.64 feet; thence S.42°57'31"W. 156.48 feet; thence S.12°35'09"E. 444.23 feet; thence S.46°40'50"E. 273.87 feet; thence S.41°49'16"W. 246.21 feet; thence N.48°36'44"W. 354.24 feet; thence S.89°18'43"W. 989.21 feet to the Point of Beginning.
 Containing 35.95 Acres.



NARRATIVE
 1. Ogden City required changes in the previous survey performed on December 10, 1999. Boundary lines are altered on the survey as shown. This change also affects Parcel 12 and Parcel 5 on separate sheets.
 2. Basis of bearing is as shown on plat.

SURVEYOR'S CERTIFICATE
 I, Gregory A. Cates, a Registered Professional Land Surveyor as prescribed by the laws of the State of Utah, and holding License Number 161226, do hereby certify that a survey of the described property was made under my direction and that the plat herein is a true and correct representation of said survey.

LEGEND
 FOUND MONUMENT AS NOTED
 SET 5/8" REBAR & CAP MARKED "CRS ENG" (TYPICAL UNLESS MARKED OTHERWISE)
 FOUND MARKER AS NOTED
 REVISED BOUNDARY
 PREVIOUS BOUNDARY FROM SURVEY OF DEC. 10, 1999 WHICH HAS BEEN RELOCATED

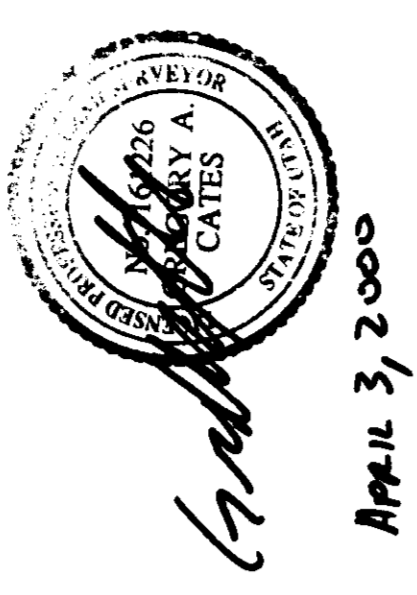

APR. 11. 2000

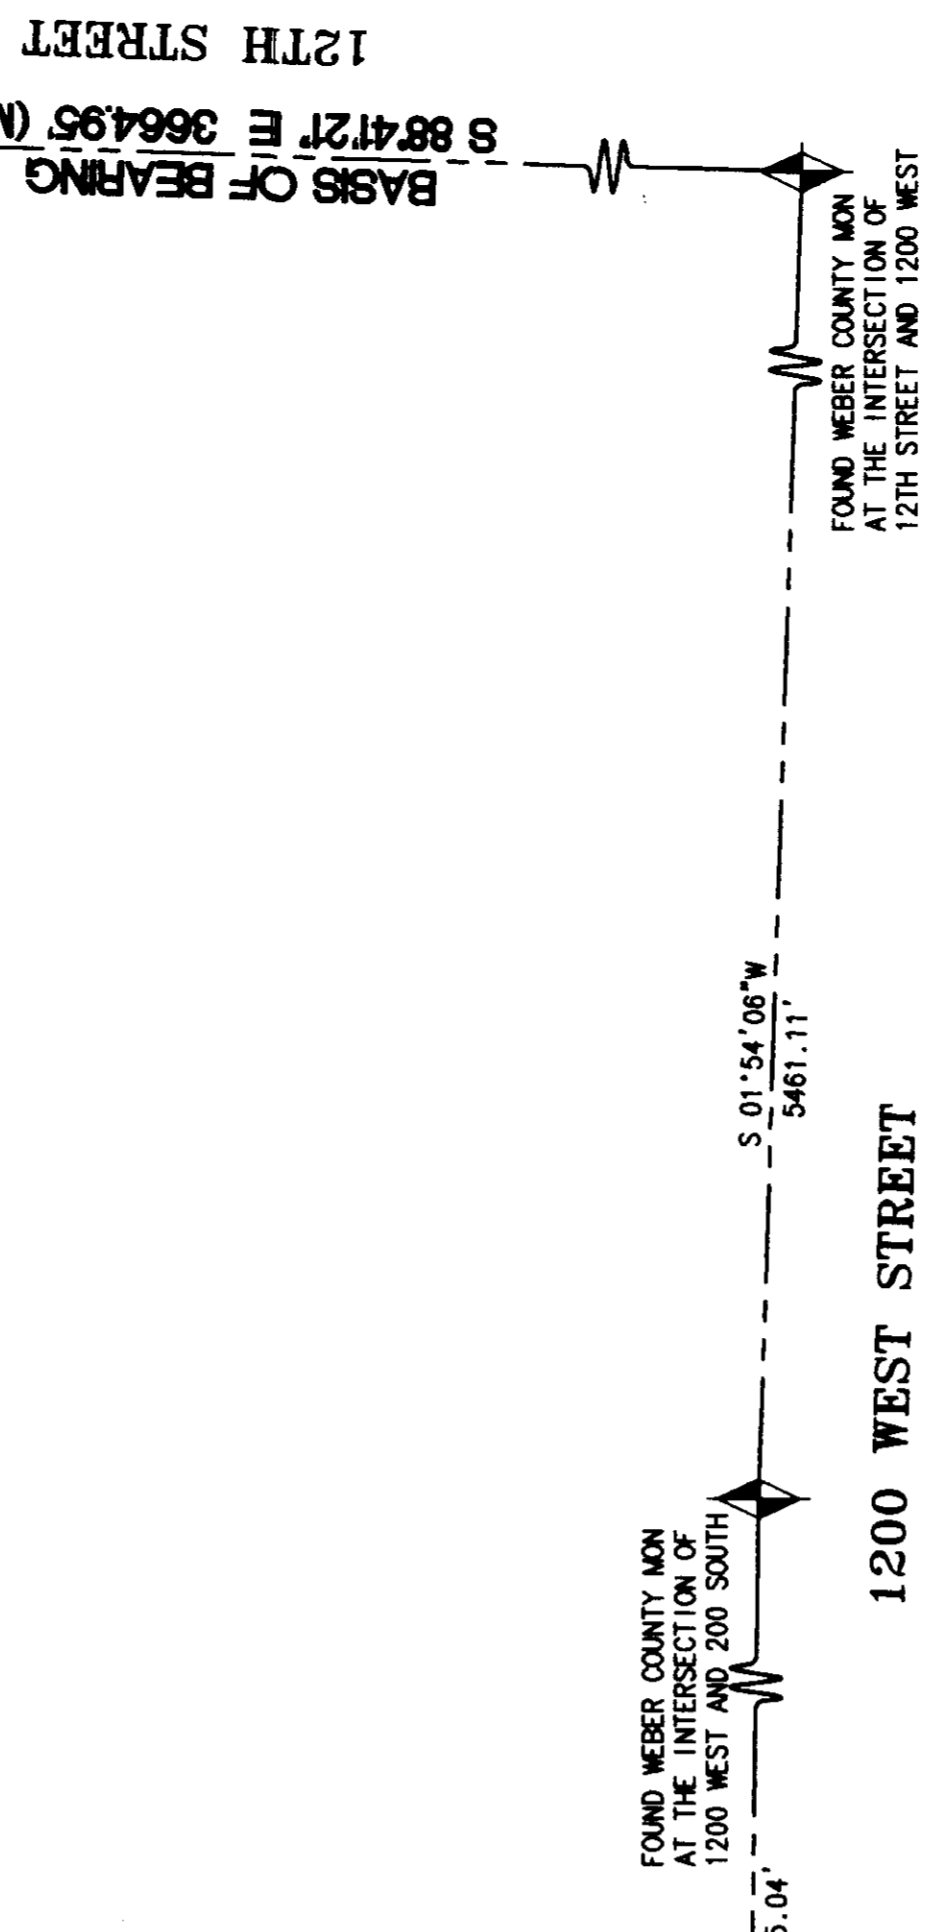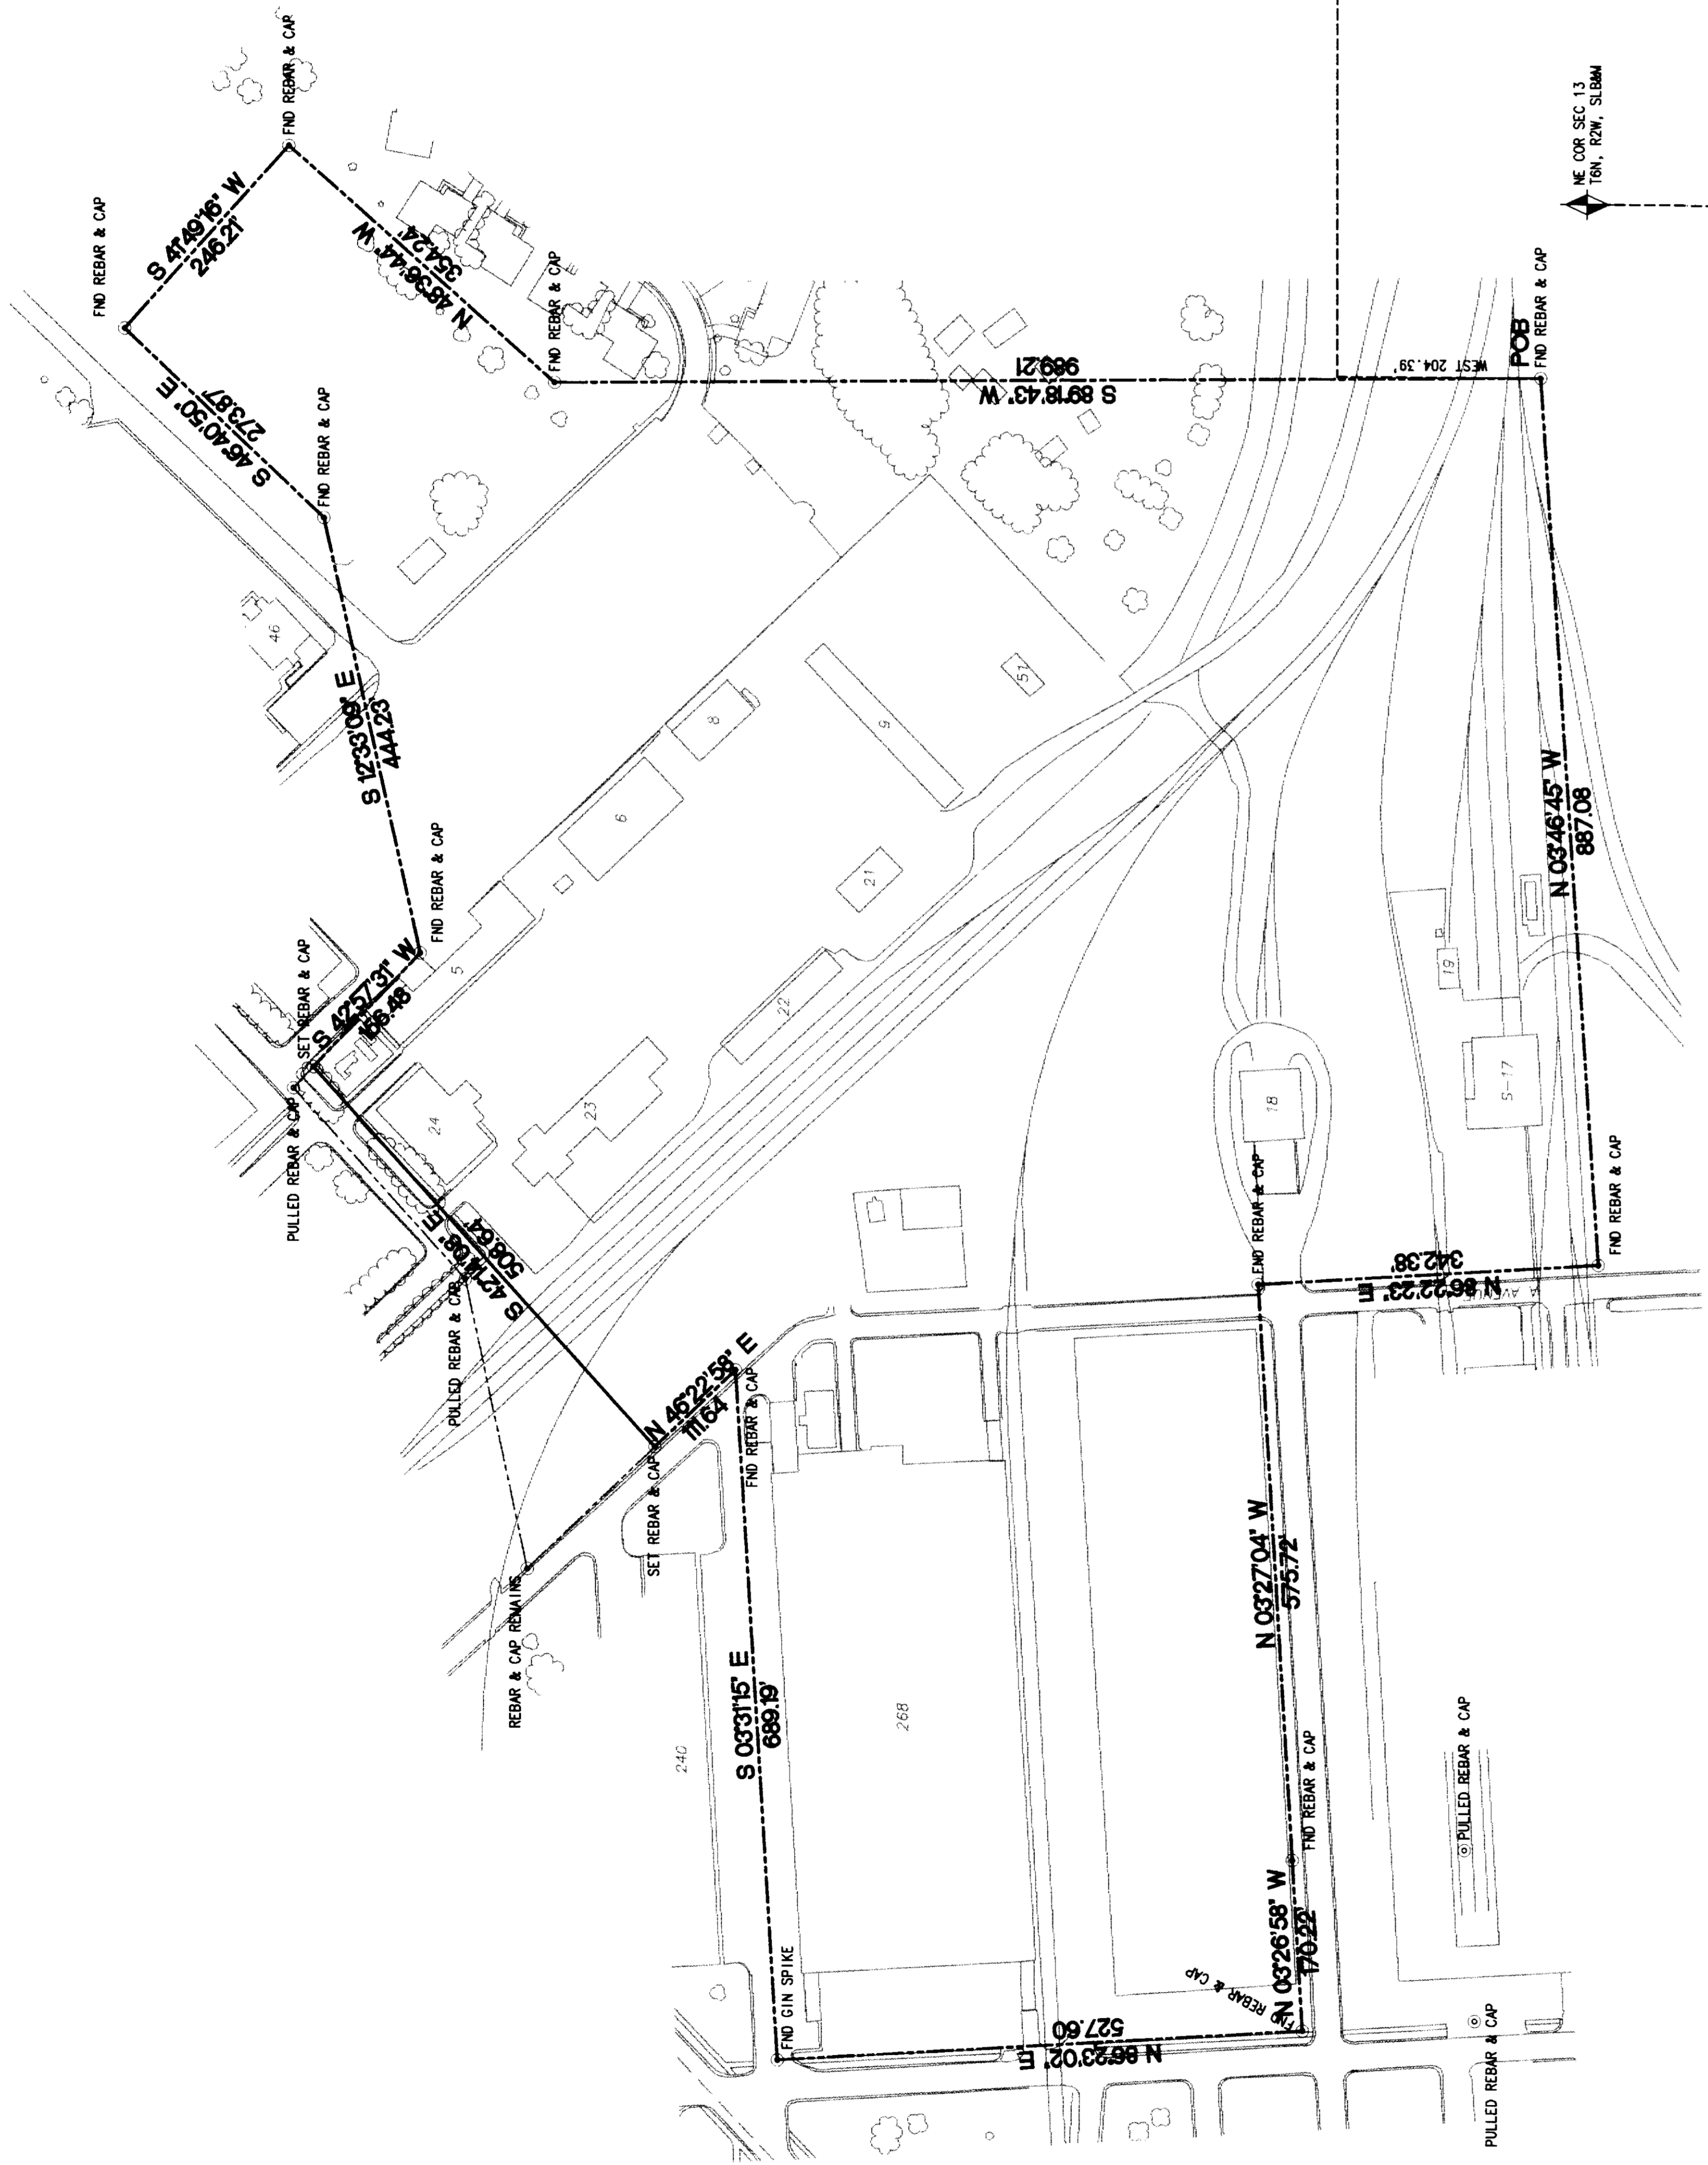

RECEIVED		SHEET 3	
DEFENSE DEPOT OGDEN		OF 3	
PARCEL 16		JULY 2000	
AMENDED MARCH 6, 2000		Weber County Surveyor	
OGDEN		UTAH	
DRAWING NO.			

PRINCIPAL	DATE
PROJECT MANAGER	DATE
CHECKED	DATE
DRAWN	FILE
SCALE	DATE ISSUED
1"=100'-0"	March 29, 2000

REV.	BY	DATE	DESCRIPTION

0.02553



