


002563
 002563
 002563
 002563

CONSTRUCTION & LAND SURVEYORS
 879 GANNON ROAD
 OGDEN, UTAH 84404
 (801) 399-4935

CLIENT STEVE WILNER
 FARM WEST DEVELOPMENT
 SURVEY LOCATION
 NE 1/4 SEC. 16, T. 5N, R. 1W, SEC. 16,
 TOWNSHIP 5 NORTH, RANGE 1 WEST,
 SALT LAKE BASE & MERIDIAN

SURVEY DATE
 JOB No. TP500-080C

CONSTRUCTION & LAND SURVEYORS	
879 GANNON ROAD	84404
OGDEN, UTAH	84404
(801) 399-4935	
CLIENT STEVE WILNER	
FARM WEST DEVELOPMENT	
SURVEY LOCATION	
NE 1/4 SEC. 16, T. 5N, R. 1W, SEC. 16, TOWNSHIP 5 NORTH, RANGE 1 WEST, SALT LAKE BASE & MERIDIAN	
SURVEY DATE	
JOB No. TP500-080C	

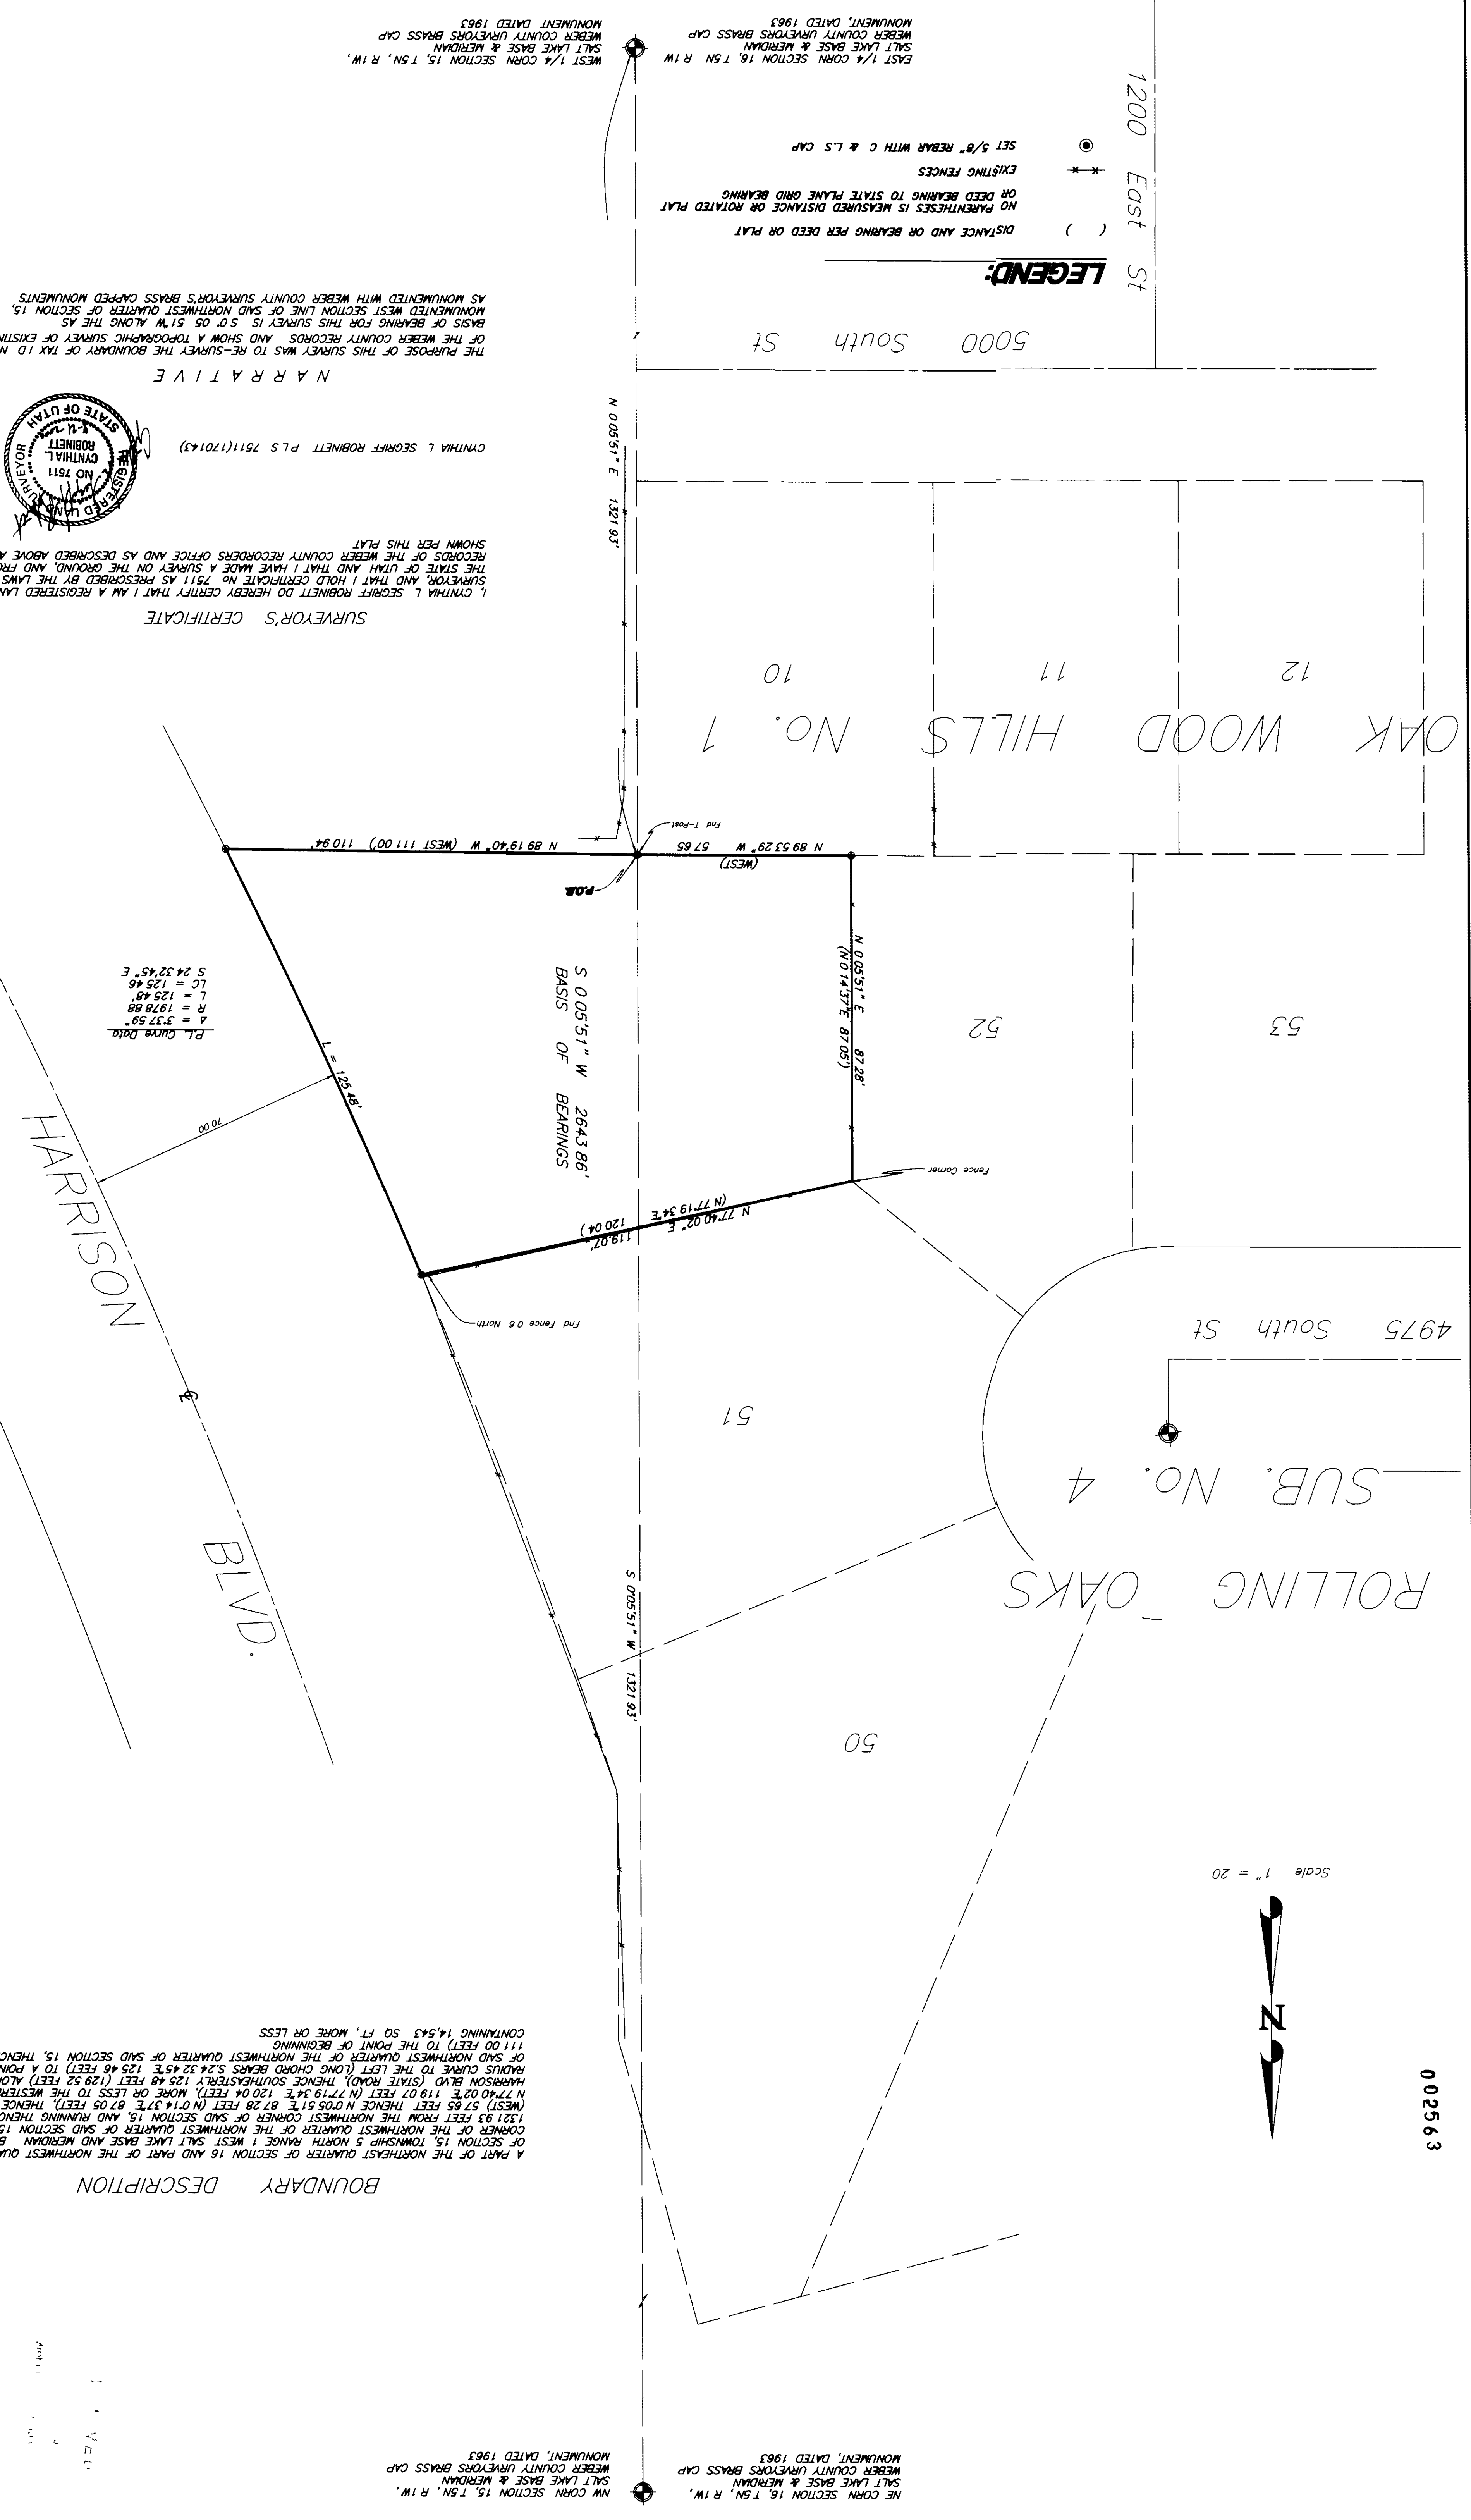

1200 East St
 5000 South St

002563