

SURVEYOR'S CERTIFICATE







DESCRIPTION



NARRATIVE

THE PURPOSE OF THIS SURVEY WAS TO RECOVER AND RESET MISSING PROPERTY CORNERS OF A SURVEY DONE IN 1985 PER JOB NUMBER P.S. 88-11...

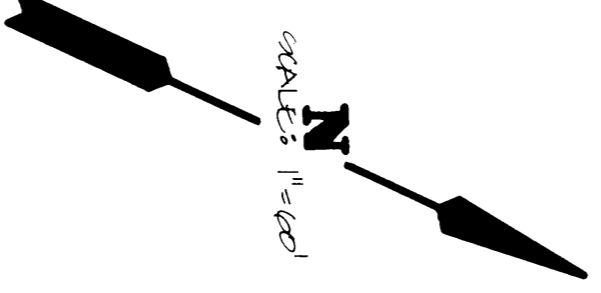

W.I.P.-PLAT "B"

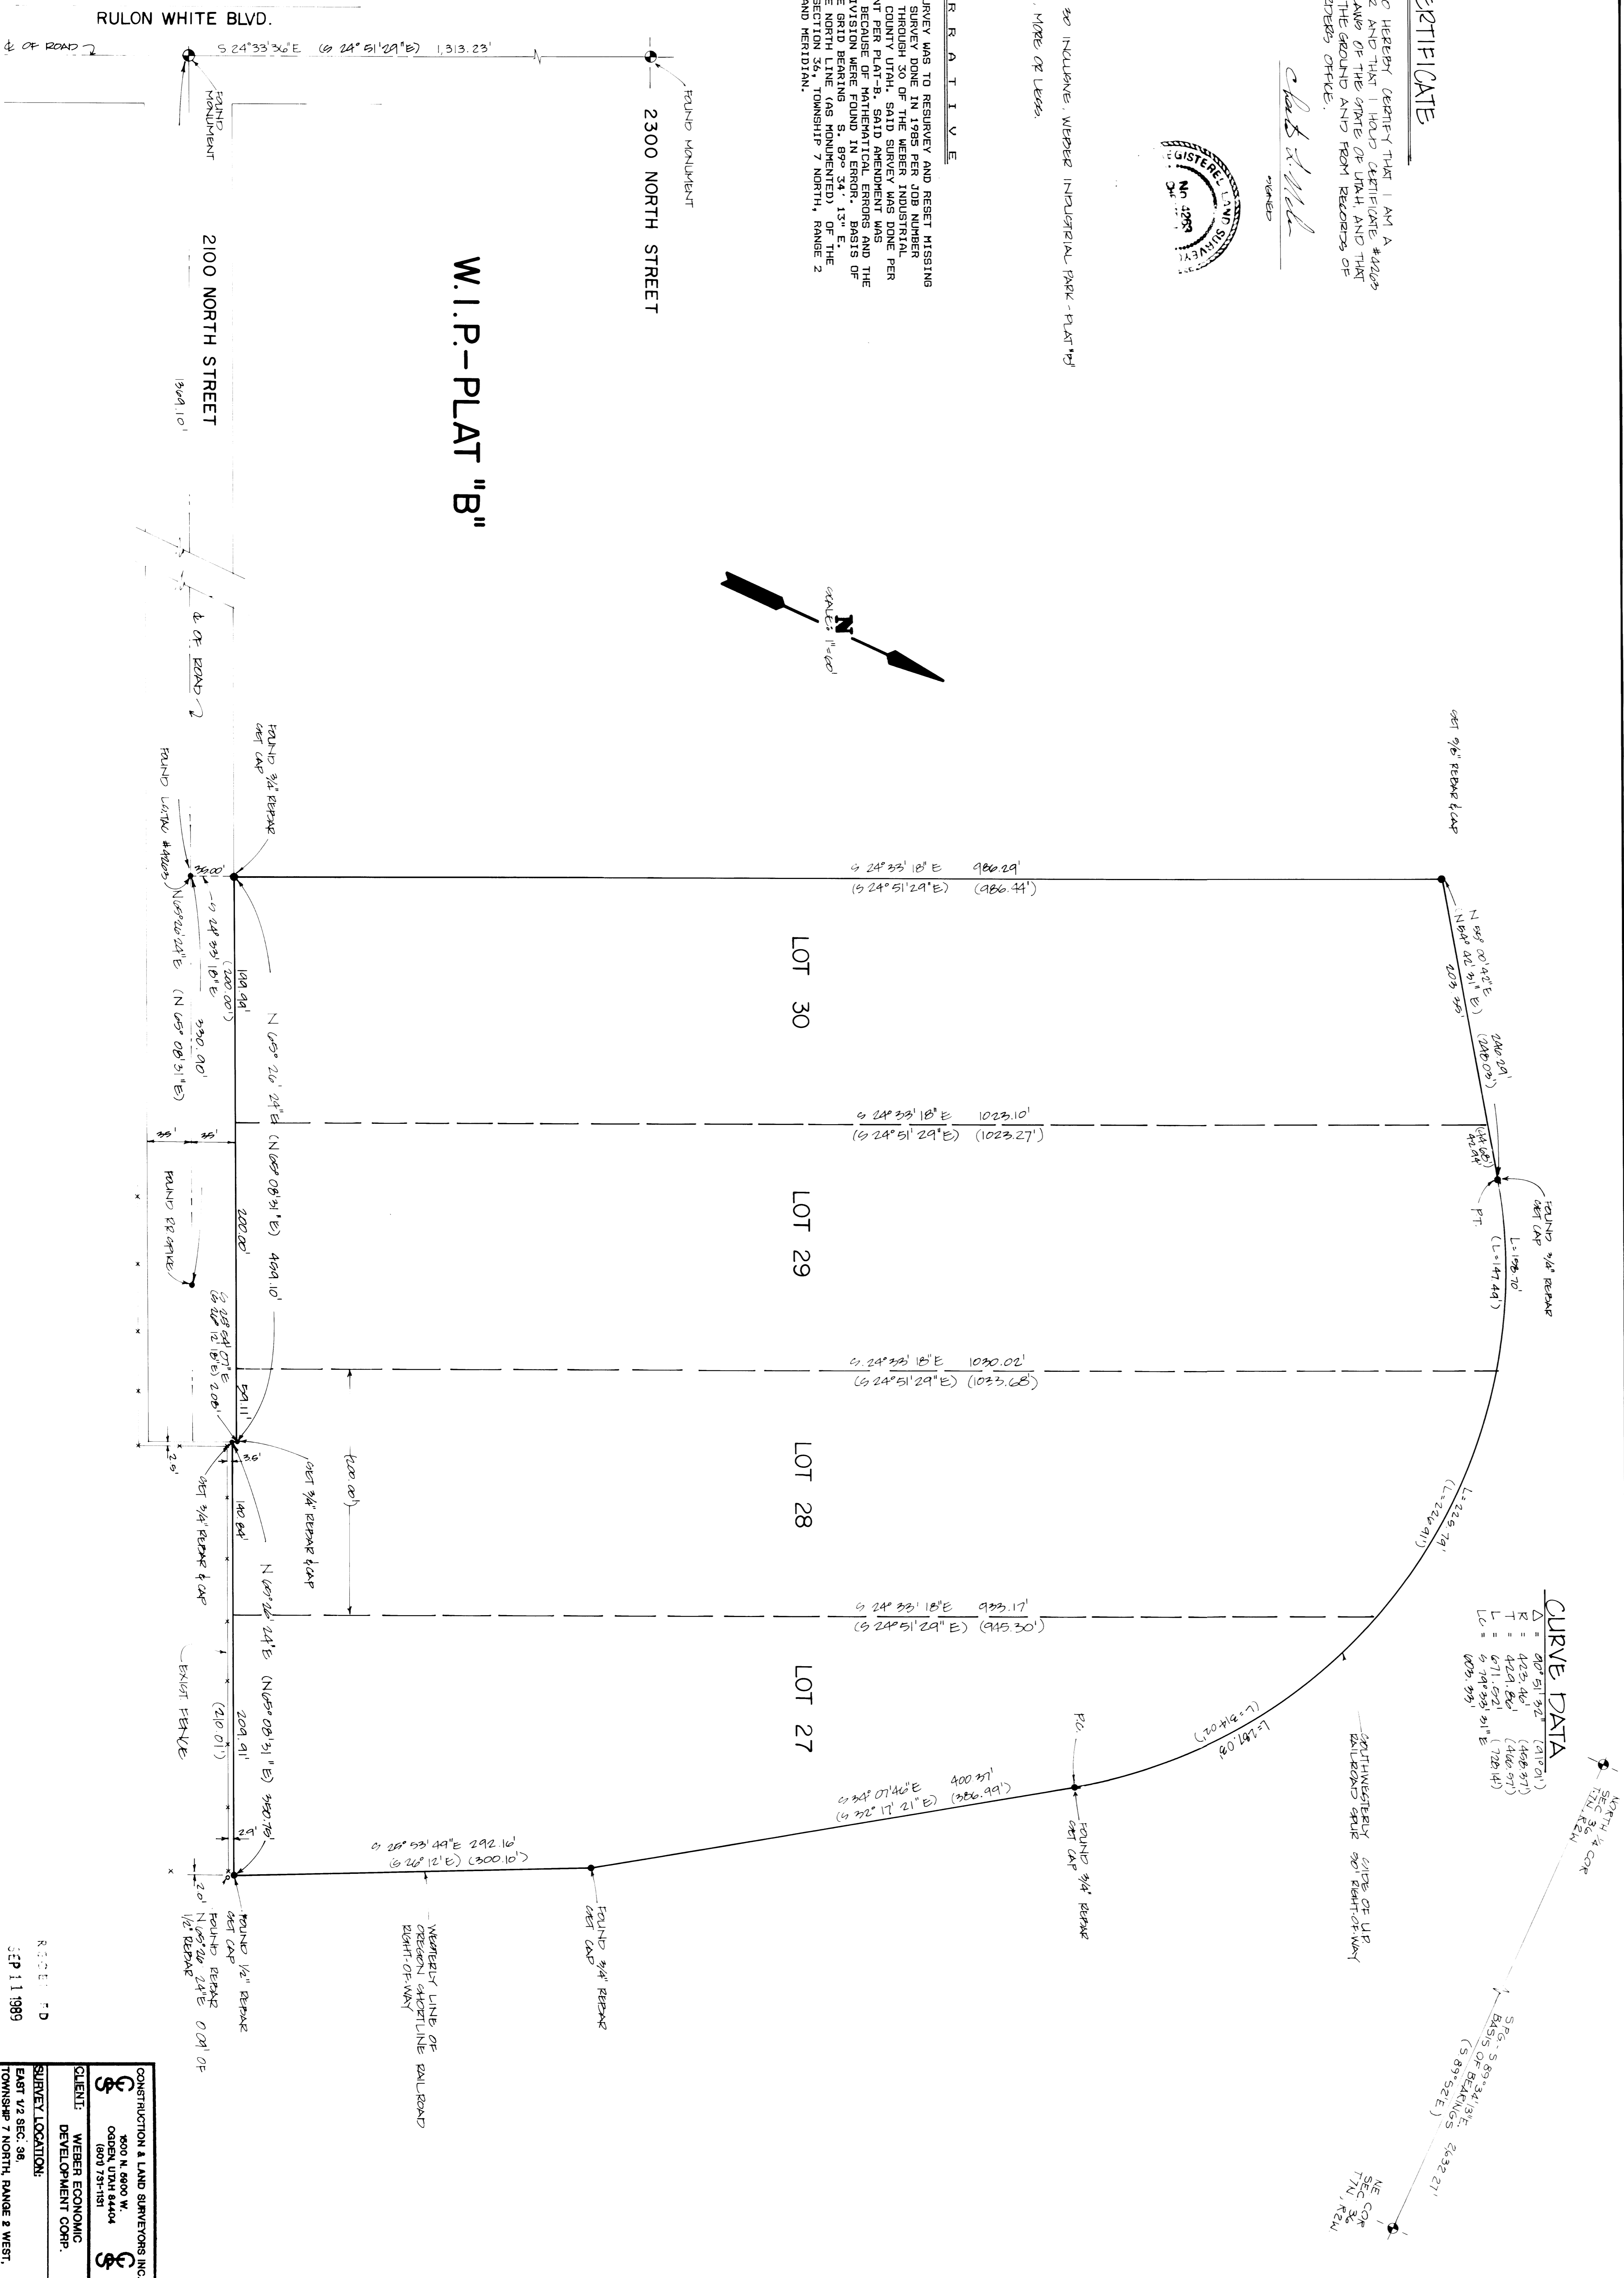


